


POLE AND EQUIPMENT SCHEDULE												
POLE No.	TYPE OF POLE	VEHICLE SIGNAL					PEDESTRIAN SIGNAL				ITS DEVICE	REMARKS
		No.	TYPE	MOUNTING	VISORS	LOUVERS/BP	No.	TYPE	MOUNTING	BUTTON		
①	15' MAST ARM	24 146 161	3S12" 3S8"BIKE 3S8"BIKE	MAC SV-2-T (DETAIL A)	T T T	HORIZ-G/BP	88	1S-COUNT	SP-1 (24")			MOUNT @8': 146, 161
②	1-A (7')						818	1S-COUNT	TP-1	APS-3W		
③	1-A (7')						828	1S-COUNT	TP-1	APS-3W		
④	1-A (13')	25 142 165	3S12" 3S8"BIKE 3S8"BIKE	TV-1-T SV-2-T (DETAIL B)	T T T		838	1S-COUNT	SP-1 (18")			MOUNT @8': 142, 165
⑤	MUNI W/ 15' MAST ARM, DUAL DECORATIVE LUMINAIRE, DUAL SPOTLIGHTS	27 131A	3S12" 2S12"LB	MAC SV-1	T T	HORIZ-G/BP BP	87 89 157	1S-COUNT 1S-COUNT 1S 16"X16"	SP-3 (CUSTOM)			MOUNT @13': 131A
⑥	1-A (7')						817 819 1517	1S-COUNT 1S-COUNT 1S 16"X16"	TP-3-TA	APS-3W		
⑦	1-A (7')						827 829 1527	1S-COUNT 1S-COUNT 1S 16"X16"	TP-3-TA	APS-3W		
⑧	MUNI W/ DUAL DECORATIVE LUMINAIRE, DUAL SPOTLIGHTS	26 135A	3S12" 2S12"LB	SV-1-T SV-1	T T		837 839 1537	1S-COUNT 1S-COUNT 1S 16"X16"	SP-3 (CUSTOM)		NETWORK RADIO CCTV	MOUNT @13': 135A
⑨	MUNI W/ DUAL DECORATIVE LUMINAIRE	135B	2S12"LB	SV-1	T		80 150	1S-COUNT 1S 16"X16"	SP-2 (CUSTOM)			MOUNT @13': 135B
⑩	1-A (7')						810 1510	1S-COUNT 1S 16"X16"	TP-2-T	APS-3W		
⑪	1-A (7')						820 1520	1S-COUNT 1S 16"X16"	TP-2-T	APS-3W		
⑫	MUNI W/ DUAL DECORATIVE LUMINAIRE	131B	2S12"LB	SV-1	T		830 1530	1S-COUNT 1S 16"X16"	SP-2 (CUSTOM)			MOUNT @13': 131B

- SHEET NOTES:**
- ① JOINT PULL BOX WITH MUNI VETAG SYSTEM.
 - ② PULL BOXES ON FERRY BUILDING PLAZA USE DECORATIVE METAL LIDS.

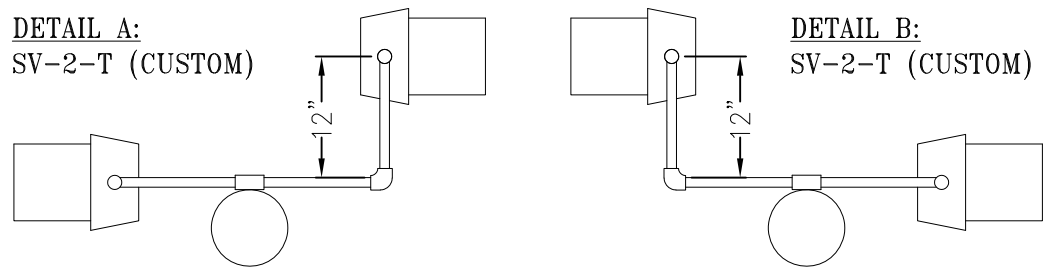

NO.	DATE	DESCRIPTION	BY	APPROVED
0	2/9/24	CONVERT MSID. UPDATE PER FIELD.	E. LUU	G. DELEON

TABLE OF REVISIONS
CHECKOUT DRAWING THROUGH THE SID CUSTODIAN FOR THE LATEST REVISION



DRAWN BY: E. LUU	DATE: 2/2024
CHECKED BY: G. DE LEON	DATE: 2/2024

SCALE AS SHOWN
SHEET OF SHEETS 1 OF 1

TRAFFIC SIGNAL INVENTORY DIAGRAM
EMBARCADERO MIDBLOCK FERRY BUILDING, NORTHBOUND

CNN NO: 12553201
REV NO: 0