


PIER 23

EMBARCADERO

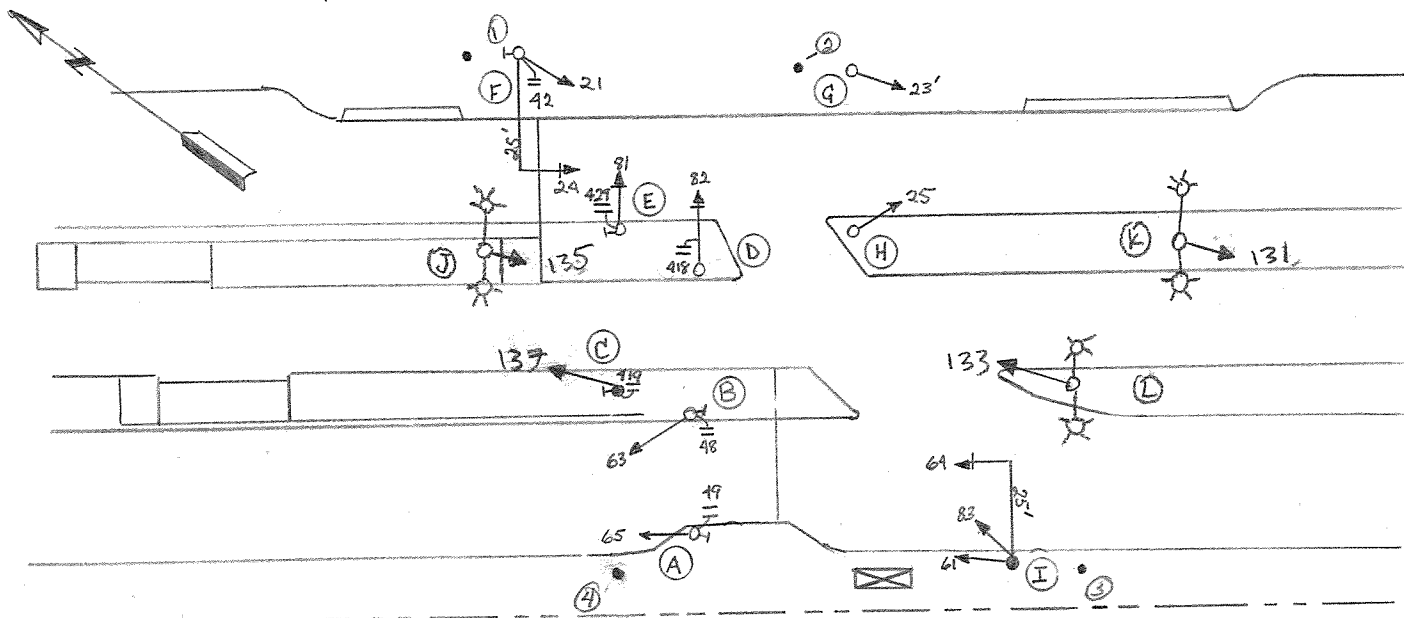

2/26/17

THE EMBARCADERO AND

@ Pier 23

POLE	FUNC	MAT'L	SIGNAL NO	MAKE	NO. OF SECT.	SIZE	VISOR	BP OR LOUVER	MOUNTING	PED SIGNAL NO.	LEGEND	ELEMENT	COLOR	MAKE	MOUNTING
A	S	S	21	TCT	3	8"RYG	FC-8"	NO	S	42	I	1S-1	W/OR	ICC	S
B	S	S	23	TCT	3	8"RYG	FC-8"	NO	S	48*	I	1S-1	W/OR	ICC	S
C	S	S	24	TCT	3	12"RYG	T-12"	BP	A	49	I	1S-1	W/OR	ICC	S
D	S	S	25	TCT	3	8"RYG	FC-8"	NO	T	418	I	1S-1	W/OR	ICC	S
E	S	S	61	TCT	3	8"RYG	FC-8"	NO	S	419	I	1S-1	W/OR	ICC	S
F	S	S	63	TCT	3	8"RYG	T-8"	NO	T	429*	I	1S-1	W/OR	ICC	S
G	S	S	64	TCT	3	12"RYG	T-12"	BP	A						
H	S	S	65	TCT	3	8"RYG	T-8"	NO	T						
I	S	S	81	TCT	3	12"RYG	T-12"	BP	T						
			82	TCT	3	12"RYG	T-12"	BP	T						
1	L	S	83	TCT	3	8"RYG	FC-8"	NO	S						
2	L	S	131	TCT	2	12"LB	T-12"	NO	S						
3	L	S	133	TCT	2	12"LB	T-12"	NO	S						
4	L	S	135	TCT	2	12"LB	T-12"	NO	S						
			137	TCT	2	12"LB	T-12"	NO	S						
J	M	S													
K	M	S													
L	M	S													

RELOCATED TRANSIT SIGNALS

T = TUNNEL

* = 2 Ped Heads

2-11 355 -A 1.A.M