


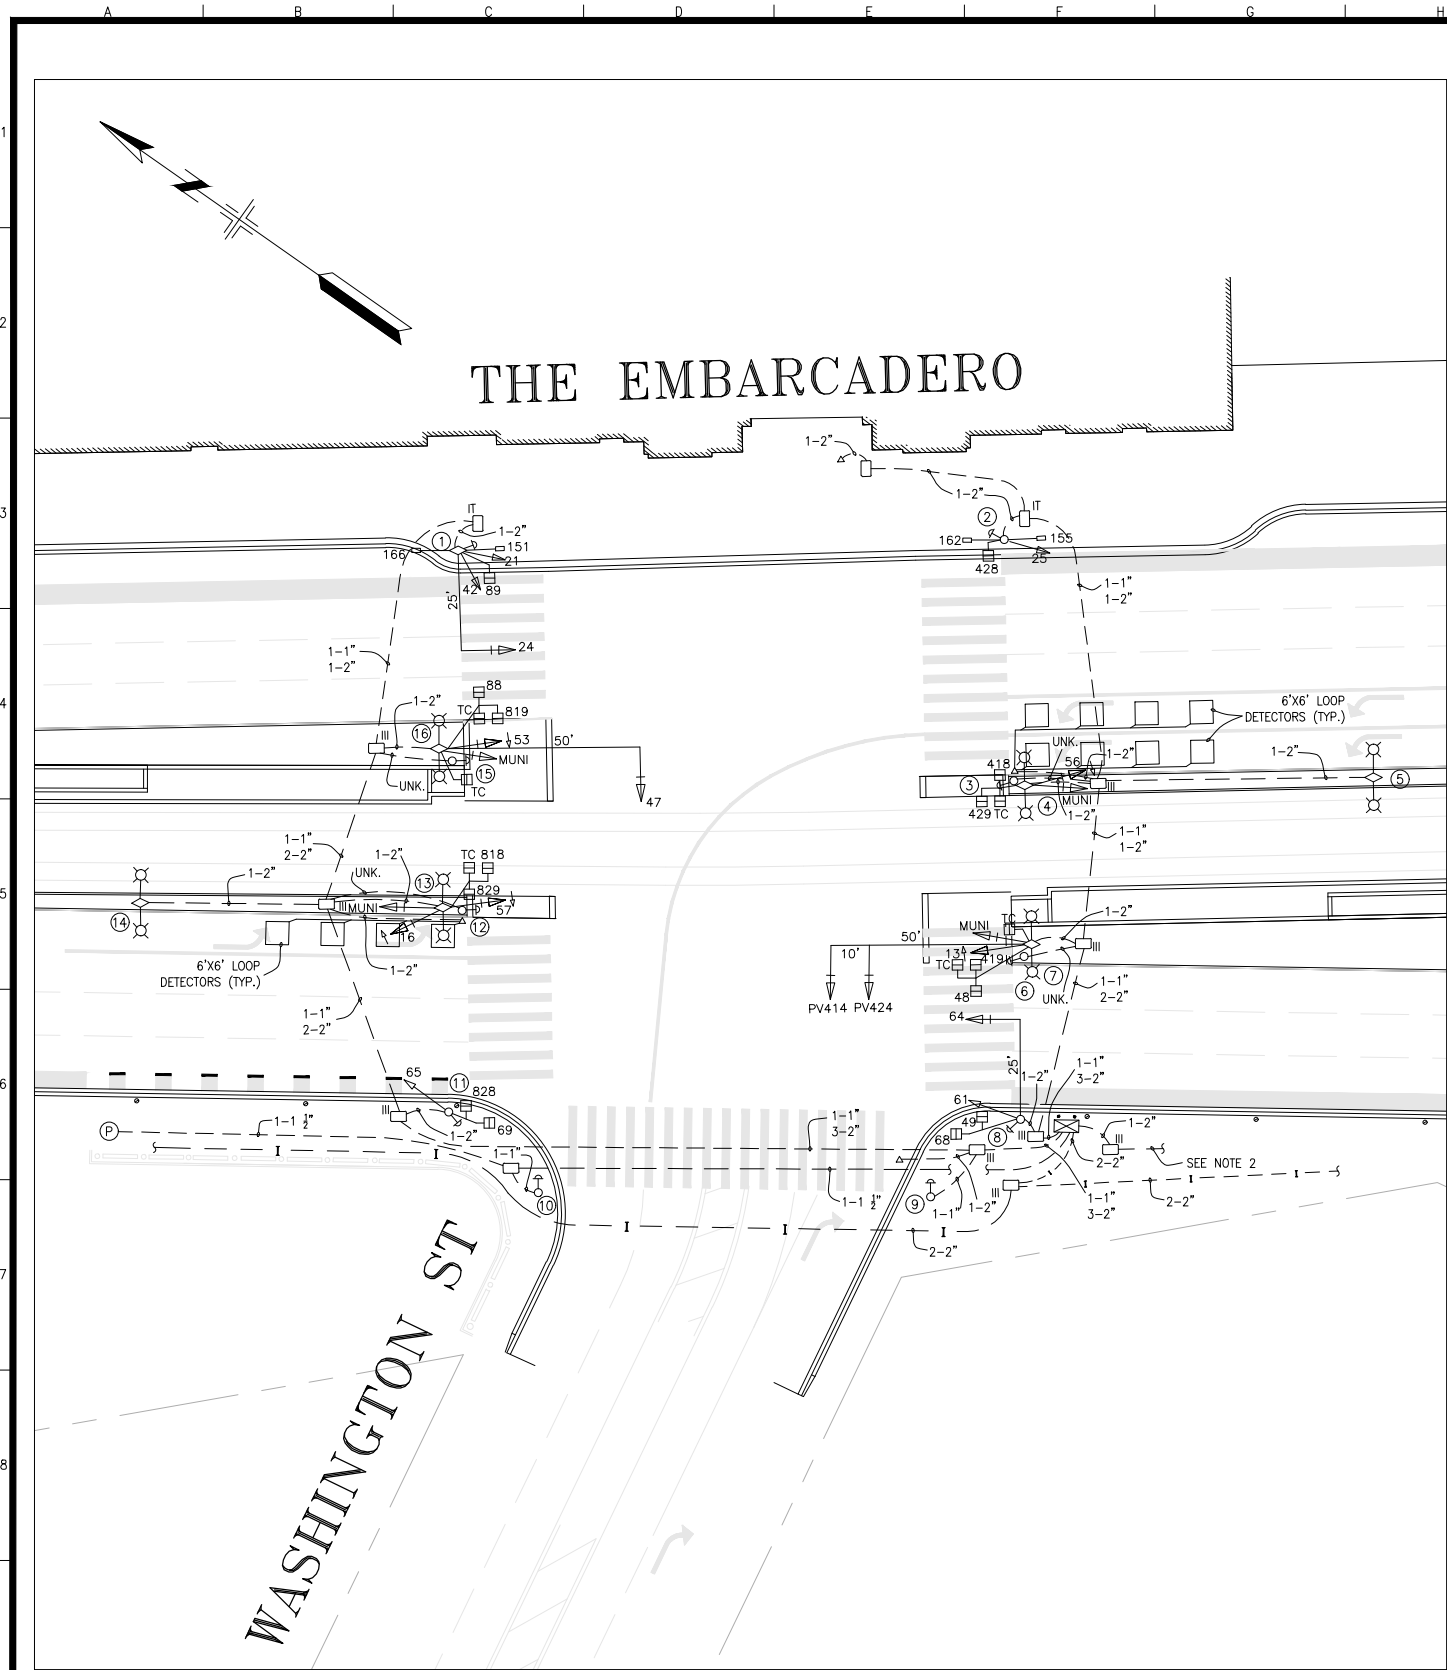

NOTES:
1. CABINET FOUNDATION TYPE: M
2. TO VETAG CABINET - SEE SPECIFICATION NO. 6094Q, SHEET TE-12 FOR FURTHER DETAILS
3. TC = TRAIN COMING

POLE AND EQUIPMENT SCHEDULE										
POLE No.	TYPE OF POLE	VEHICLE SIGNAL					PEDESTRIAN SIGNAL			REMARKS
		No.	TYPE	MOUNTING	VISORS	LOUVERS	No.	TYPE	MOUNTING	
①	18-1-70 WITH 25' MAST ARM	24 21 42 151 166	3S12" 3S12" 3S12" 3S8" BIKE 3S8" BIKE	MAS SV-2-TC @11.5' SV-2-T* @8'	T T T T T		89	1S-COUNT	② -	APS BACKPLATE *CUSTOM SV-2-T PER FIGURE 1. 151 IN POSITION A
②	1-A (12')	25 155 162	3S12" 3S8" BIKE 3S8" BIKE	TV-1-T SV-2-T* @8'	T T T		428	1S-COUNT	② -	APS *CUSTOM SV-2-T PER FIGURE 2. 162 IN POSITION A
③	APS POLE									APS
④	COMBINATION POLE (POLE #274)	56 MUNI	3S12" LA 2S12" LB	SV-1 SV-1	T T		418 429 TC	1S-COUNT 1S-COUNT 1S 16"x16"	③ -	BACKPLATE BACKPLATE
⑤	COMBINATION POLE (POLE #276)									NOT USED
⑥	APS POLE									APS
⑦	COMBINATION POLE (POLE #275) WITH 50' MAST ARM	13 MUNI PV414 PV424	3S12" LA 2S12" LB 3S12" PV 3S12" PV	SV-1 SV-1 MAS MAS	T T T T		48 419 TC TC	1S-COUNT 1S-COUNT 1S 16"x16" 1S 24"x24"	③ - SP-1	BACKPLATE BACKPLATE BACKPLATE
⑧	18-1-70 WITH 25' MAST ARM	61 64	3S8" 3S12"	SV-1 MAS	T T		49 68	1S-COUNT 1S-COUNT	① -	BACKPLATE, APS
⑨	APS POLE									APS
⑩	APS POLE									APS
⑪	1-A (12')	65	3S8"	TV-1	T		69 828	1S-COUNT 1S-COUNT	① -	APS
⑫	APS POLE									APS
⑬	COMBINATION POLE (POLE #273)	16 57 MUNI	3S12" LA 3S12" LA 2S12" LB	SV-1 SV-1 SV-1	T T T		818 829 TC	1S-COUNT 1S-COUNT 1S 16"x16"	③ -	BACKPLATE BACKPLATE
⑭	COMBINATION POLE (POLE #271)									NOT USED
⑮	APS POLE									APS
⑯	COMBINATION POLE (POLE #272) WITH 50' MAST ARM	47 53 MUNI	3S12" 3S12" LA 2S12" LB	MAS SV-1 SV-1	T T T		88 819 TC TC	1S-COUNT 1S-COUNT 1S 16"x16" 1S 24"x24"	③ - SP-1	BACKPLATE BACKPLATE

Figure 1:


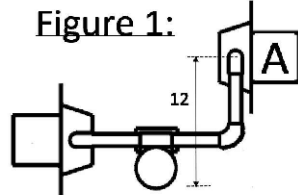


Figure 2:

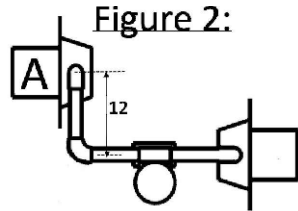

DETAIL
SCALE : NONE

DETAIL
SCALE : NONE

DETAIL
SCALE : NONE

NO.	DATE	DESCRIPTION	BY	APPROVED
10	3/1/22	SRC 2021-300: ADD SIGNALS 151, 155, 162, 166. UPDATE 21, 25, 42 TO 3S12".	J. Suhaimi	G. Ho
9	2/16/20	SRC 2019-255: UPGRADED 24"x24" TC ON POLES 7 & 16	CXL	CL
8	8/17	PER FIELD: RELOCATED APS TO NEW APS POLES ON MEDIAN ISLANDS	TY	MV
7	2/5/17	SRC 2016-352: RELOCATED 2S12" BAR SIGNALS	AL	RSZ
6	9/14/14	SRC 2014-151: REPLACED 2S8" WITH 2S12" BAR SIGNALS	BW	CW
5	3/9/11	SRC 2010-154: NEW M-SF CABINET	TY	RO

TABLE OF REVISIONS
CHECKOUT DRAWING THROUGH THE SID CUSTODIAN FOR THE LATEST REVISION



SFMTA

DRAWN BY:	DATE:
T. Young	07/2019
CHECKED BY:	DATE:
M. Velasco	07/2019

SCALE
1" = 25'
SHEET OF SHEETS
1 OF 1

TRAFFIC SIGNAL INVENTORY DIAGRAM
THE EMBARCADERO & WASHINGTON STREET

CNN NO:	24572000
REV NO:	10