


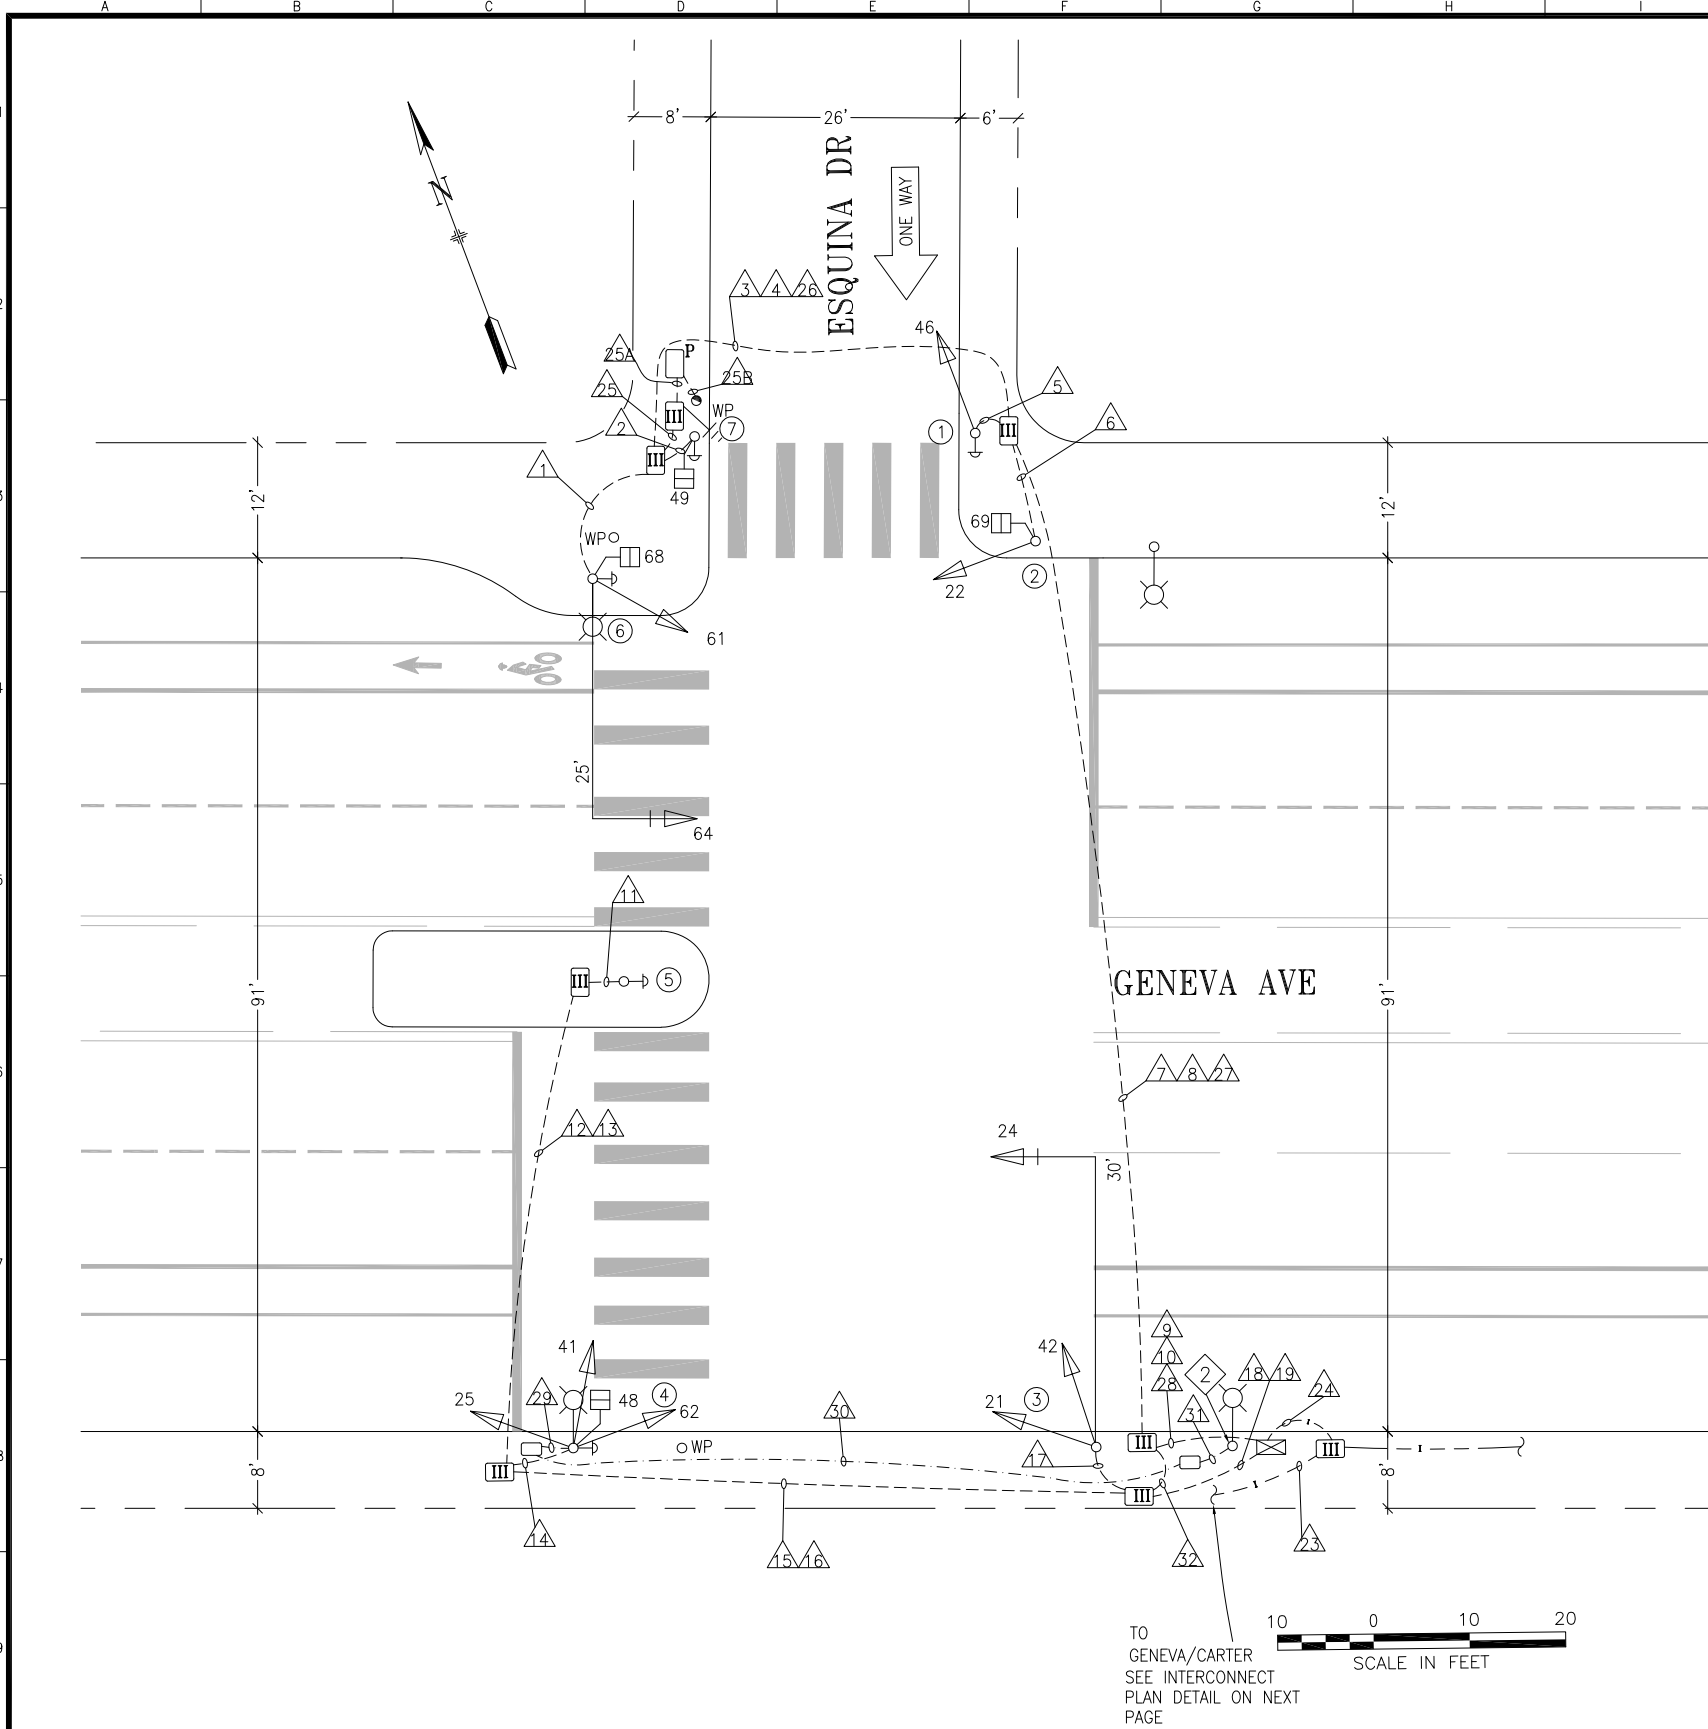

POLE AND EQUIPMENT SCHEDULE											
POLE No.	TYPE OF POLE	LUMINAIRE VOLTAGE/ WATTAGE	VEHICLE SIGNAL					PEDESTRIAN SIGNAL			REMARKS
			No.	TYPE	MOUNTING	VISORS	LOUVERS	No.	TYPE	MOUNTING	
①	1-A (10')		46	3S12"	TV-1-T	T					APS 2-W
②	1-A (10')		22	3S12"	TV-1-T	T		69	1S-COUNT	SP-1	
③	18-2-100 W/ 30' MAST ARM		21 42 24	3S12" 3S12" 3S12"	SV-2-TC MAS	T T T					MOUNT 21 & 42 AT 14' BACKPLATE TSP EQUIPMENT ①
④	CITY STD SL W/ 6' LUMINAIRE	LED 139 W	25 41 62	3S12" 3S12" 3S12"	SV-3-TA	T T T		48	1S-COUNT	SP-1	MOUNT 25, 41 AT 13' APS 2-W
⑤	PPBP										APS 2-W
⑥	19-2-100 W/ 25' MAST ARM, 6' LUMINAIRE	LED 139 W	61 64	3S12" 3S12"	SV-1-T MAS	T T		68	1S-COUNT	SP-1	APS-2W BACKPLATE
⑦	1-A (7')							49	1S-COUNT	TP-1	APS 2-W

SHEET NOTES:

- ① SPECIAL OFFSET FOUNDATION OVER EXISTING SEWER. SEE AS-BUILT DRAWINGS FOR DETAILS
- ② STREETLIGHT FOUNDATION WAS CHIPPED TO BRING NEW CONDUIT INTO POLE BASE

1	9/29/20	INSTALL TSP EQUIPMENT ON POLE 3 PER SRC 2020-237	ETang	BTanner	
0	3/14/19	SIGNAL UPGRADE BY 2774J, CONVERTED FROM CT PLN/AS-BLT	DYeung	GdeLeon	
NO.	DATE	DESCRIPTION	BY	APP.	

TABLE OF REVISIONS
CHECK WITH TRACING TO SEE IF YOU HAVE LATEST REVISION

REFERENCE INFORMATION
& FILE NO. OF SURVEYS



SAN FRANCISCO MUNICIPAL TRANSPORTATION AGENCY
CITY AND COUNTY OF SAN FRANCISCO

DRAWN: DYeung
CHECKED: GdeLeon

DATE: 3/2020
DATE: 3/2020

SCALE:
AS SHOWN

SHEET OF SHEETS
1 OF 2

TRAFFIC SIGNAL INVENTORY DIAGRAM

ESQUINA DRIVE AND GENEVA AVENUE

CNN NO.
20427000

REV NO.
1

[illegible]