

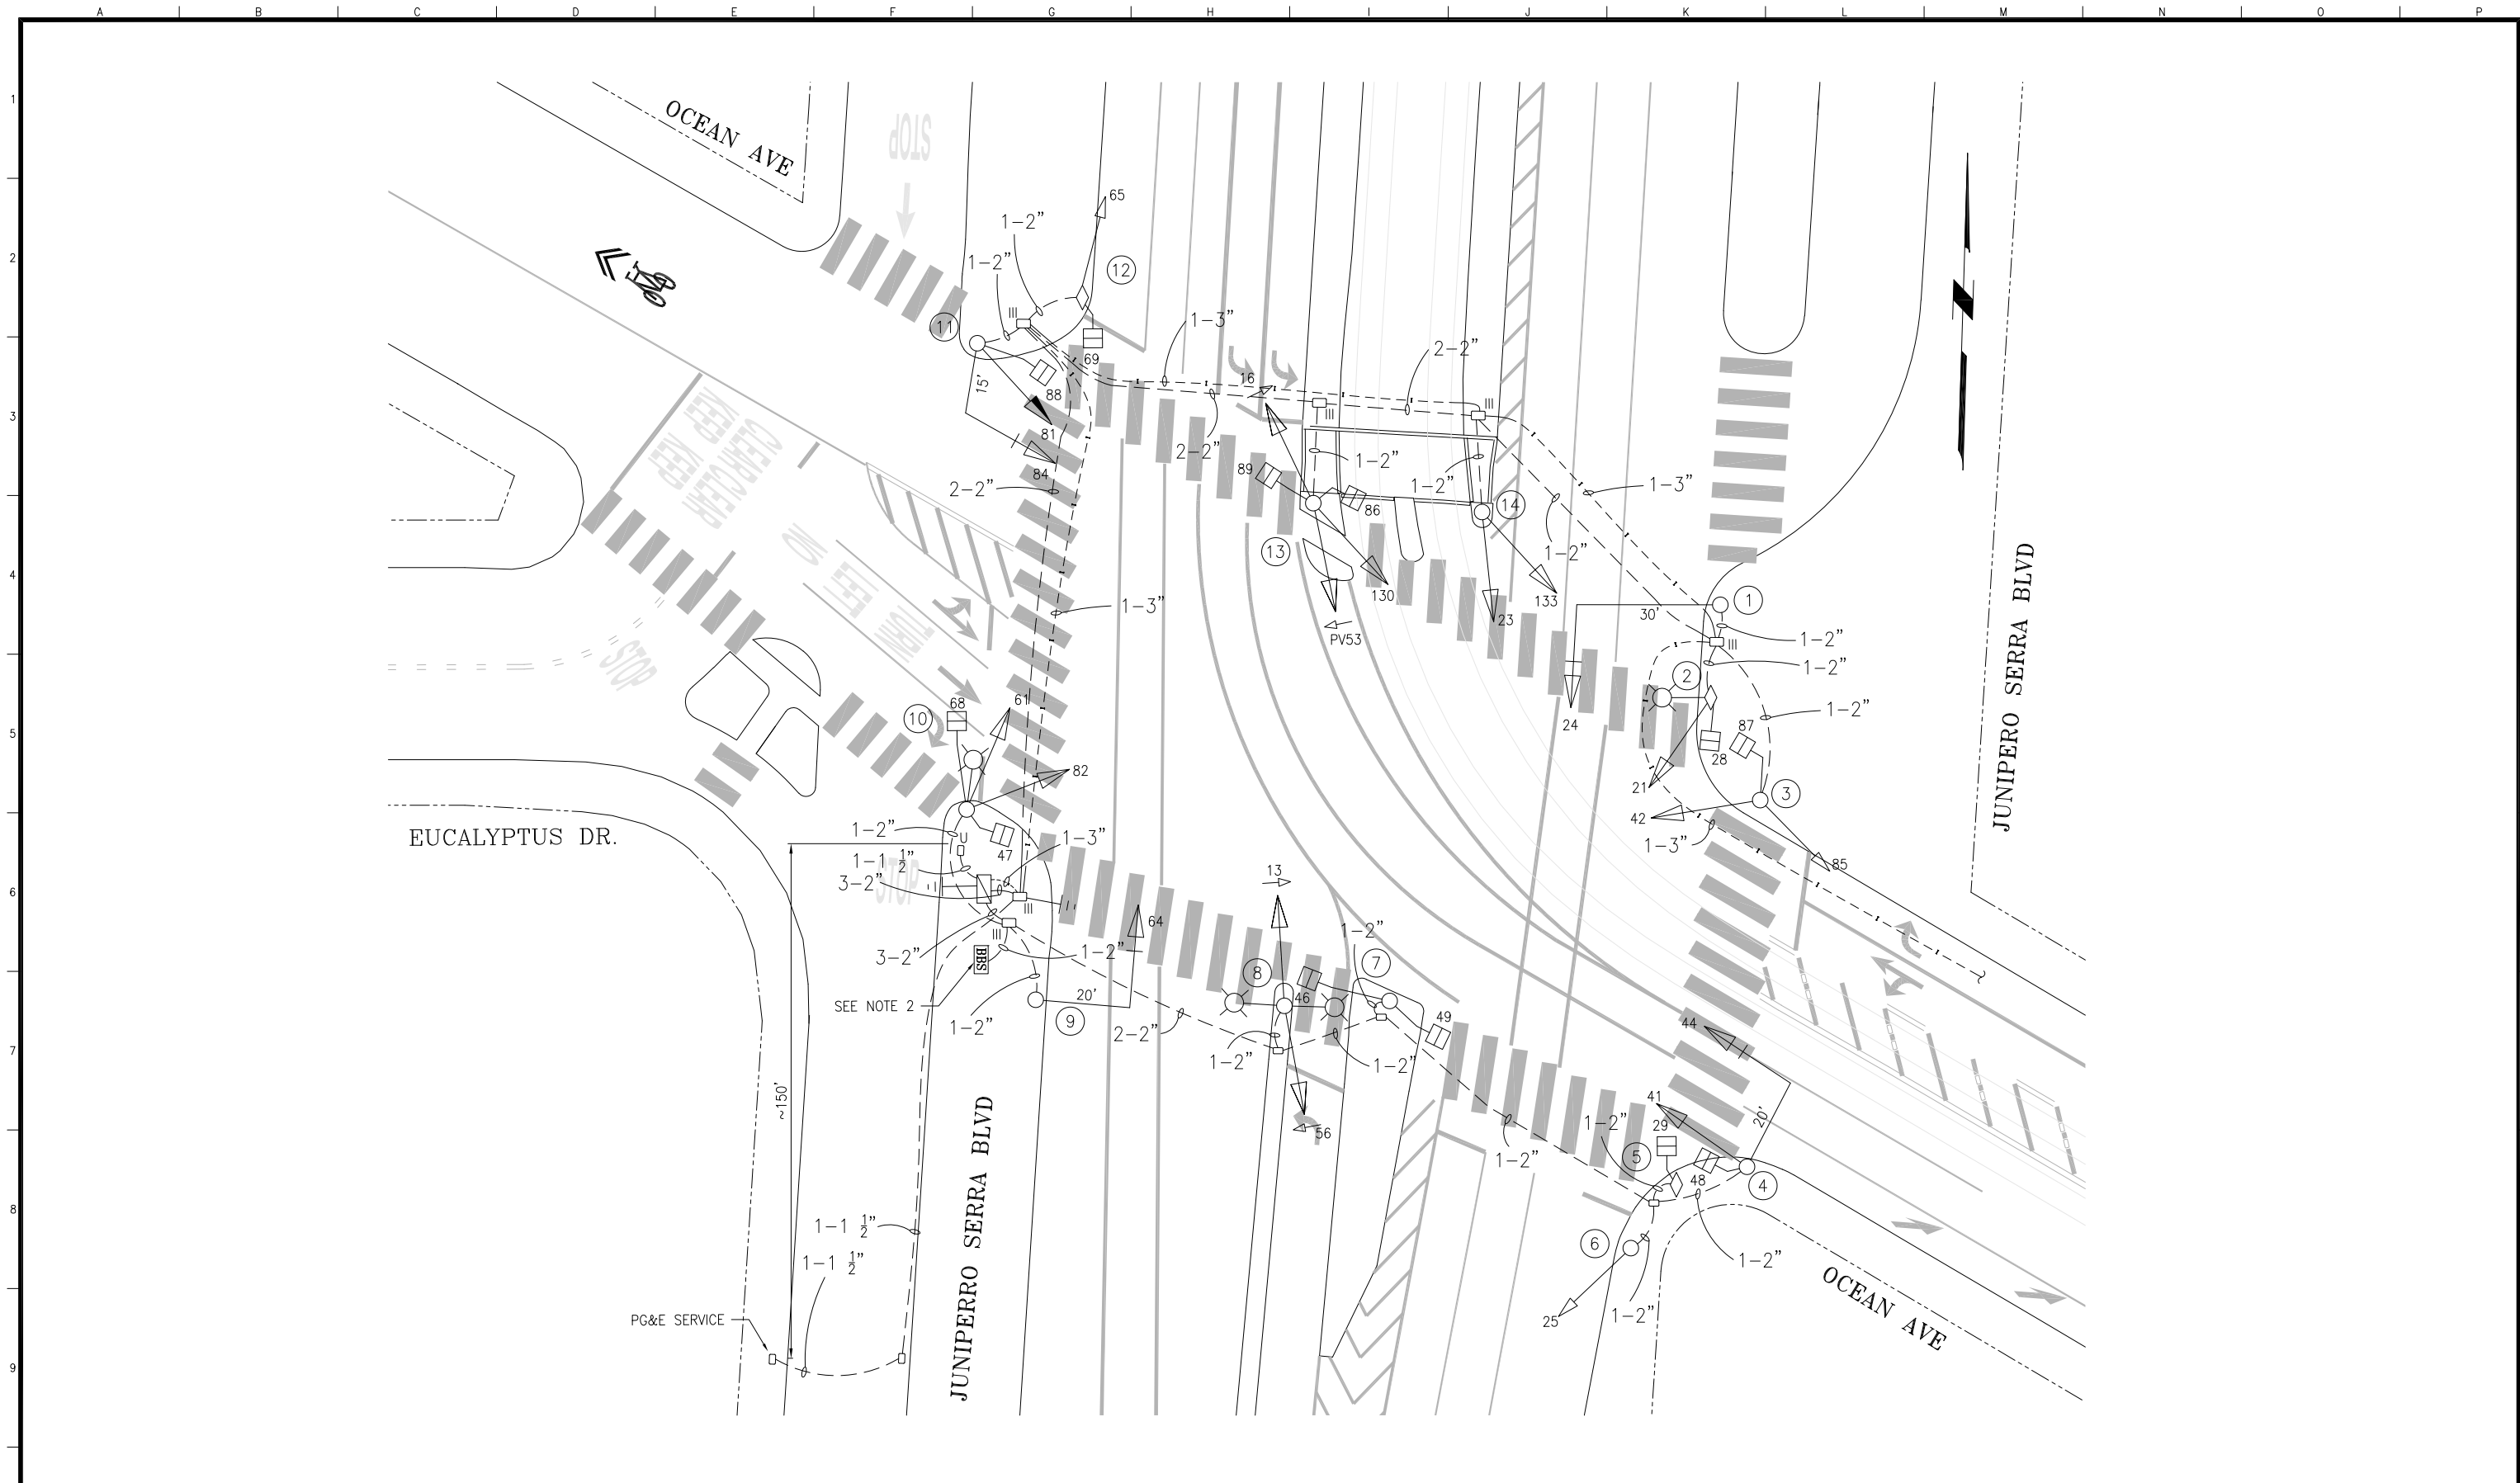


TABLE OF REVISIONS		CHECK WITH TRACING TO SEE IF YOU HAVE LATEST REVISION	
NO.	DATE	DESCRIPTION	BY
4	7/14/20	SRC 2019-389: UPGRADED SIGNALS 130/133 TO 2512" LB	TY
3	11/9/14	SRC 2014-242: REPLACED GREEN X WITH BAR SIGNALS	BW
2	6/14/05	SRC 2005-075: ACTIVATED BBS	TY
1	7/29/03	SRC 2003-071: INSTALLED PEDESTRIAN COUNTDOWN SIGNALS	MG
0	2/27/03	SIGNAL UPGRADE, CONVERTED FROM MR-1130 CONTRACT PLANS	TY

REFERENCE INFORMATION & FILE NO. OF SURVEYS	
CONTRACT MR-1130 DRAWINGS ET-3, ET-4, AND ET-34	



SAN FRANCISCO MUNICIPAL TRANSPORTATION AGENCY
CITY AND COUNTY OF SAN FRANCISCO

DRAWN:	DATE:
TY	7/2020
CHECKED:	DATE:
MV	7/2020

SCALE:
1 : 200
SHEET OF SHEETS
1 OF 2

TRAFFIC SIGNAL INVENTORY DIAGRAM
EUCALYPTUS DRIVE, JUNIPERO SERRA BLVD & OCEAN AVENUE

CNN NO.
23070000
REV NO.
4

	A	B	C	D	E	F	G	H	I	J	K	L	M	N	O	P
1																
2																
3																
4																
5																
6																
7																
8																
9																

POLE AND EQUIPMENT SCHEDULE											
POLE No.	TYPE OF POLE	LUMINAIRE (HPS)	VEHICLE SIGNAL					PEDESTRIAN SIGNAL			REMARKS
		VOLTAGE/ WATTS	No.	TYPE	MOUNTING	VISORS	LOUVERS	No.	TYPE	MOUNTING	
①	18-1-70 WITH 30' MASTARM		24	3S12"	MAS	T					BACKPLATE
②	COMBINATION POLE MUNI #177		21	3S12"	SV-1-T	T		28	1S-COUNT	SP-1	
③	1-A (10')		42 85	3S12" 3S8"	TV-2-T	T T		87	1S-COUNT	SP-1	
④	16-1-70 WITH 20' MASTARM		41 44	3S12" 3S12"	SV-1-T MAS	T T		48	1S-COUNT	SP-1	BACKPLATE
⑤	MUNI POLE #2499							29	1S-COUNT	SP-1	PEDESTRIAN SIGNAL MOUNTING CONNECTED VIA EXTERNAL CONDUIT
⑥	1-A (10')		25	3S8"	TV-1	T					
⑦	1-A (7')							46 49	1S-COUNT 1S-COUNT	TP-2-T	
⑧	STREETLIGHT POLE		13 56	3S12"LA 3S12"LA	SV-1 SV-1	T T					INSTALL @ 8' INSTALL @ 4'6"
⑨	16-1-70 WITH 20' MASTARM		64	3S12"	MAS	T					BACKPLATE
⑩	STREETLIGHT POLE		61 82	3S12" 3S12"	SV-2-TA	T T		47 68	1S-COUNT 1S-COUNT	SP-1 SP-1	
⑪	16-1-70 WITH 15' MASTARM		81 84	3S12" 3S12"	SV-1-T MAS	T T		88	1S-COUNT	SP-1	BACKPLATE
⑫	COMBINATION POLE MUNI #298		65	3S8"	SV-1-T	T		69	1S-COUNT	SP-1-T	BOTH MOUNTINGS ON POLE 12 CONNECTED VIA EXTERNAL CONDUIT
⑬	1-A (10')		16 PV53 130	3S12"LA PV3S12"LA 2S12"LB	SV-1-T TV-2-T	T T T		86 89	1S-COUNT 1S-COUNT	SP-1 SP-1	INSTALL @ 4'6"
⑭	1-A (10')		23 133	3S12"GSA 2S12"LB	TV-2-T	T T					

NOTE:
1. CABINET FOUNDATION TYPE: M
2. BBS = BATTERY BACKUP SYSTEM

						REFERENCE INFORMATION & FILE NO. OF SURVEYS			SAN FRANCISCO MUNICIPAL TRANSPORTATION AGENCY CITY AND COUNTY OF SAN FRANCISCO						SCALE: NONE		TRAFFIC SIGNAL INVENTORY DIAGRAM		CNN NO. 23070000			
4	7/14/20	SRC 2019-389: UPGRADED SIGNALS 130/133 TO 2S12" LB		TY	BT	CONTRACT MR-1130 DRAWINGS ET-3, ET-4, AND ET-34					DRAWN: DATE: TY 7/2020						SHEET OF SHEETS 2 OF 2		EUCALYPTUS DRIVE, JUNIPERO SERRA BLVD & OCEAN AVENUE		REV NO. 4	
3	11/9/14	SRC 2014-242: REPLACED GREEN X WITH BAR SIGNALS		BW	CW																	
2	6/14/05	SRC 2005-075: ACTIVATED BBS		TY	HQ																	
1	7/29/03	SRC 2003-071: INSTALLED PEDESTRIAN COUNTDOWN SIGNALS		MG	JLF																	
0	2/27/03	SIGNAL UPGRADE, CONVERTED FROM MR-1130 CONTRACT PLANS		TY	MV																	
NO.	DATE	DESCRIPTION		BY	APP.																	
TABLE OF REVISIONS CHECK WITH TRACING TO SEE IF YOU HAVE LATEST REVISION																						