


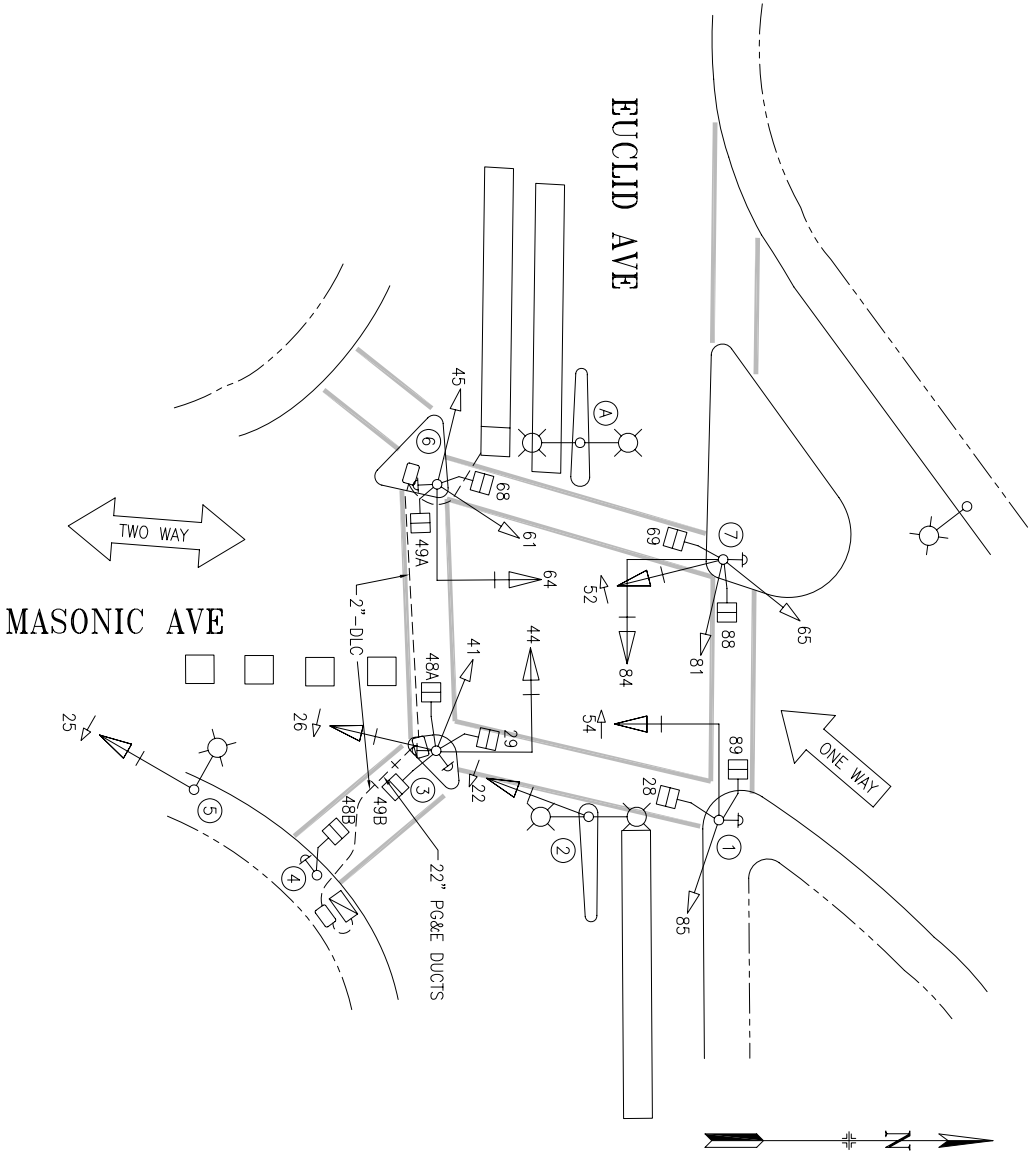

NOTE:
CABINET FOUNDATION TYPE: M

POLE AND EQUIPMENT SCHEDULE									
POLE No.	TYPE OF POLE	VEHICLE SIGNAL				PEDESTRIAN SIGNAL		REMARKS	
		No.	TYPE	MOUNTING	VISORS	LOUVERS	No.	TYPE	MOUNTING
①	MAST ARM	65 84	3S8" 3S12"-LA	SV-1-T MAS (END)	FC FC		69 88	1S-IN 1S-IN	SP-2-T BACKPLATE
②	SL	81	3S12"-RA	SV-1-T	FC				
③	MAST ARM	21 85 24	3S8" 3S12"-RA 3S12"-RA	SV-2-1A MAS (END)	FC FC FC		28A 29B 89	1S-IN 1S-IN 1S-IN	SP-3-T BACKPLATE
④	1-A (7')						28B	1S-IN	TP-1
⑤	SL	87	3S12"-RA	SV-1-T	FC				
⑥	MAST ARM	25 41 44	3S8" 3S8" 3S12"	SV-2-1A MAS (END)	T T FC		29A 48	1S-IN 1S-IN	SP-2-T BACKPLATE
⑦	MAST ARM	45 61 82 64	3S8" 3S8" 3S12"-LA 3S12"-LA	SV-3-1A MAS (END)	FC FC FC FC		49 68	1S-IN 1S-IN	SP-2-T BACKPLATE
⑧	SL								
⑨	SL								



2	09/10	RENUMBER PHASES PER FIELD CHECK			CXL	ET			
1	03/93	SIGNAL MODIFICATION C122.			CXL	BW			
NO.	DATE	DESCRIPTION			BY	APP.			

CHECK WITH TRACING TO SEE IF YOU HAVE LATEST REVISION		COMPLETION DATE / ELECTRICIAN INITIAL
---	--	--



SAN FRANCISCO MUNICIPAL TRANSPORTATION AGENCY
TRANSPORTATION ENGINEERING
CITY AND COUNTY OF SAN FRANCISCO

DRAWN:	DATE:	SCALE:
CXL	07/09/99	1" = 40'
CHECKED:	DATE:	SHEET OF SHEETS
		1 OF 1

TRAFFIC SIGNAL INVENTORY DIAGRAM		CNN NO.
EUCLID AVE & MASONIC AVE		26845000
REV. NO.		