


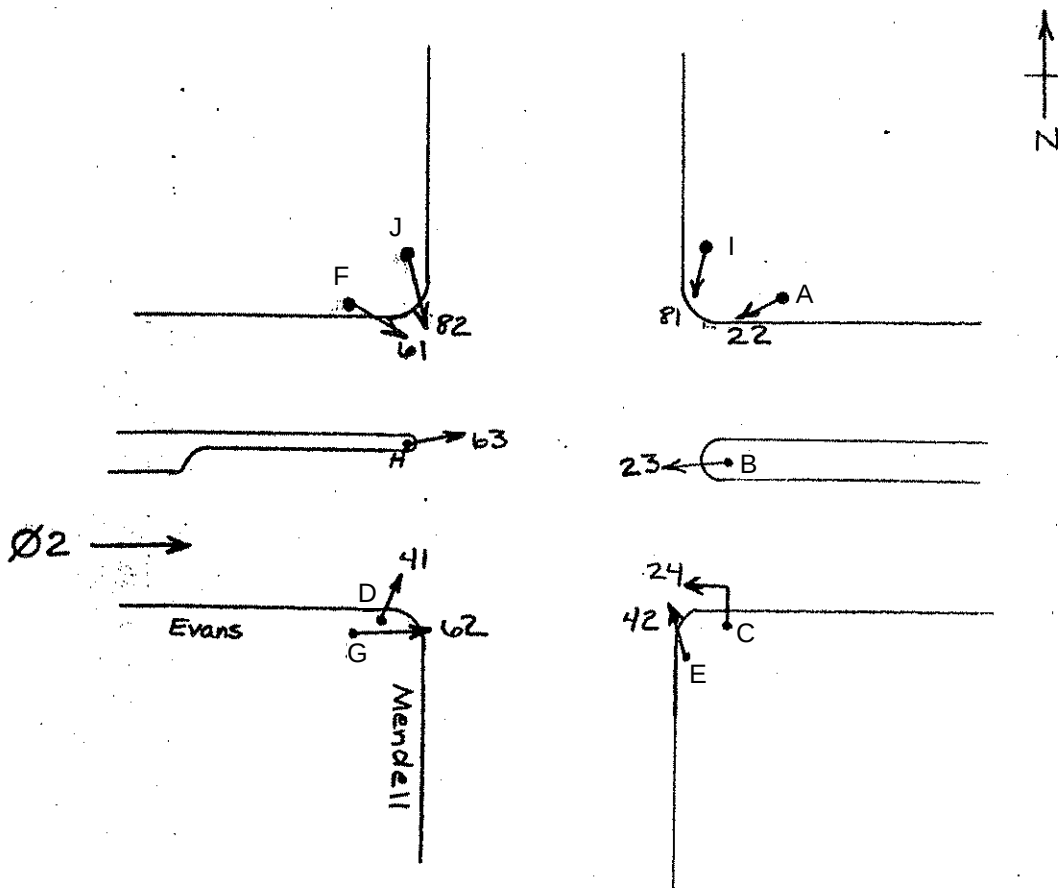

2/2/2022

POLE	FUNC.	MAT'L	SIGNAL NO.	MAKE	NO. OF SECT.	SIZE	VISOR	B.P. OR LOUVERS	MOUN'T	PED SIGNAL NO.	LEGEND	MESSAGE		MAKE	MOUN'T
												ELEMENT	COLOR		
A	S	S	22	EC	3	12"	T	-	T						
B	L	S	23	EC	3	12"	T	-	S						
C	L	S	24	EC	3	12"	T	-	A						
D	S	S	41	EC	3	12"	T	-	S						
E	L	S	42	EC	3	12"	T	-	T						
F	S	S	61	EC	3	12"	T	-	T						
G	S	S	62	EC	3	12"	T	-	T						
H	L	S	63	EC	3	12"	T	-	S						
I	L	S	81	EC	3	12"	T	-	S						
J	S	S	82	EC	3	12"	T	-	T						

CONTROLLER CABINET SIZE : _____ BASE CABINET : _____

COMMENTS :

UPDATE PER FIELD: SIGNAL 41 TO 3S12". VISORS FOR 61 AND 82 TO T.

UPDATE PER SRC 2021-302: SIGNALS 22, 42, 61, 62, 81, AND 82 TO 3S12". REPLACE ALL EXISTING FC VISORS TO T. - ECT 2/2/2022