


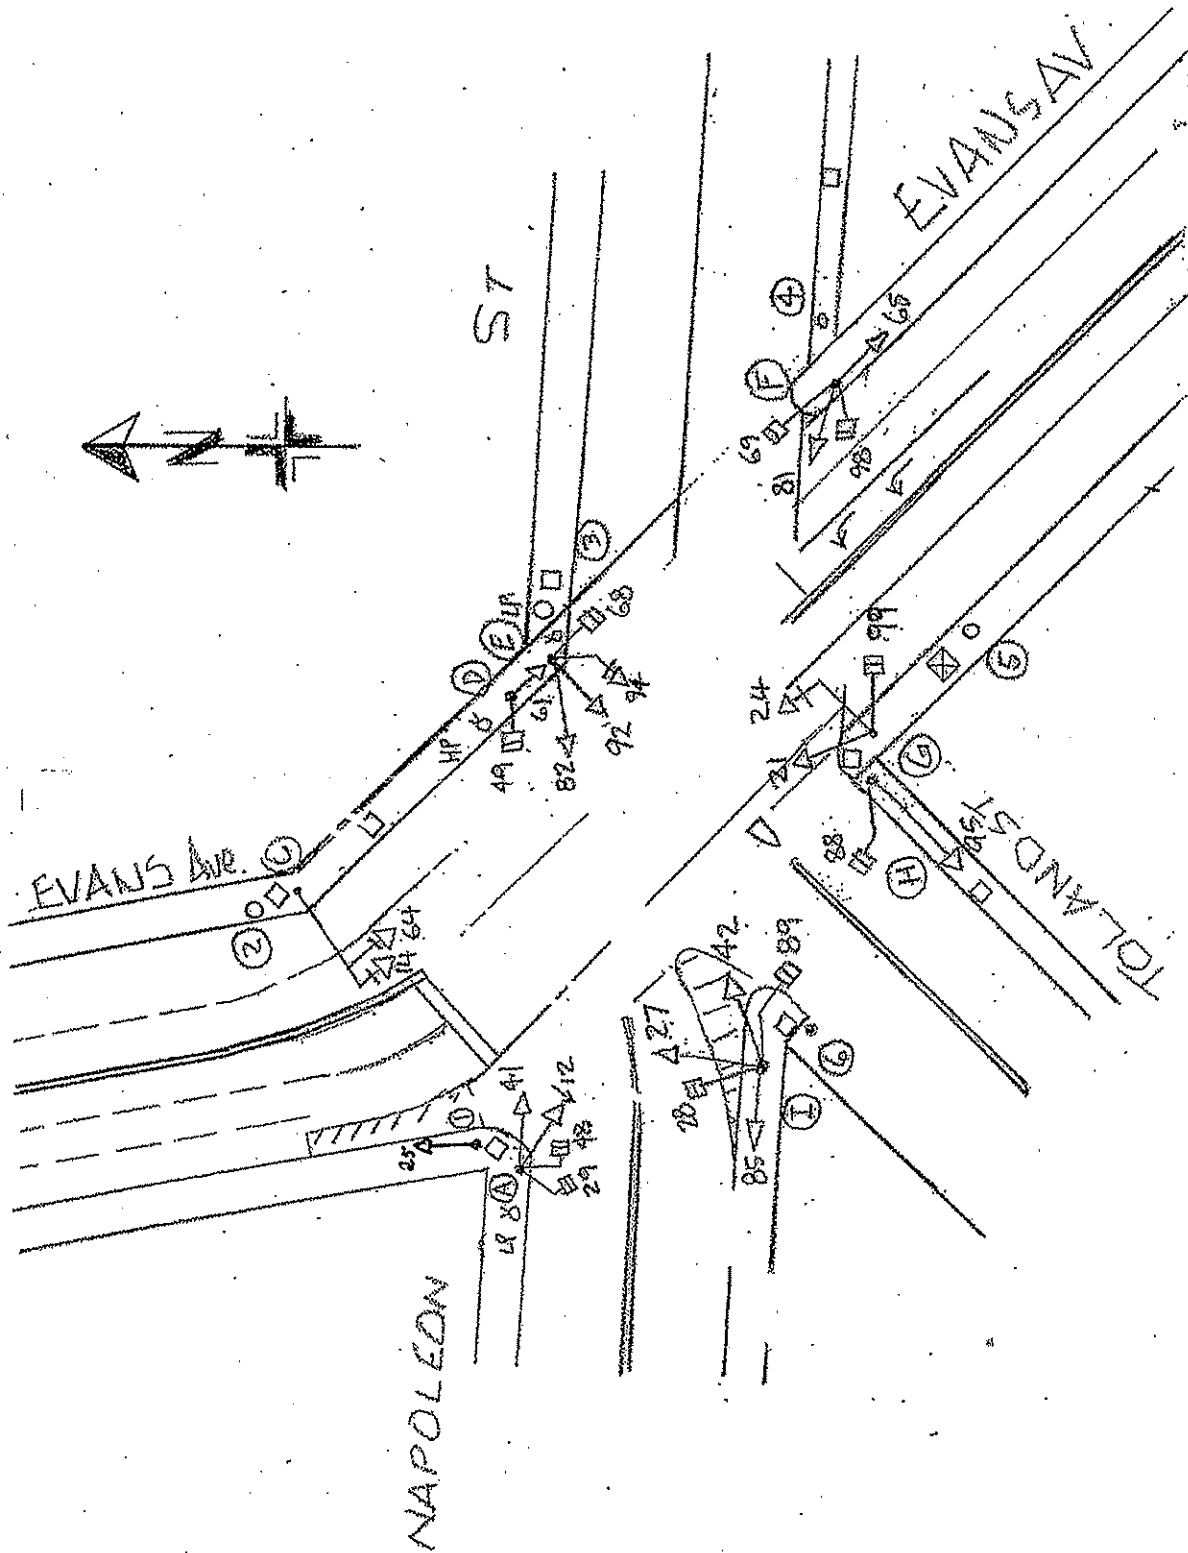

3/5/2008

EVANS, NAPOLEON, TOLAND

ET

EO TURNER

POLE FUNC.	MAT'L	VEH SIG #	MAKE	NO. of SECT.	SIZE	VISOR	B. P. OR LOUVERS	MOUNT	MESSAGE				PED. SIG. #	LEGEND	ELEMENT	COLOR	MAKE	MOUNT	PED BUTTON
A	L	S	TCT	3	12"	FC	ANGLE	S					29	I	CD	OR/W	ICC	S	PB
					12" R<														
		12	TCT	3	Y< G<	FC	LOUVERS	S					48	I	CD	OR/W	ICC	S	PB
C	L	S	TCT	3	12"	FC	B. P.	MAS											
	19-3-70-30-6-92F																		
		14	TCT	3	12" R<	FC	B. P.	MAS											
D	10-1A	S	TCT	3	12"	I	-	T					49	I	CD	OR/W	ICC	S	PB
E	L	S	TCT	3	12"	FC	LOUVERS	S					68	I	CD	OR/W	ICC	S	PB
	17B-1-70-8-6-88					FC	LOUVERS	S											
		94	TCT	3	12"	FC	B. P.	MAS											
F	L	S	TCT	3	12"	FC	-	S					69	I	CD	OR/W	ICC	S	PB
		65	TCT	3	8"	FC	-	S					98	I	CD	OR/W	ICC	S	PB
G	L	S	TCT	3	12"	FC	-	S					99	I	CD	OR/W	ICC	S	
	17-B-1-70-20-6-92																		
		24	TCT	3	12"	FC	B. P.	MAS											
H	L	S	TCT	3	8"	FC	-	S					88	I	CD	OR/W	ICC	S	PB
I	L	S	TCT	3	8"	FC	-	S					89	I	CD	OR/W	ICC	S	PB
		42	TCT	3	12"	FC	-	S					28	I	CD	OR/W	ICC	S	PB
		27	CH	3	12"	T	-	S											
1	U	W	CH	3	12"	I	-	T											
2	U	W																	
3	U	W																	
4	U	W																	
5	U	W																	
6	U	W																	

CONTROLLER CABINET SIZE: M

CONTROLLER TYPE: LMD

8000

NOTE FULLY ACTUATED