


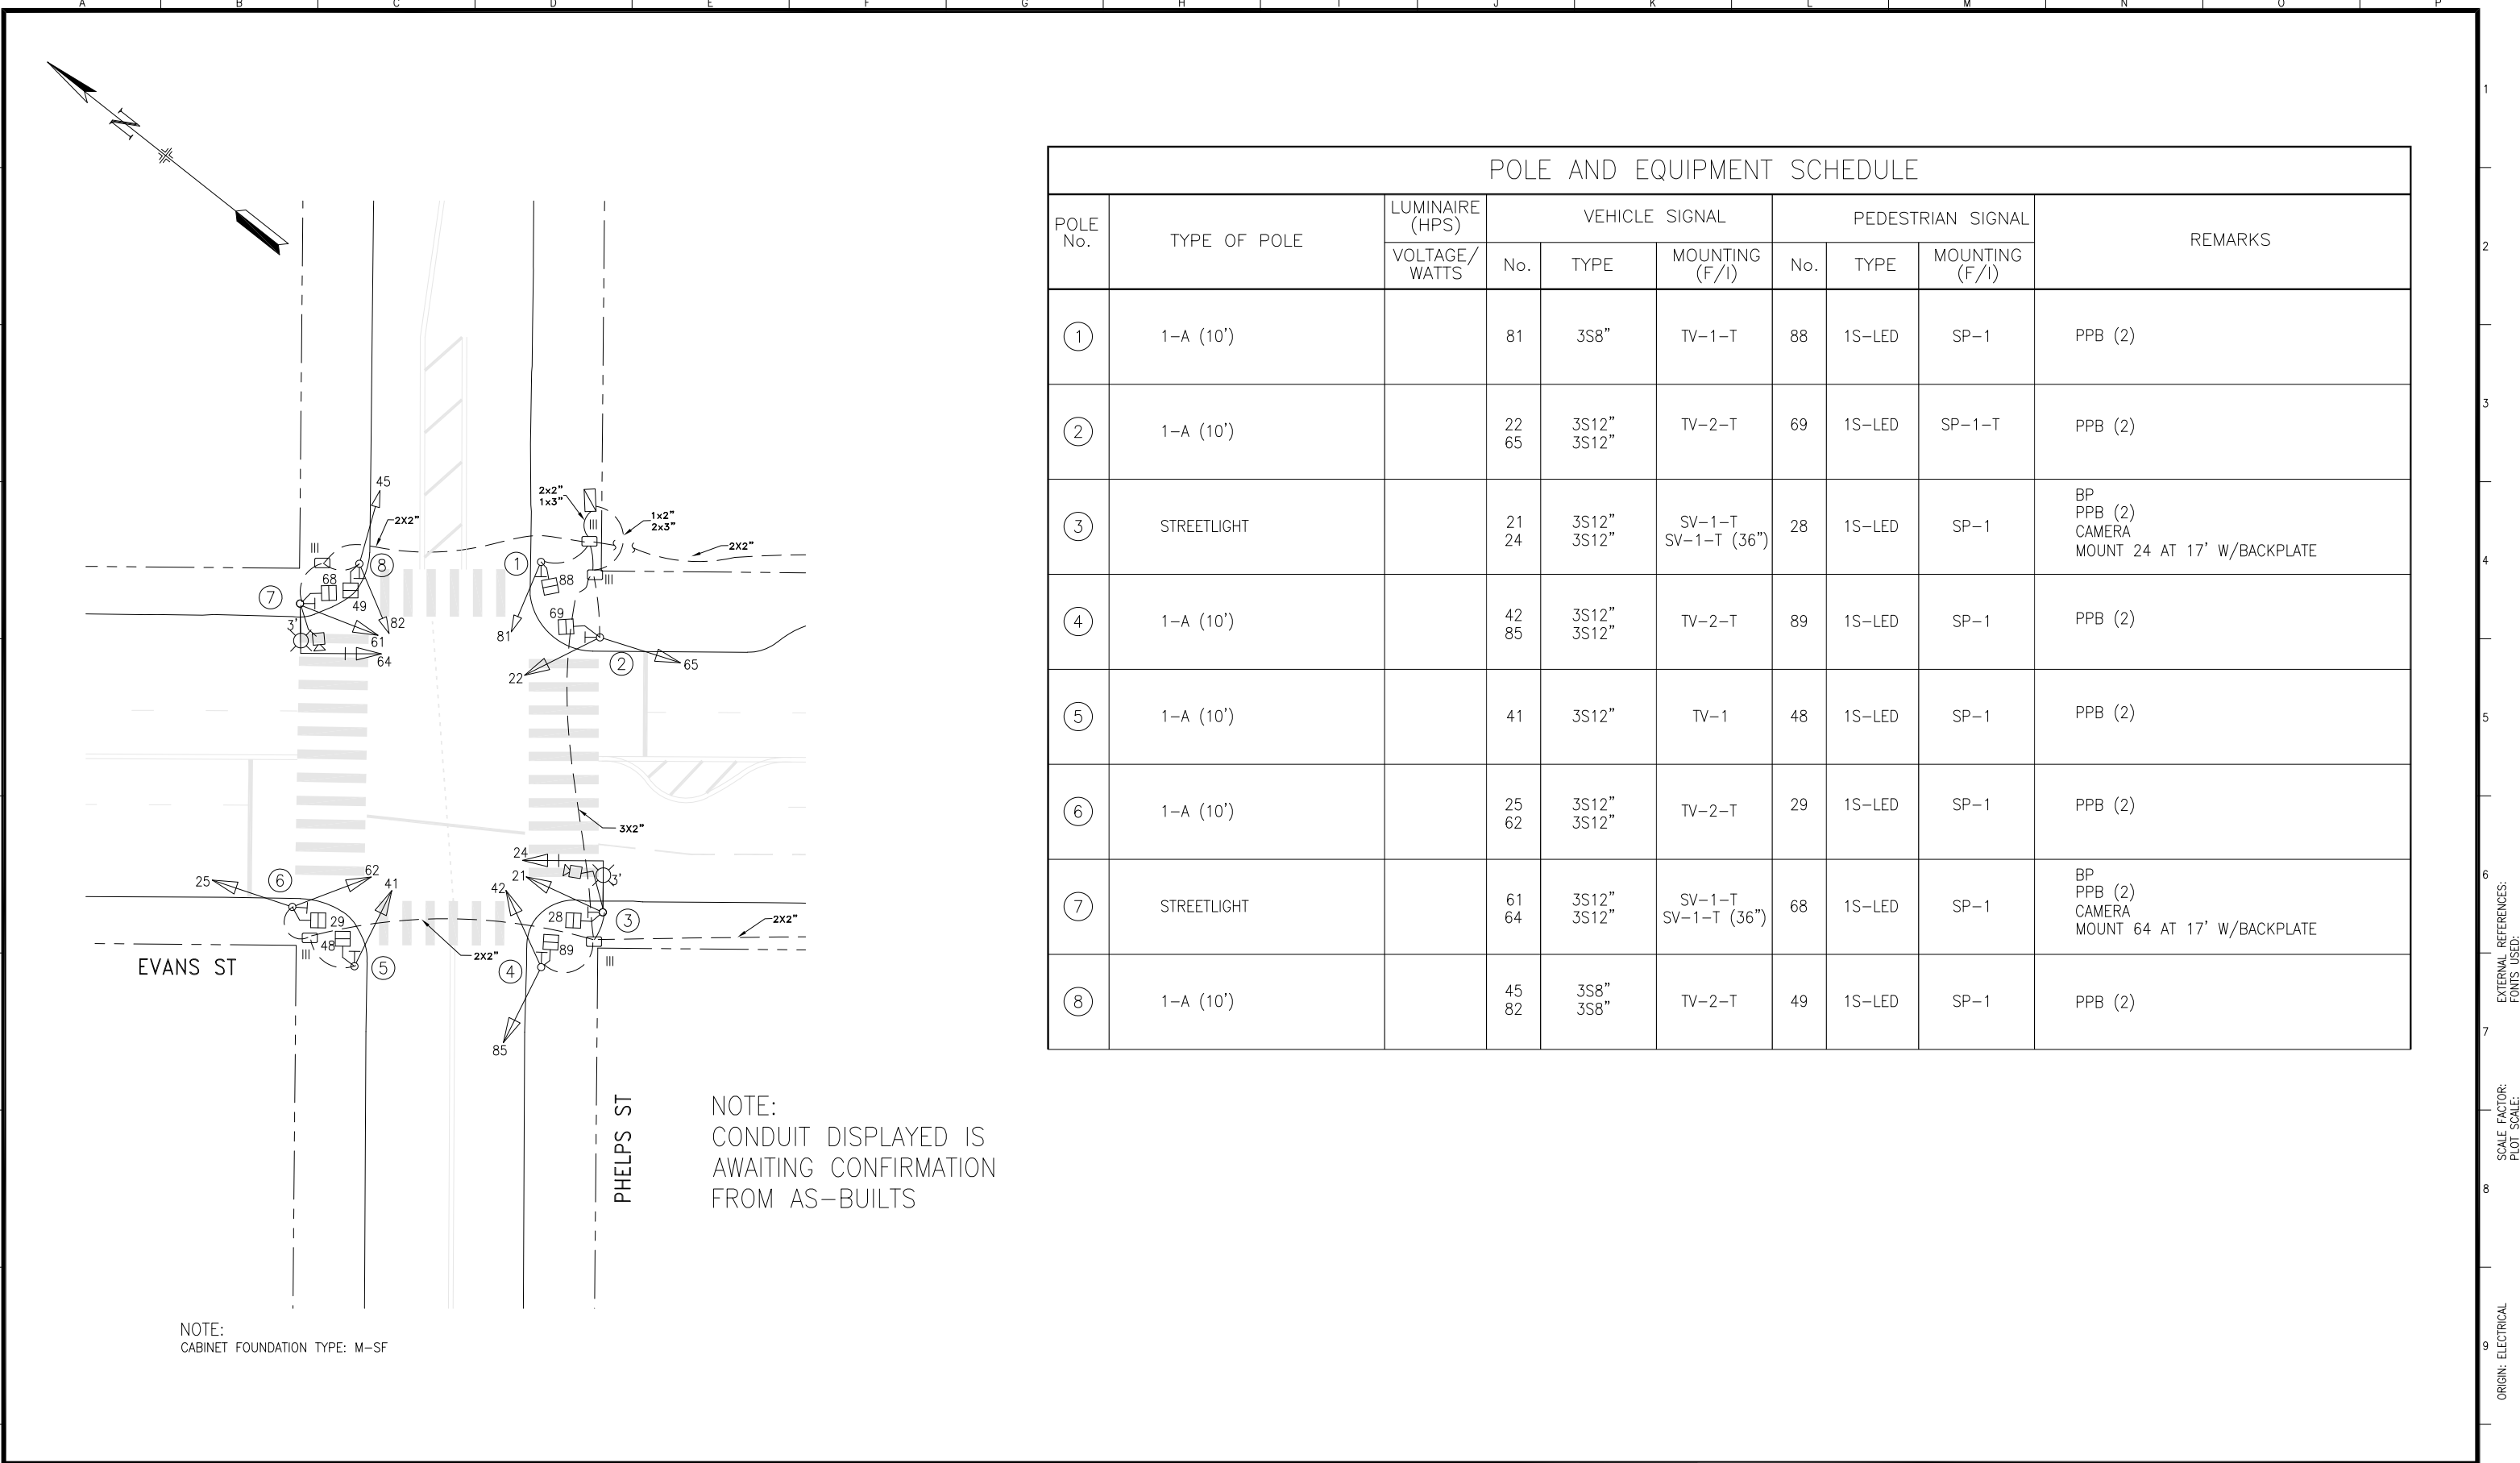

POLE AND EQUIPMENT SCHEDULE									
POLE No.	TYPE OF POLE	LUMINAIRE (HPS)	VEHICLE SIGNAL			PEDESTRIAN SIGNAL			REMARKS
		VOLTAGE/ WATTS	No.	TYPE	MOUNTING (F/I)	No.	TYPE	MOUNTING (F/I)	
①	1-A (10')		81	3S8"	TV-1-T	88	1S-LED	SP-1	PPB (2)
②	1-A (10')		22 65	3S12" 3S12"	TV-2-T	69	1S-LED	SP-1-T	PPB (2)
③	STREETLIGHT		21 24	3S12" 3S12"	SV-1-T SV-1-T (36")	28	1S-LED	SP-1	BP PPB (2) CAMERA MOUNT 24 AT 17' W/BACKPLATE
④	1-A (10')		42 85	3S12" 3S12"	TV-2-T	89	1S-LED	SP-1	PPB (2)
⑤	1-A (10')		41	3S12"	TV-1	48	1S-LED	SP-1	PPB (2)
⑥	1-A (10')		25 62	3S12" 3S12"	TV-2-T	29	1S-LED	SP-1	PPB (2)
⑦	STREETLIGHT		61 64	3S12" 3S12"	SV-1-T SV-1-T (36")	68	1S-LED	SP-1	BP PPB (2) CAMERA MOUNT 64 AT 17' W/BACKPLATE
⑧	1-A (10')		45 82	3S8" 3S8"	TV-2-T	49	1S-LED	SP-1	PPB (2)

4	7/31/20	SRC 2019-301: ADDED SIGNALS #24 & 64					KK	MV	
3	9/12/19	CONTRACT #2797J: MOVED POLE #2 ONTO BULBOUT. SIGNALS 25,41,42,85 ARE 12" HEADS PER FIELD CHECK					KK	MV	
2	1/12/12	RENUMBER HEADS PER TIMING CARD. #82 8" HEAD PER FIELD & UPGRADE 61,62 TO 12"					CVM	MV	
1	10/24/06	TRAFFIC SIGNAL UPGRADE FOR THIRD STREET LIGHT RAIL CT#MR-1142					DY	AH	
NO.	DATE	DESCRIPTION					BY	APP.	
TABLE OF REVISIONS CHECK WITH TRACING TO SEE IF YOU HAVE LATEST REVISION									

COMPLETION DATE / ELECTRICIAN INITIAL
--



DEPARTMENT OF PARKING AND TRAFFIC
DIVISION OF TRAFFIC ENGINEERING
CITY AND COUNTY OF SAN FRANCISCO

DRAWN: DY/KK	DATE: 2/07	SCALE: 1:200	TRAFFIC SIGNAL INVENTORY DIAGRAM	CNN NO. 20241000
CHECKED:	DATE:	SHEET OF SHEETS 1 OF 1		EVANS AND PHELPS STS INTERSECTION

CNN NO. 20241000
REV. NO.
4