
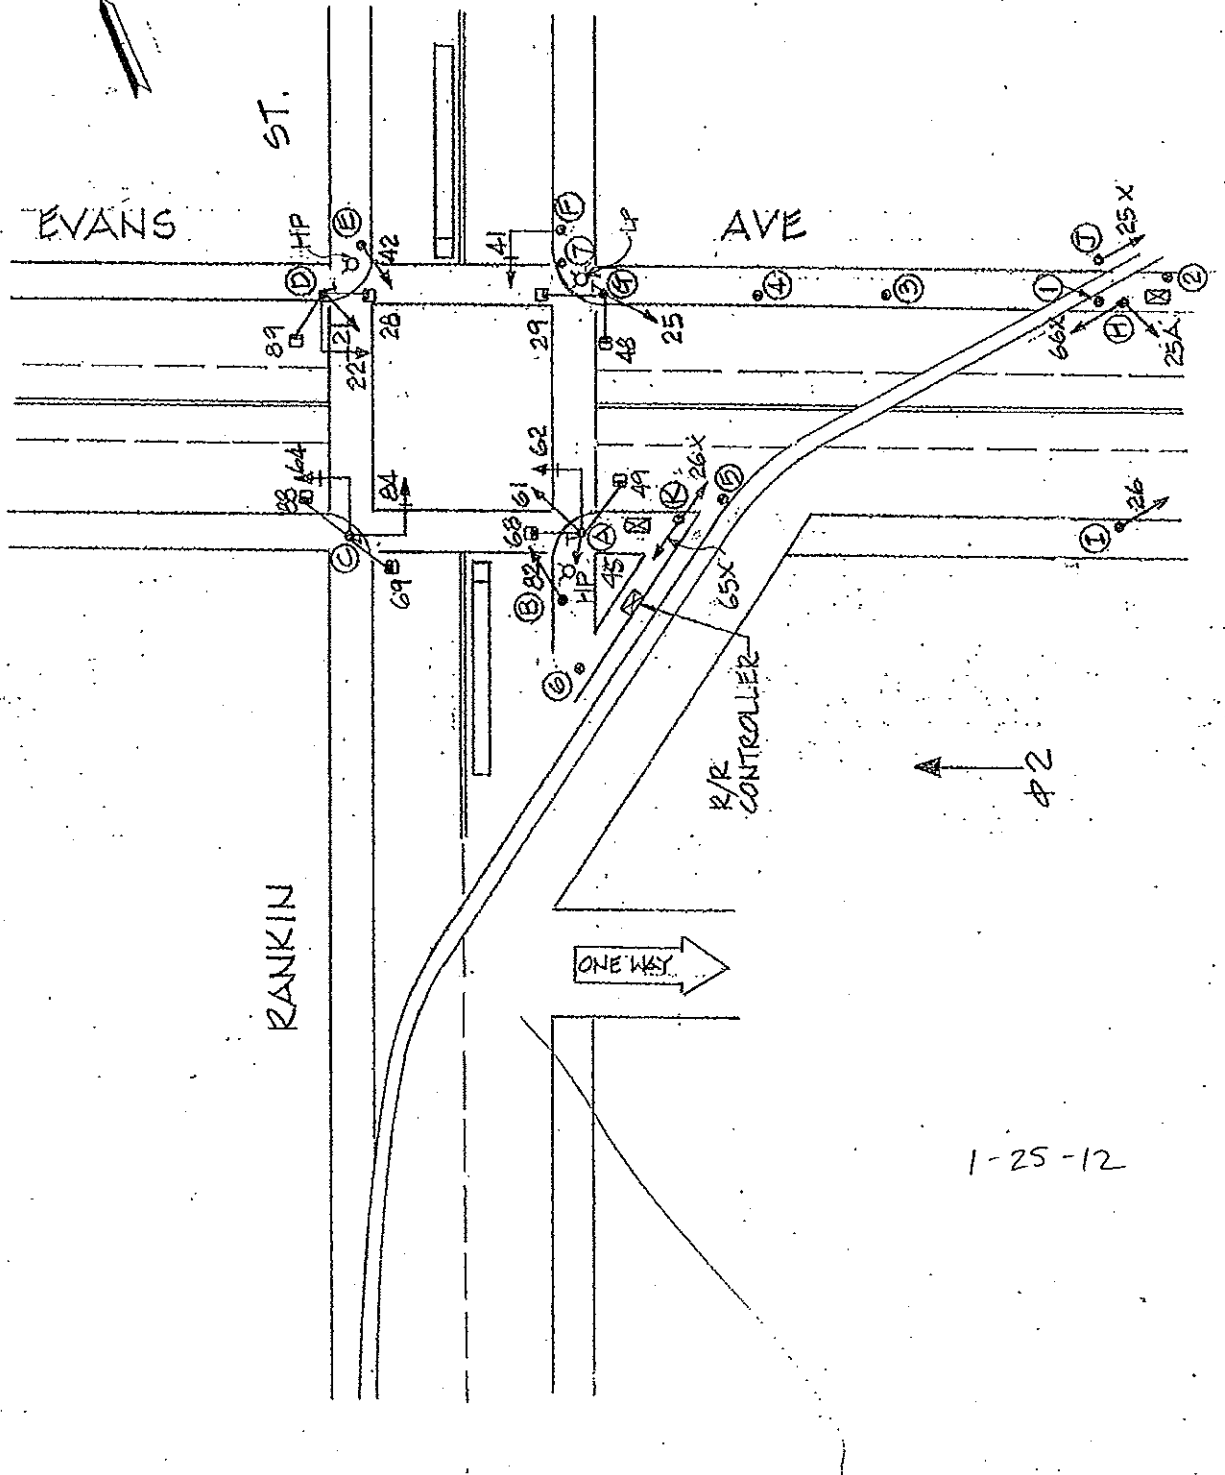


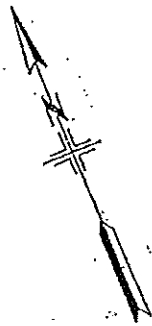

EVANS AVE & RANKIN ST.

[illegible]

CONTROLLER CABINET SIZE : LARGE BASE CABINET: —

COMMENTS :

R = RAILROAD POLE

M CABINET

RAILROAD SIGNALS 29x, 36x, 65x, 66x ARE NOT IN SERVICE

SRC 2011-260 : CHANGED 41 TO 4-SECTION; ADDED 45; UPGRADED 61 TO 12"