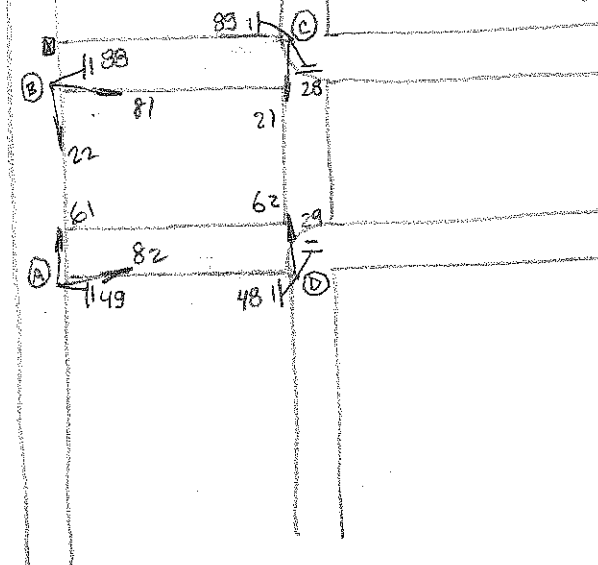


2019-2020

1. *...the ... of ...*
 2. *...the ... of ...*
 3. *...the ... of ...*

[illegible]

COMMENTS :

3/27/08

2/8/10

NIS:
ADDED PEDESTRIAN COUNTDOWN SIGNALS = Remove signal heads 41 & 42.
Upgrade all signal heads to 12" heads.