


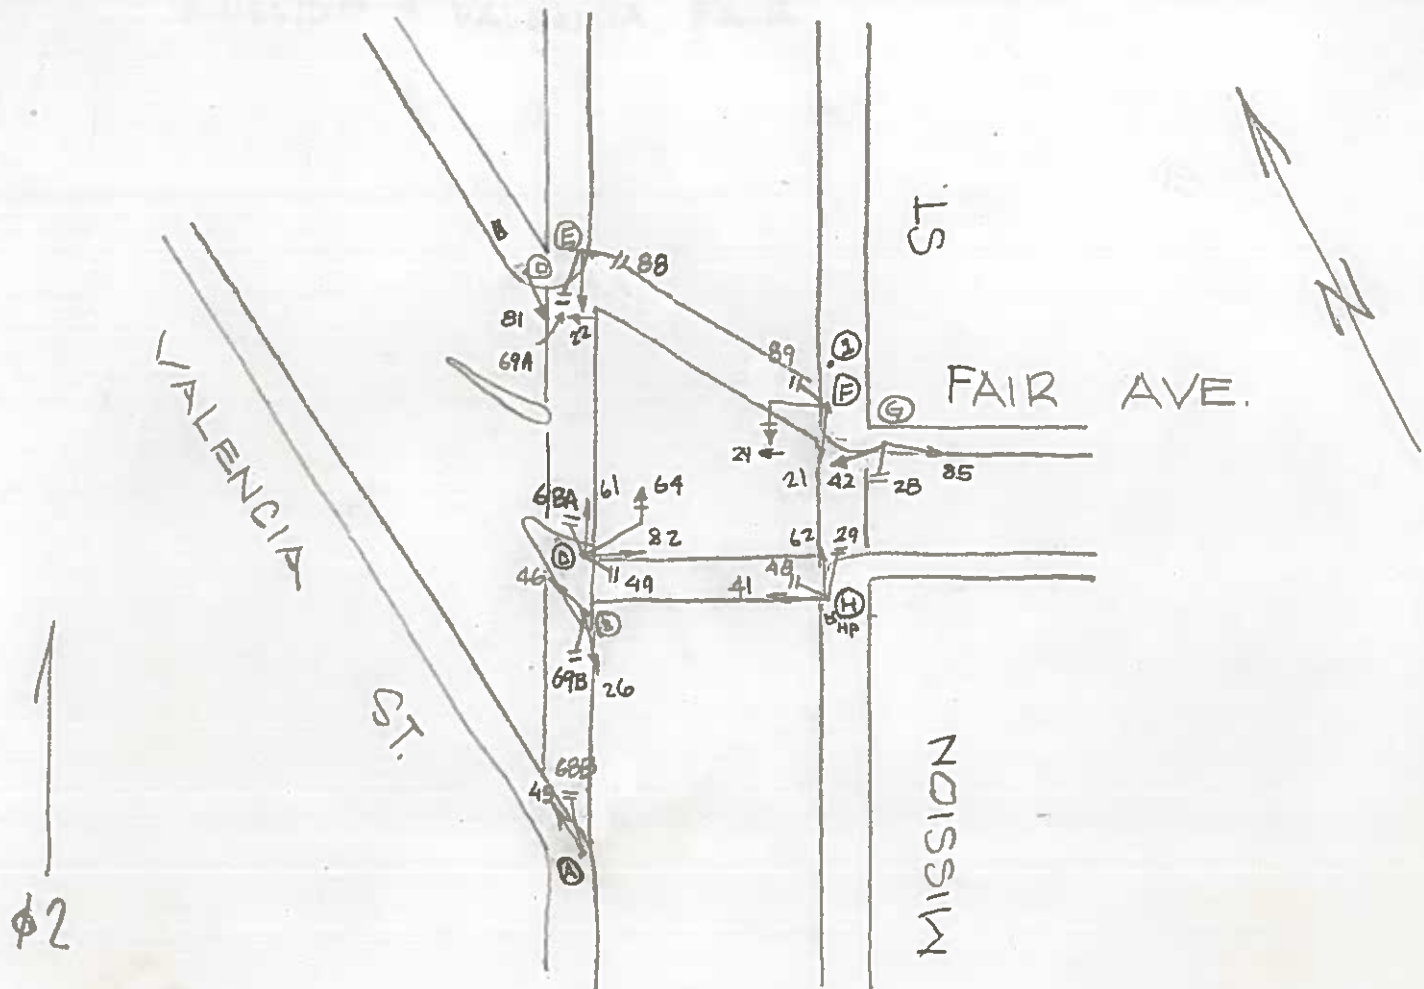

SRC changes implemented on 5/17/16

POLE	FUNC.	MAT'L	SIGNAL NO.	MAKE	NO. OF SECT.	SIZE	VISOR	B.P. OR LOUVERS	MOUN'T	PED SIGNAL NO.	LEGEND	MESSAGE		MAKE	MOUN'
												ELEMENT	COLOR		
A	S	S	41	CH	3	8"	T8"	NO	T	28	I	15-I	W/O R	ICC	S
B	S	S	45	CH	3	8"	T8"	NO	S	29	I	15-I	W/O R	ICC	S
C	S	S	26	CH	3	8"	T8"	NO	T	48	I	15-I	W/O R	ICC	S
D	S	S	46	CH	3	8"	T8"	NO	T	49	I	15-I	W/O R	ICC	S
E	S	S	82	CH	3	8"	T8"	NO	S	68	I	15-I	W/O R	ICC	S
F	S	S	61	CH	3	8"	T8"	NO	S	69	I	15-I	W/O R	ICC	S
G	S	S	22	TCT	5	12"	T12"	NO	S	64	I	15-I	W/O R	ICC	S
H	S	S	81	TCT	3	12"	T12"	NO	S	65	I	15-I	W/O R	ICC	S
I	S	S	42	CH	3	8"	T8"	NO	S	88	I	15-I	W/O R	ICC	S
I	M	S	21	CH	3	8"	T8"	NO	S	89	I	15-I	W/O R	ICC	S
			62	CH	3	8"	T8"	NO	T						
			85	CH	3	8"	T8"	NO	S						
			24	CH	5	12"	T12"	BP	A						
			64	CH	3	12"	T12"	BP	A						

CONTROLLER CABINET SIZE : ORDINARY BASE CABINET: Yes

COMMENTS : SRC 2016-124: Add left turn arrows to signals 22 & 24