

SWITCHED OVER 6/9/2016 @ 9:43 AM
A. SCALES (MTA); J. TOM (SFPW);
S. BUSS, L.WONG (Signal Shop)

6/10/2020, J. Hornbostel:
Per SRC 2020-101 Renumber
east side ped xing as 9P.

POLE AND EQUIPMENT SCHEDULE											
POLE No.	TYPE OF POLE	LUMINAIRE VOLTAGE/WATTAGE	VEHICLE SIGNAL					PEDESTRIAN SIGNAL			REMARKS
			No.	TYPE	MOUNTING	VISORS	LOUVERS	No.	TYPE	MOUNTING	
①	EX POLE WITH 15' MAST ARM AND 6' LA		21 24	4S12"GRA 4S12"GRA	SV-1-T MAS	T T		98 20	1S-COUNT 3	SP-1	APS-4W BACKPLATE
②	1-A (10')		25 42	4S12"GRA 3S12"	TV-2-T	T T		89	1S-COUNT	SP-1	APS-4W
③	CITY STANDARD STREET LIGHT		41	3S12"	SV-1-T	T		48	1S-COUNT	SP-1	APS-4W
④	1-A (7')							99 20	1S-COUNT 3	TP-1	APS-4W 4
⑤	EX MARBELITE STREET LIGHT							68	1S-COUNT	SP-1	APS-4W
⑥	1-A (10')		82	3S12"	TV-1-T	T		49	1S-COUNT 3	SP-1	APS-4W 4
⑦	CITY STANDARD STREET LIGHT		41	3S12"	SV-1-T	T		88	1S-COUNT	SP-1	APS-4W
⑧	1-A (10')		22	3S12"	TV-1-T	T		69	1S-COUNT 3	SP-1	APS-4W


SHEET NOTES

- CONTRACTOR SHALL COORDINATE WITH SFMTA TRAFFIC SIGNAL SHOP PRIOR TO RELOCATING PEDESTRIAN SIGNALS. CONTRACTOR TO F/I NEW PEDESTRIAN SIGNALS ON EXISTING SIGNAL POLES AS SHOWN. SFMTA TRAFFIC SIGNAL SHOP TO RELOCATE EXISTING APS EQUIPMENT CONCURRENT WITH ACTIVATION OF NEW PEDESTRIAN SIGNALS. CONTRACTOR TO R/S EXISTING PEDESTRIAN SIGNALS AFTER ACTIVATION OF NEW PEDESTRIAN SIGNALS.
- PULL BACK WIRES FOR EXISTING TRAFFIC SIGNALS TO BE REMOVED TO PULL BOX. RE-PULL EXISTING TRAFFIC SIGNAL WIRING TO NEW TRAFFIC SIGNALS IF FEASIBLE, ELSE SPLICE NEW WIRES AT PULL BOX TO NEW TRAFFIC SIGNALS. CONTRACTOR SHALL COORDINATE WITH SFMTA TRAFFIC SIGNAL SHOP PRIOR TO RELOCATION OF ANY PEDESTRIAN SIGNALS.
- CONTRACTOR TO INSTALL CITY FURNISHED ONE SECTION LED PEDESTRIAN COUNTDOWN SIGNAL MODULE IN CONTRACTOR FURNISHED ONE SECTION PEDESTRIAN SIGNAL HOUSING.
- CITY FORCES TO INSTALL CITY FURNISHED APS PUSH BUTTONS ON POLES AS SHOWN ON INTERSECTION DRAWING AND AS INDICATED IN POLE & EQUIPMENT SCHEDULE AND APS WIRING AS NECESSARY.
- F/I 1-2" CONDUIT WITH PULL TAPE.
- REMOVE EXISTING SIGNAL HEADS; RECONNECT ALL EXISTING WIRES TO NEW VEHICLE SIGNALS.
- CONTRACTOR TO REPLACING EXISTING PULL BOX LID WITH NEW LID.
- FOR TREE PRUNING AT THE SOUTHWEST CORNER, CONTACT SAN FRANCISCO PUBLIC WORKS BUREAU OF URBAN FORESTRY AT (415) 554-6700

GENERAL NOTES

- CONTRACTOR TO REFER TO DRAWING G-0.4, GENERAL NOTE 15, 35, 44, 45, 46 FOR ADDITIONAL INFORMATION.

PHASE DIAGRAM

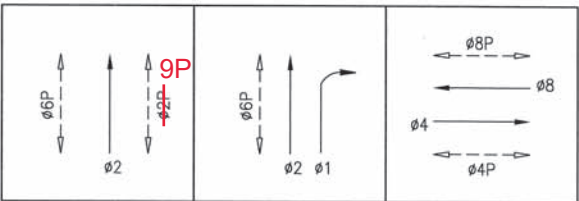

PHASE SEQUENCE

OFF	GRA	OFF	FRANKLIN ST. (NB RT) - 01
R	G	Y	FRANKLIN ST. (NB) - 02
R	G	Y R	FELL ST. (EB & WB) - 04 & 08
W	FRH	RH	PEDS XING FELL ST. (ES) - 02P 9P
W	FRH	RH	PEDS XING FELL ST. (WS) - 06P
RH	W	FRH RH	PEDS XING FRANKLIN ST. (SS & NS) - 04P & 08P

NO.	DATE	DESCRIPTION	BY	APP.
TABLE OF REVISIONS				

REFERENCE INFORMATION
& FILE NO. OF SURVEYS



INFRASTRUCTURE DIVISION
SAN FRANCISCO PUBLIC WORKS
CITY AND COUNTY OF SAN FRANCISCO



DESIGNED: DATE: 3/10/15
3H/WC
DRAWN: DATE: 3/10/15
SS/WC
CHECKED: DATE: 3/10/15
STL/NW

APPROVED
SECTION MANAGER
DEPUTY DIVISION MANAGER
DIVISION MANAGER

SCALE:
AS SHOWN
SHEET OF SHEETS
11 OF 73

FRANKLIN AND DIVISADERO STREET
TRAFFIC SIGNAL UPGRADE

FRANKLIN STREET AND FELL STREET
TRAFFIC SIGNAL WORK

CONTRACT NO.
2596J
DRAWING NO.
E-2.0
FILE NO.
100,800
REV. NO.