


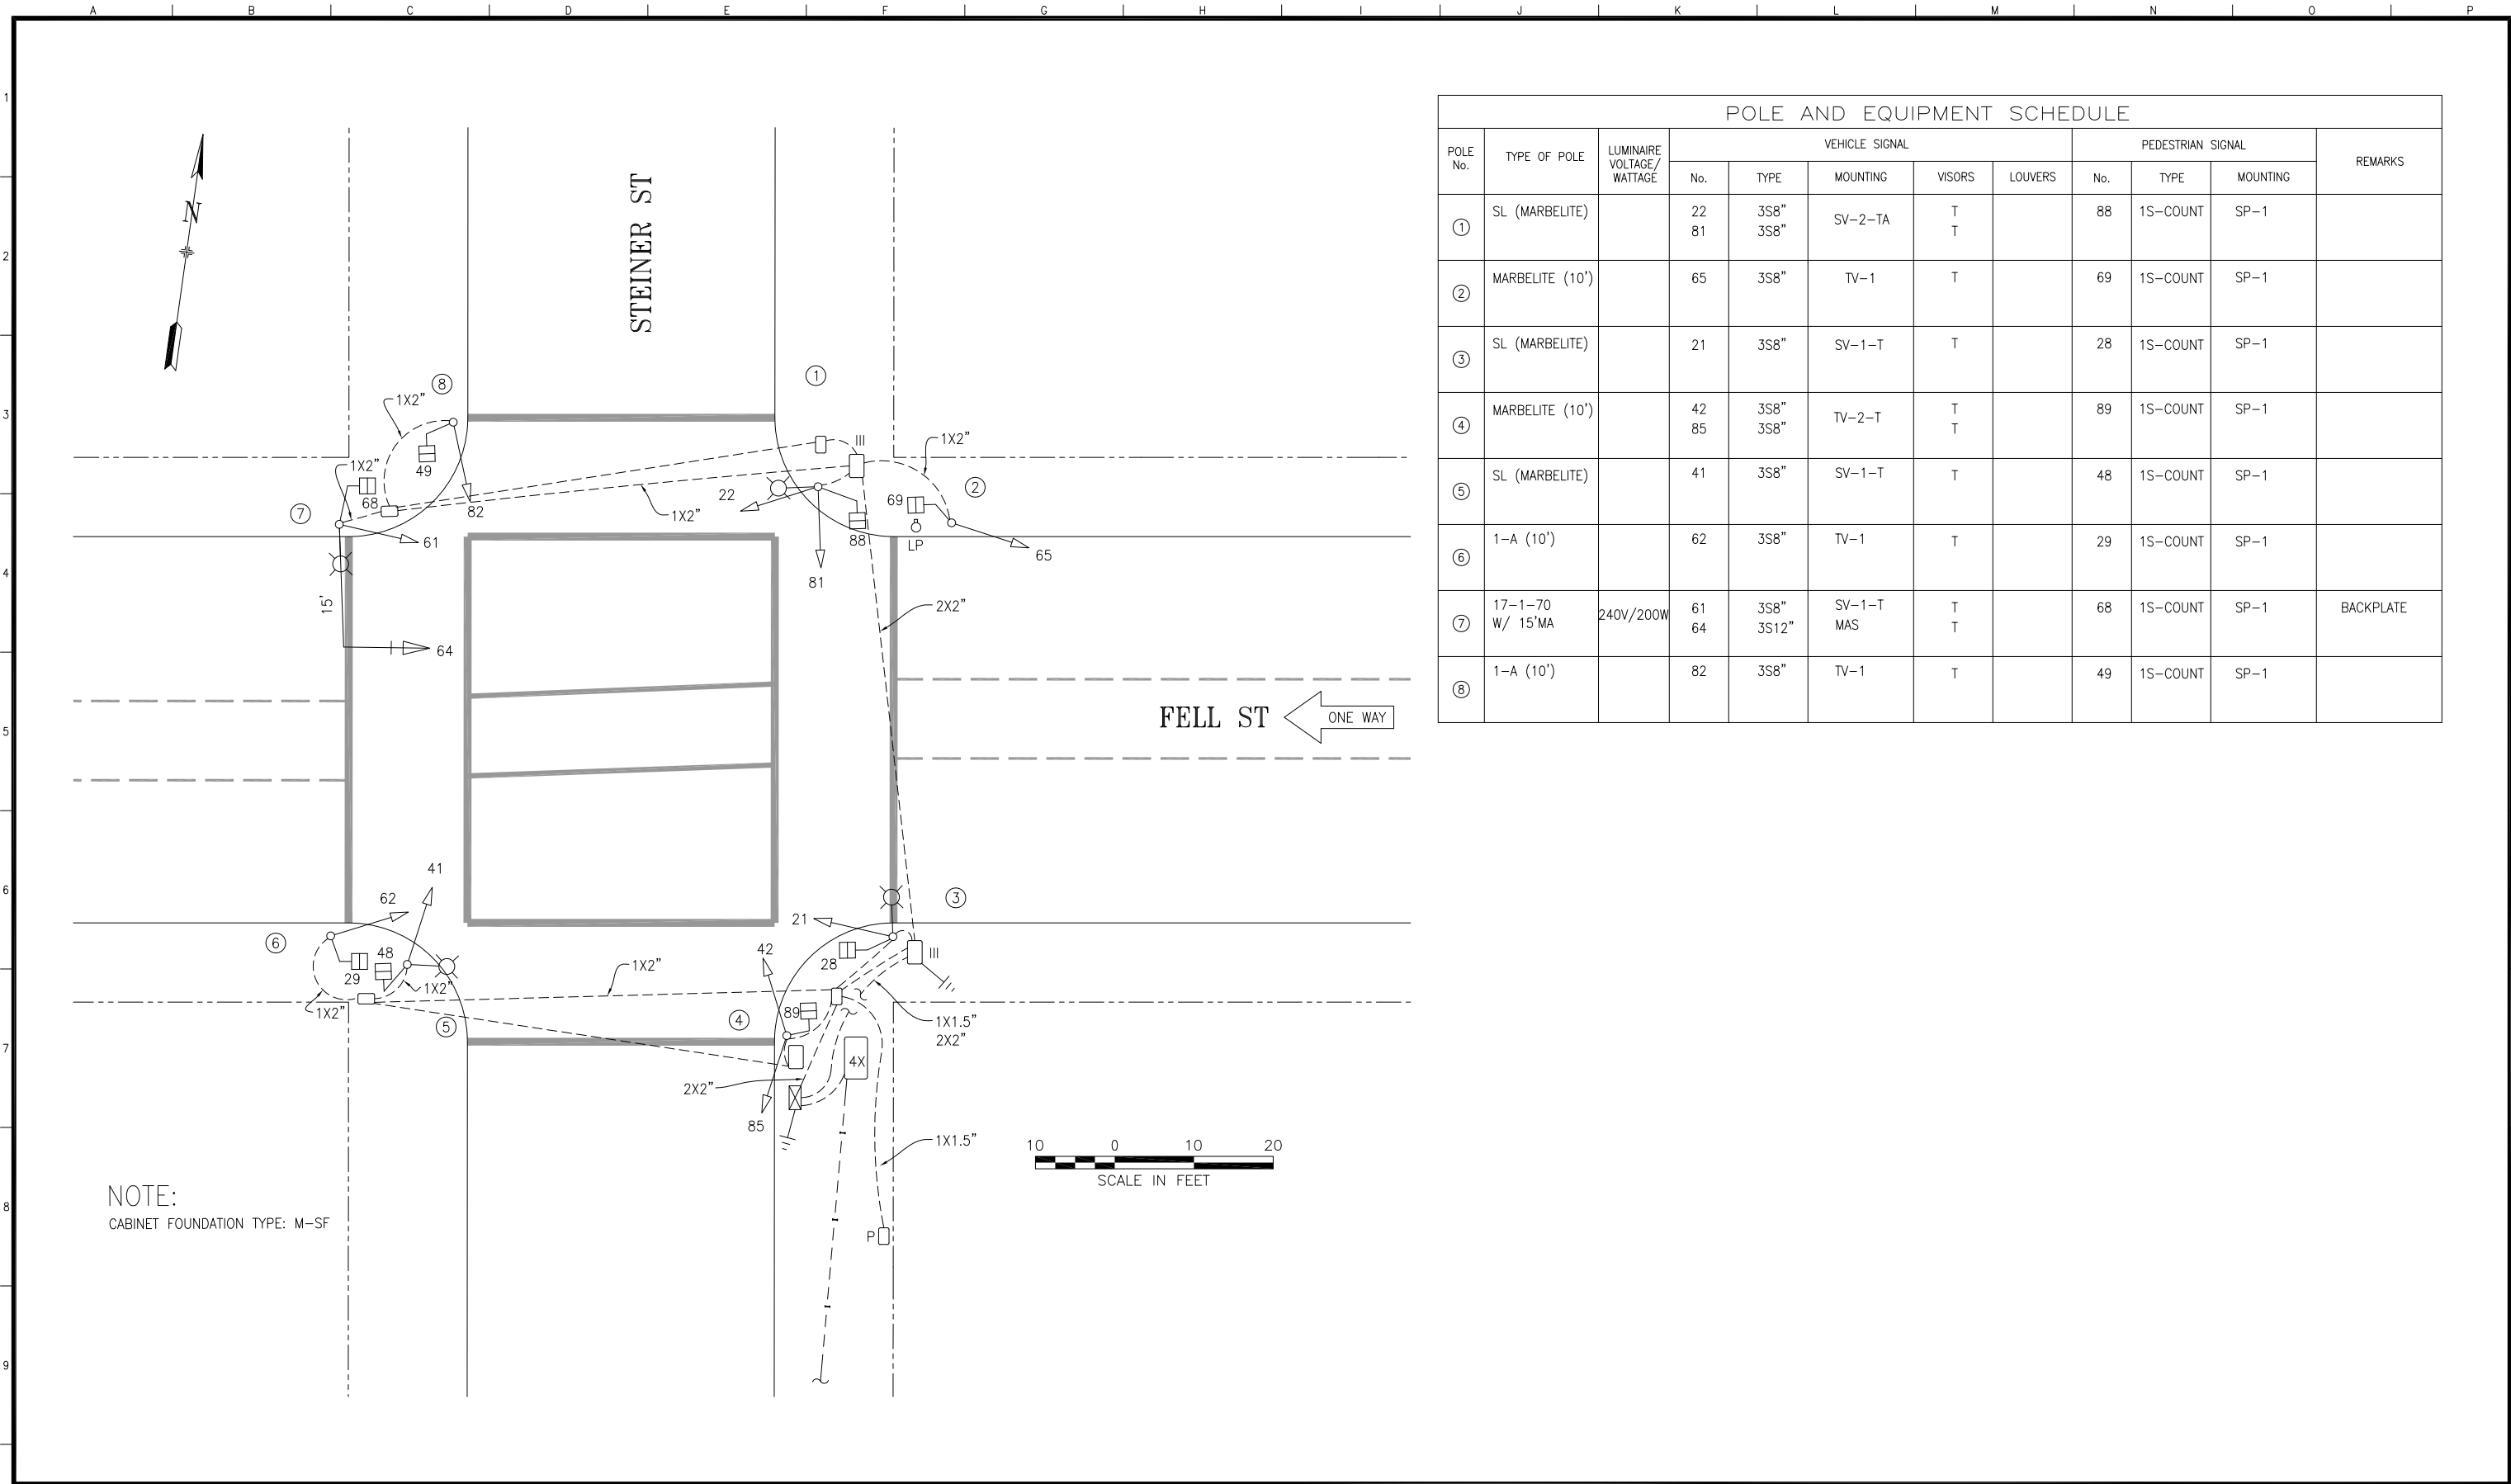

POLE AND EQUIPMENT SCHEDULE											
POLE No.	TYPE OF POLE	LUMINAIRE VOLTAGE/ WATTAGE	VEHICLE SIGNAL					PEDESTRIAN SIGNAL			REMARKS
			No.	TYPE	MOUNTING	VISORS	LOUVERS	No.	TYPE	MOUNTING	
①	SL (MARBELITE)		22 81	3S8" 3S8"	SV-2-TA	T T		88	1S-COUNT	SP-1	
②	MARBELITE (10')		65	3S8"	TV-1	T		69	1S-COUNT	SP-1	
③	SL (MARBELITE)		21	3S8"	SV-1-T	T		28	1S-COUNT	SP-1	
④	MARBELITE (10')		42 85	3S8" 3S8"	TV-2-T	T T		89	1S-COUNT	SP-1	
⑤	SL (MARBELITE)		41	3S8"	SV-1-T	T		48	1S-COUNT	SP-1	
⑥	1-A (10')		62	3S8"	TV-1	T		29	1S-COUNT	SP-1	
⑦	17-1-70 W/ 15'MA	240V/200W	61 64	3S8" 3S12"	SV-1-T MAS	T T		68	1S-COUNT	SP-1	BACKPLATE
⑧	1-A (10')		82	3S8"	TV-1	T		49	1S-COUNT	SP-1	

0	10/9/14	NEW SID PER FIELD CHECK AND AS-BUILTS	DY	BW	
NO.	DATE	DESCRIPTION	BY	APP.	
TABLE OF REVISIONS					
CHECK WITH TRACING TO SEE IF YOU HAVE LATEST REVISION					

REFERENCE INFORMATION & FILE NO. OF SURVEYS



SAN FRANCISCO MUNICIPAL TRANSPORTATION AGENCY

CITY AND COUNTY OF SAN FRANCISCO

DRAWN:	DATE:
DY	10/2014
CHECKED:	DATE:
BW	10/2014

SCALE:
1" = 10'
SHEET OF SHEETS
1 OF 1

TRAFFIC SIGNAL INVENTORY DIAGRAM
FELL STREET AND STEINER STREET

CNN NO.
26038000
REV NO.
0