


POLE AND EQUIPMENT SCHEDULE										
POLE No.	TYPE OF POLE	FIXTURE TAG	VEHICLE SIGNAL					PEDESTRIAN SIGNAL		
			No.	TYPE	MOUNTING	VISORS	LOUVERS	No.	TYPE	MOUNTING
①	16-2-100 W/ 15' MAST ARM		24 21 42	3S12" 3S12" 4S12"GLA	MAS SV-2-TA	T T T		89	1S-COUNT	SP-1
②	1-A (10')		41 62	4S12"GLA 3S12"	TV-2-T	T T				
③	17-2-100 W/ 15' MAST ARM W/ 6' LUMINAIRE ARM	S2 72	64 61	3S12" 3S12"	MAS SV-1-T	T T		68	1S-COUNT	SP-1
④	1-A (10')		45	3S12"	TV-1-T	T		49	1S-COUNT	SP-1
⑤	CITY STANDARD STREETLIGHT	S2 72	22	3S12"	SV-1-T SV-1 (20')	T		69 88	1S-COUNT 1S-COUNT	SP-1 SP-1
⑥	1-A (7')							48	1S-COUNT	SP-1
⑦	POST TOP STREETLIGHT	65W								

SHEET NOTES:

- ① CONTRACTOR TO INSTALL CITY FURNISHED INTERSECTION TRAFFIC SIGNAL CONTROLLER CABINET IN THE CONTRACTOR CONSTRUCTED CABINET FOUNDATION
- ② CITY FORCES TO INSTALL APS UNIT
- ③ MAINTAIN EXISTING CIRCUIT CONTINUITY TO ADJACENT FIXTURE AS REQUIRED PRIOR TO R/C UNUSED PULL BOX
- ④ COORDINATE WITH PG&E AND INFORM SFPUC OF STREETLIGHT SERVICE DISCONNECTION, PROVIDE 30 DAYS NOTICE
- ⑤ R/S STREETLIGHT POLE AND FIXTURE AND CONTROL, DELIVER POLE AND LUMINAIRE TO 651 BRYANT ST, COORDINATE WITH BART MURPHY AT 415-227-8512(BMURPHY@SFWATER.ORG)
- ⑥ COORDINATE WITH ENGINEER FOR PARKING METER RELOCATION AS REQUIRED
- ⑦ RELOCATE EXISTING POST TOP STREETLIGHT ADJACENT TO POLE #5. INSTALL POST TOP STREETLIGHT 6-FT SOUTH OF POLE #1 AND 36-INCHES FROM FACE OF CURB

PHASE DIAGRAM

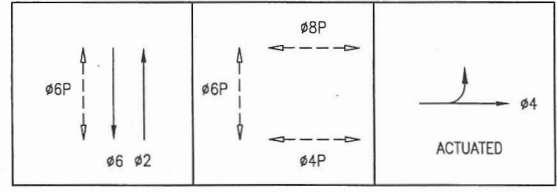

Signal flashing on 11/5/2019 10:20am.
Attendees:
Ben Leung (SFPW)
Celine Leung (SFMTA)
Angelo Reyes (Signal Shop)
Alan Coughlan (Signal Shop)

Signal 3-color operation on 11/7/2019 9:40am.

