


FULTON & FILLMORE

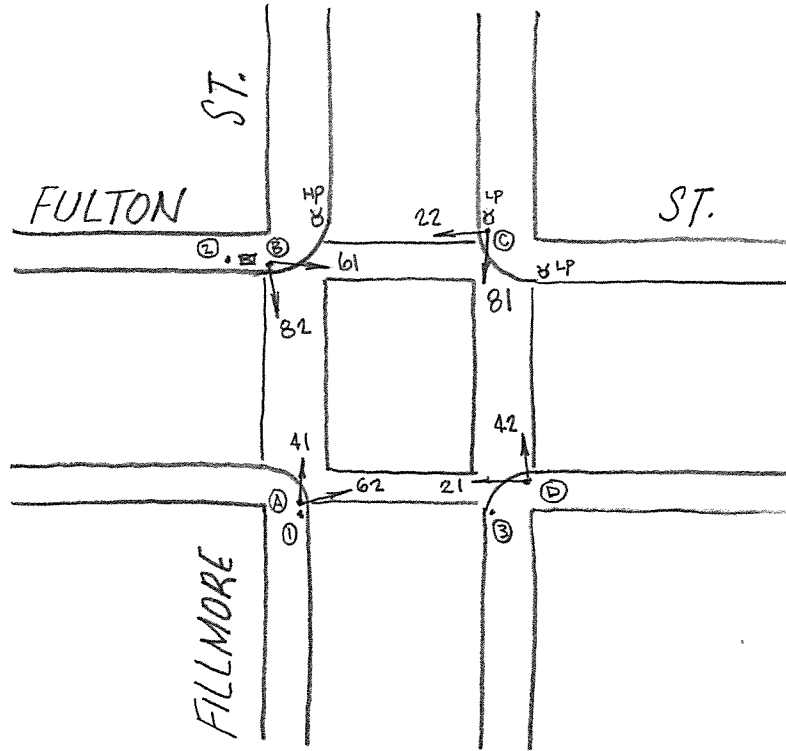

Ø2 _____

1-30-17

[illegible]

CONTROLLER CABINET SIZE : ORDINARY BASE CABINET: YES

COMMENTS: Upgrade all vehicle signals to 12", per SRC 2016-342. JOK