


POLE AND EQUIPMENT SCHEDULE											
POLE No.	TYPE OF POLE	FIXTURE TYPE	VEHICLE SIGNAL					PEDESTRIAN SIGNAL			REMARKS
			No.	TYPE	MOUNTING	VISORS	LOUVERS	No.	TYPE	MOUNTING	
①	STEEL STREET LIGHT 6' LUMINIARE ARM	108W LED	65 81	3S12" 3S12"	SV-2-TA	T T	45° GREEN	69 88	1S-COUNT 1S-COUNT	SP-2-T	TSP: OPTICOM
②	MUNI POLE		42	3S12"	SV-1-T(36")	T		89	1S-COUNT	SP-1-T	EXTERNAL CONDUIT INTO PULLBOX
③	MUNI STREET LIGHT WITH 12' NON-STANDARD MAST ARM & LUMINAIRE ARM	72W LED	41	3S8"	MAS	FC		48	1S-COUNT	SP-1-T	EXTERNAL CONDUIT BTWN PCS & MAST ARM
④	17-3-100 W/ 20' MAST ARM & 6' LUMINAIRE	108W LED	61 64	3S12" 3S12"	SV-1-T MAS	T T	BP	68	1S-COUNT	SP-1	
⑤	1-A (10')		82	3S12"	TV-1-T	T	80° GREEN	49	1S-COUNT	SP-1	
⑥	MUNI STREET LIGHT WITH 12' NON-STANDARD MAST ARM & LUMINAIRE ARM	72W LED	81	3S8"	MAS	FC		88	1S-COUNT	SP-1-T	EXTERNAL CONDUIT INTO PULLBOX
⑦	17-3-100 W/ 20' MAST ARM & 6' LUMINAIRE	108W LED	21 24	3S12" 3S12"	SV-1-T MAS	T T	BP	28	1S-COUNT	SP-1	
⑧	1-A (10')		42	3S12"	TV-1-T	T	45° GREEN	89	1S-COUNT	SP-1	
⑨	1-A (10')		41	3S12"	TV-1-T	T	45° GREEN	48	1S-COUNT	SP-1	
⑩	STEEL STREET LIGHT 6' LUMINIARE ARM	108W LED	25	3S12"	SV-1-T	T		29	1S-COUNT	SP-1	TSP: OPTICOM
⑪	MUNI POLE WITH 12' NON-STANDARD MAST ARM		82	3S8"	MAS	FC		49	1S-COUNT	SP-1-T	EXTERNAL CONDUIT

- SHEET NOTES:**
- Ⓐ LIVE WIRES. ABANDONED 1960's TRAFFIC SIGNAL SERVICE. COULD NOT TRACE CONDUIT TO FIND DISCONNECT (SRC2021-073).
 - Ⓑ EXISTING EXTERNAL CONDUITS WERE INTERCEPTED IN THE PULLBOX.
 - Ⓒ EXISTING EXTERNAL CONDUITS WERE INTERCEPTED IN THE ROADWAY AND MATCHED WITH SIMILAR TYPE CONDUIT.
 - Ⓓ EXISTING CONDUITS HUNG UNDER THE BRIDGE STRUCTURE WERE INTERCEPTED IN THE PULLBOX.
 - Ⓔ 12C CABLE CUT IN TYPE III PULLBOX AT NE CORNER.

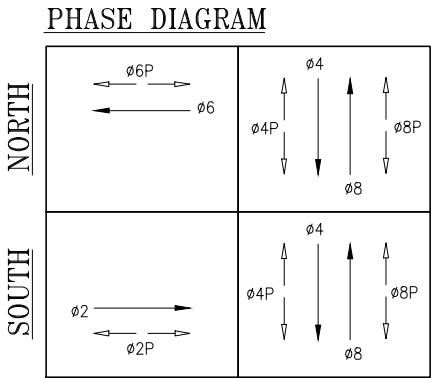

NO.	DATE	DESCRIPTION	BY	APP.
0	02/03/21	SIGNAL UPGRADE BY 2608J; SPLIT INTO NORTH AND SOUTH. CONVERTED FROM CONTRACT PLAN INCL PCO#02.	UNMODIFIED	
TABLE OF REVISIONS				
CHECK WITH TRACING TO SEE IF YOU HAVE LATEST REVISION				

REFERENCE INFORMATION
& FILE NO. OF SURVEYS

SEE GEARY RAPID WEST OF
VAN NESS SURFACE CONTRACT
(2608J) E-10.1, FILE 110,925
FOR 2/3/2021 AS-BUILT DWG



SAN FRANCISCO MUNICIPAL TRANSPORTATION AGENCY

CITY AND COUNTY OF SAN FRANCISCO

DRAWN: D.MACKOWSKI
DATE: 07/2021

CHECKED: K.KWONG
DATE: 07/2021

SCALE:
AS SHOWN

SHEET OF SHEETS
1 OF 2

TRAFFIC SIGNAL INVENTORY DIAGRAM

FILLMORE STREET AND GEARY BOULEVARD
NORTH AND SOUTH INTERSECTIONS

CNN NO.
26590000
26590001

REV NO.
0

