


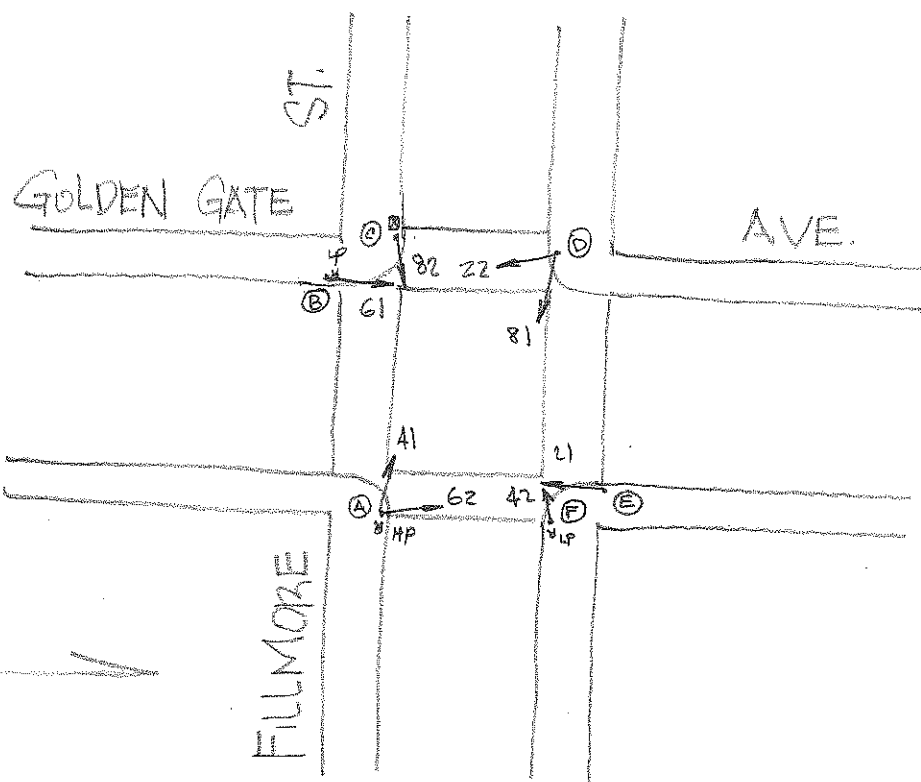

12-27-12

[illegible]

CONTROLLER CABINET SIZE : ORDINARY = BASE CABINET: NO

COMMENTS: * SIGNALS 21, 22, 81, 82, 41, 42 UPGRADED TO 12" PER SRC 2012-235
ON 12/27/12 - CVM