


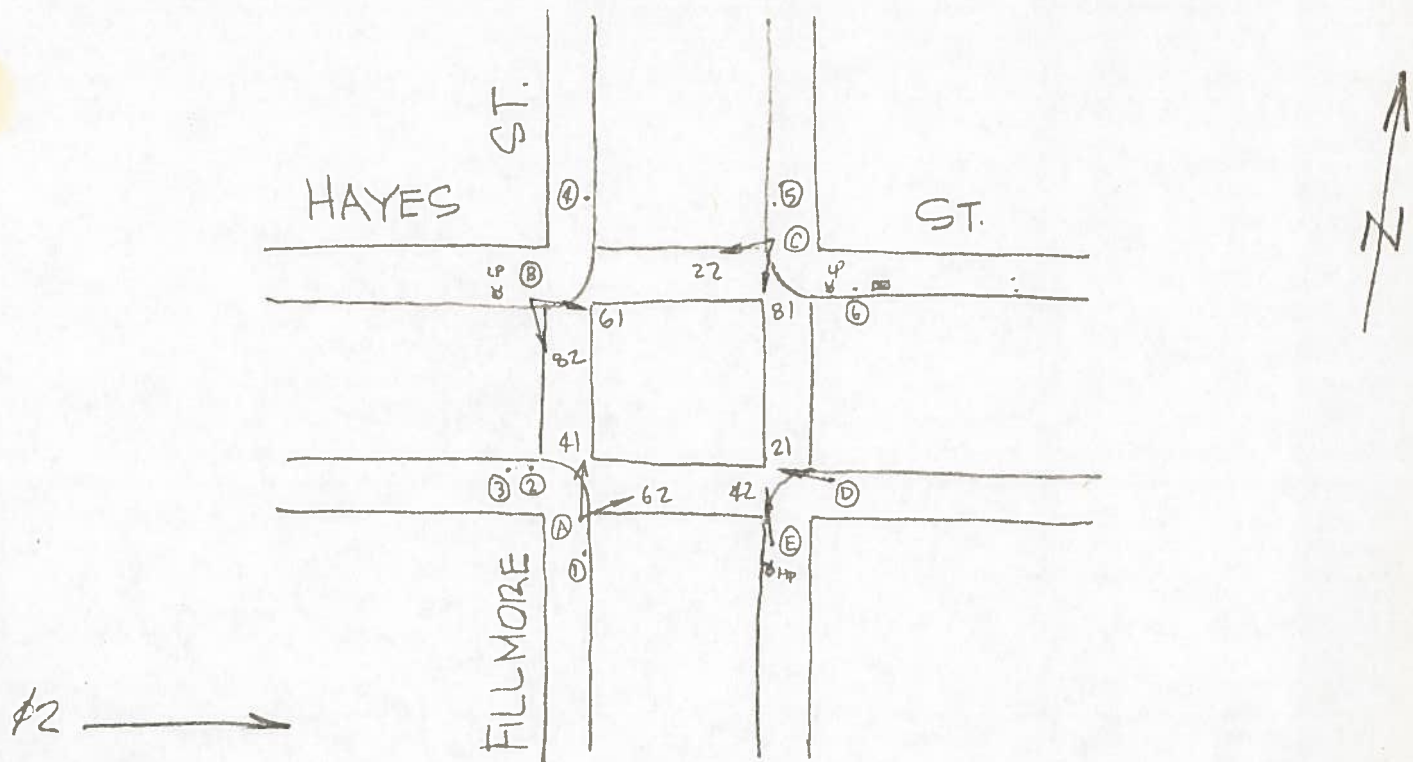

2-28-70

POLE	FUNC.	MAT'L	SIGNAL NO.	MAKE	NO. OF SECT.	SIZE	VISOR	B.P. OR LOUVERS	MOUN'T	PED SIGNAL NO.	LEGEND	MESSAGE		MAKE	MOUN'T
												ELEMENT	COLOR		
A	S	C	62	EC	3	8"	FL 8"	NO	T						
B	L	C	41	EC	3	8"	FL 8"	NO	T						
C	L	C	82	EC	3	8"	FL 8"	NO	S						
D	M	S	61	EC	3	8"	FL 8"	NO	S						
E	M	S	22	EC	3	8"	FL 8"	NO	S						
			81	EC	3	8"	FL 8"	NO	S						
			21	EC	3	8"	FL 8"	NO	S						
			42	EC	3	8"	FL 8"	N	S						
1	U	S													
2	U	W													
3	M	S													
4	U	S													
5	M	S													
6	M	S													

CONTROLLER CABINET SIZE : ORDINARY BASE CABINET: YES
COMMENTS :