


BLVD.

[illegible]

COMMENTS : Replaced existing LS186 controller and STD cabinet with 2070 controller MSF cabinet with adapter plate, per SRC 2022-193. --N.Kobayashi

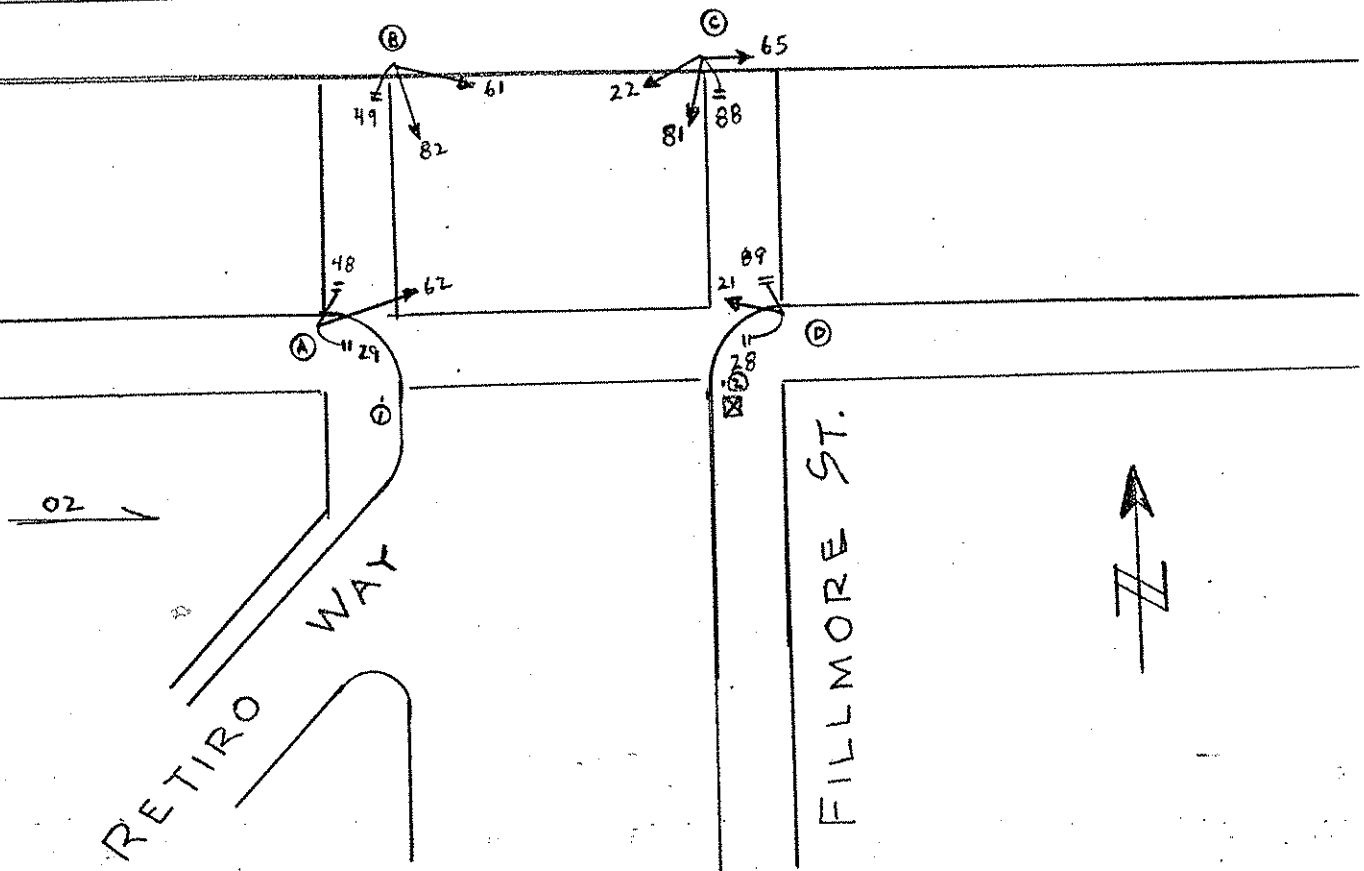