




POLE AND EQUIPMENT SCHEDULE											
POLE No.	TYPE OF POLE	LUMINAIRE VOLTAGE/ WATTAGE	VEHICLE SIGNAL					PEDESTRIAN SIGNAL			REMARKS
			No.	TYPE	MOUNTING	VISORS	LOUVERS	No.	TYPE	MOUNTING	
①	MUNI/STREET LIGHT	108W LED	81	3S12"	SV-1-T	T		69	1S-COUNT	SP-1-T	EXTERNAL CONDUIT
②	1-A (13')		22	3S12"	TV-1-T	T					APS-2W
③	1-A (13')		21	3S12"	TV-1-T	T		28	1S-COUNT	SP-1	APS-2W
④	MUNI		42	3S12"	SV-1-T	T					EXTERNAL CONDUIT
⑤	1-A (10')		41	3S12"	TV-1-T	T		48	1S-COUNT	SP-1	APS-2W
⑥	1-A (7')							29	1S-COUNT	TP-1	APS-2W
⑦	CITY STANDARD STREET LIGHT	108W LED						68	1S-COUNT	SP-1	TSP EQUIPMENT APS-2W
⑧	MUNI		82	3S12"	SV-1-T	T		49	1S-COUNT	SP-1-T	EXTERNAL CONDUIT
⑨	PPB POLE										APS-2W

1	02/05/22	INSTALL APS (SRC 2021-138). PER AS BUILT: UPDATED CONDUIT LABELS	ELuu	GdeLeon	
0	6/19/18	CONVERTED FROM 2774J WALKFIRST NEW SIGNAL #1 PROJECT CONTRACT PLANS	CLeung	KKwong/MVelasco	
NO.	DATE	DESCRIPTION	BY	APPROVED	
TABLE OF REVISIONS					
CHECKOUT DRAWING THROUGH THE SID CUSTODIAN FOR THE LATEST REVISION					

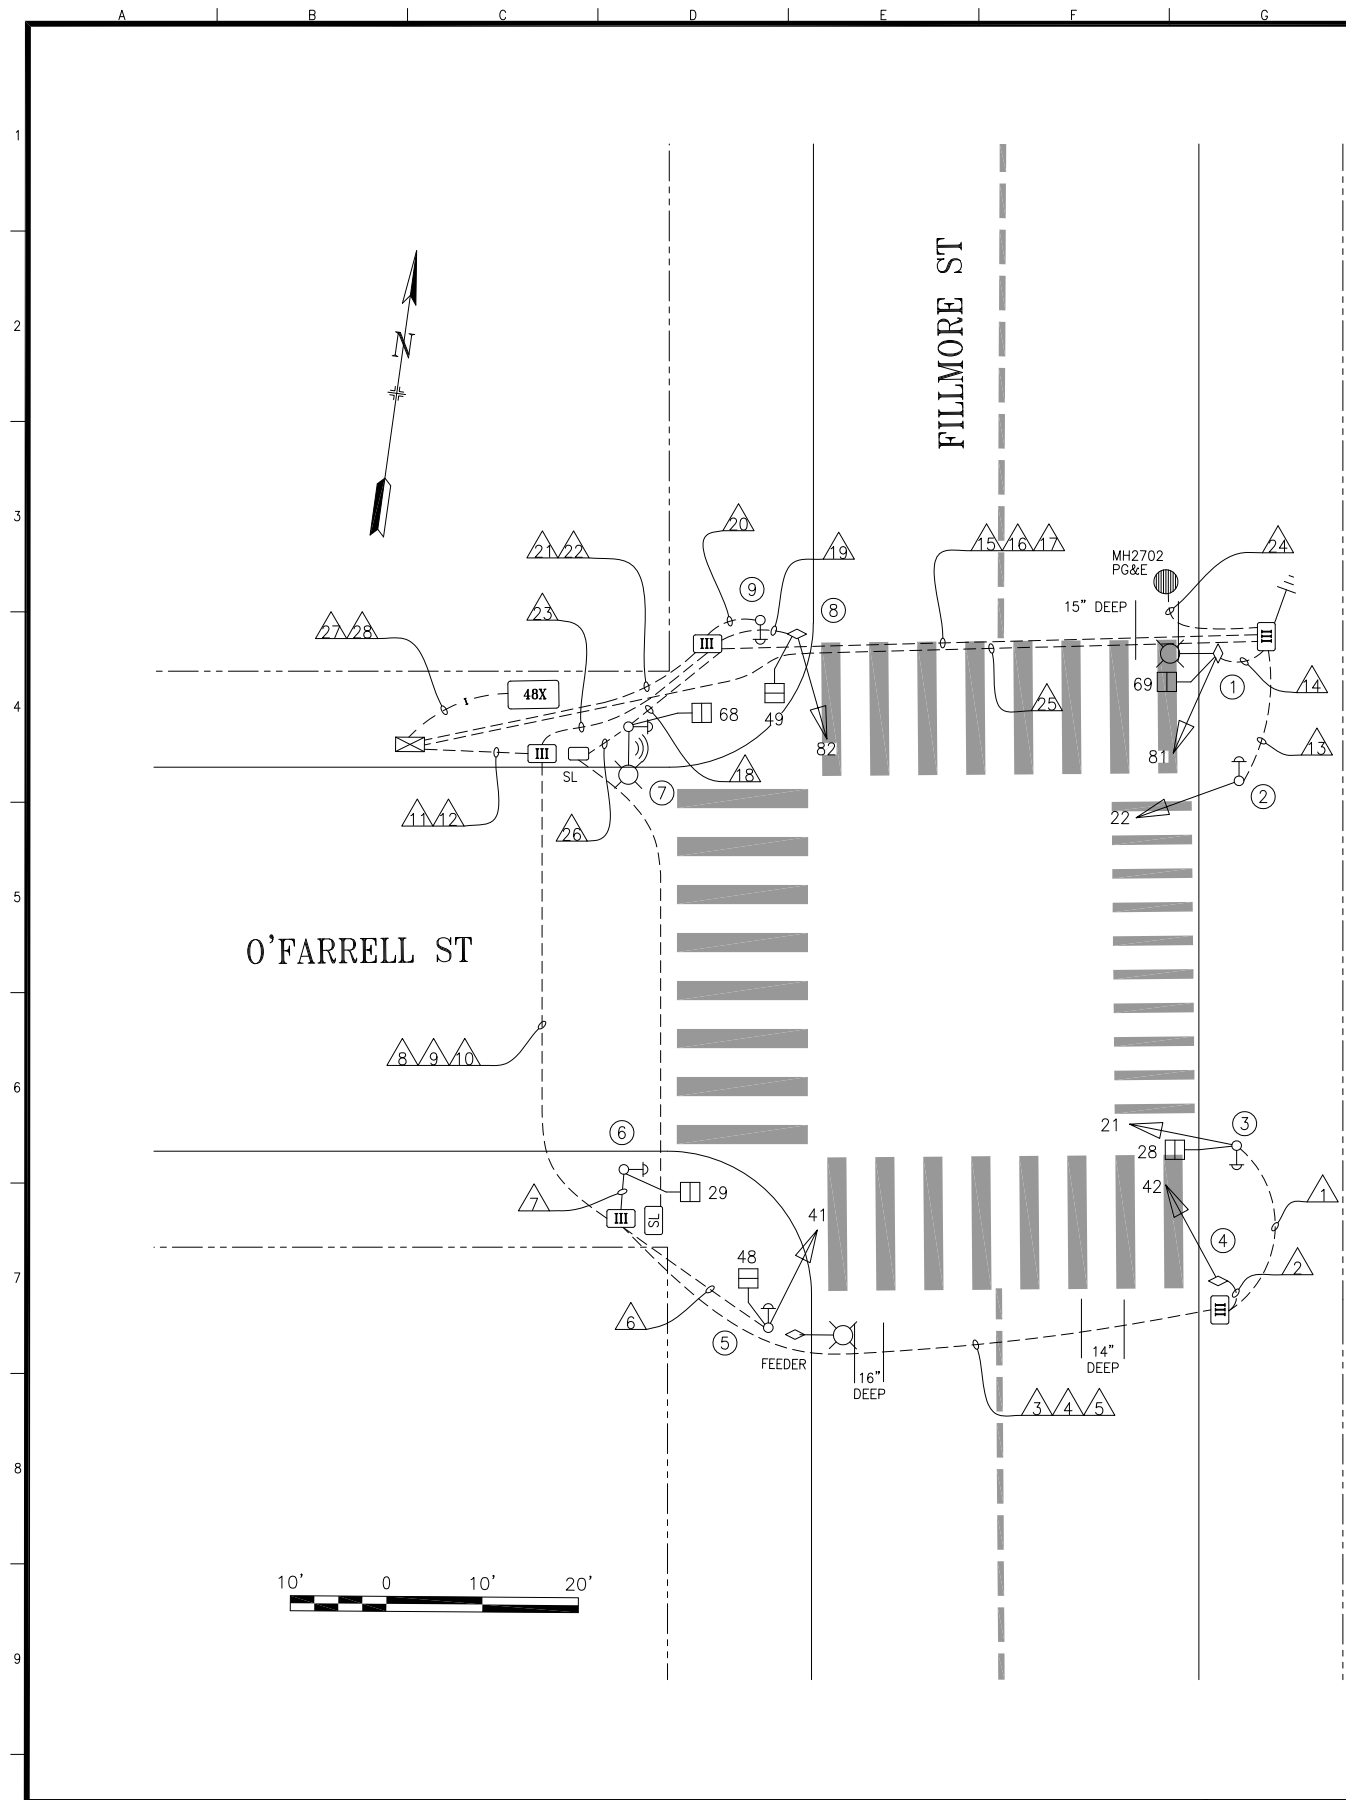

SFMTA

DRAWN BY:		DATE:	
CLeung		7/2020	
CHECKED BY:		DATE:	
KKwong/MVelasco		7/2020	

SCALE
AS SHOWN
SHEET OF SHEETS
1 OF 2

TRAFFIC SIGNAL INVENTORY DIAGRAM
FILLMORE STREET AND O'FARRELL STREET

CNN NO:
26589000
REV NO:
1

EXTERNAL REFERENCES:
FONTS USED:
SCALE FACTOR: 1=1
PLOT SCALE:
ORIGIN:
FILE NAME:
DATE:

