


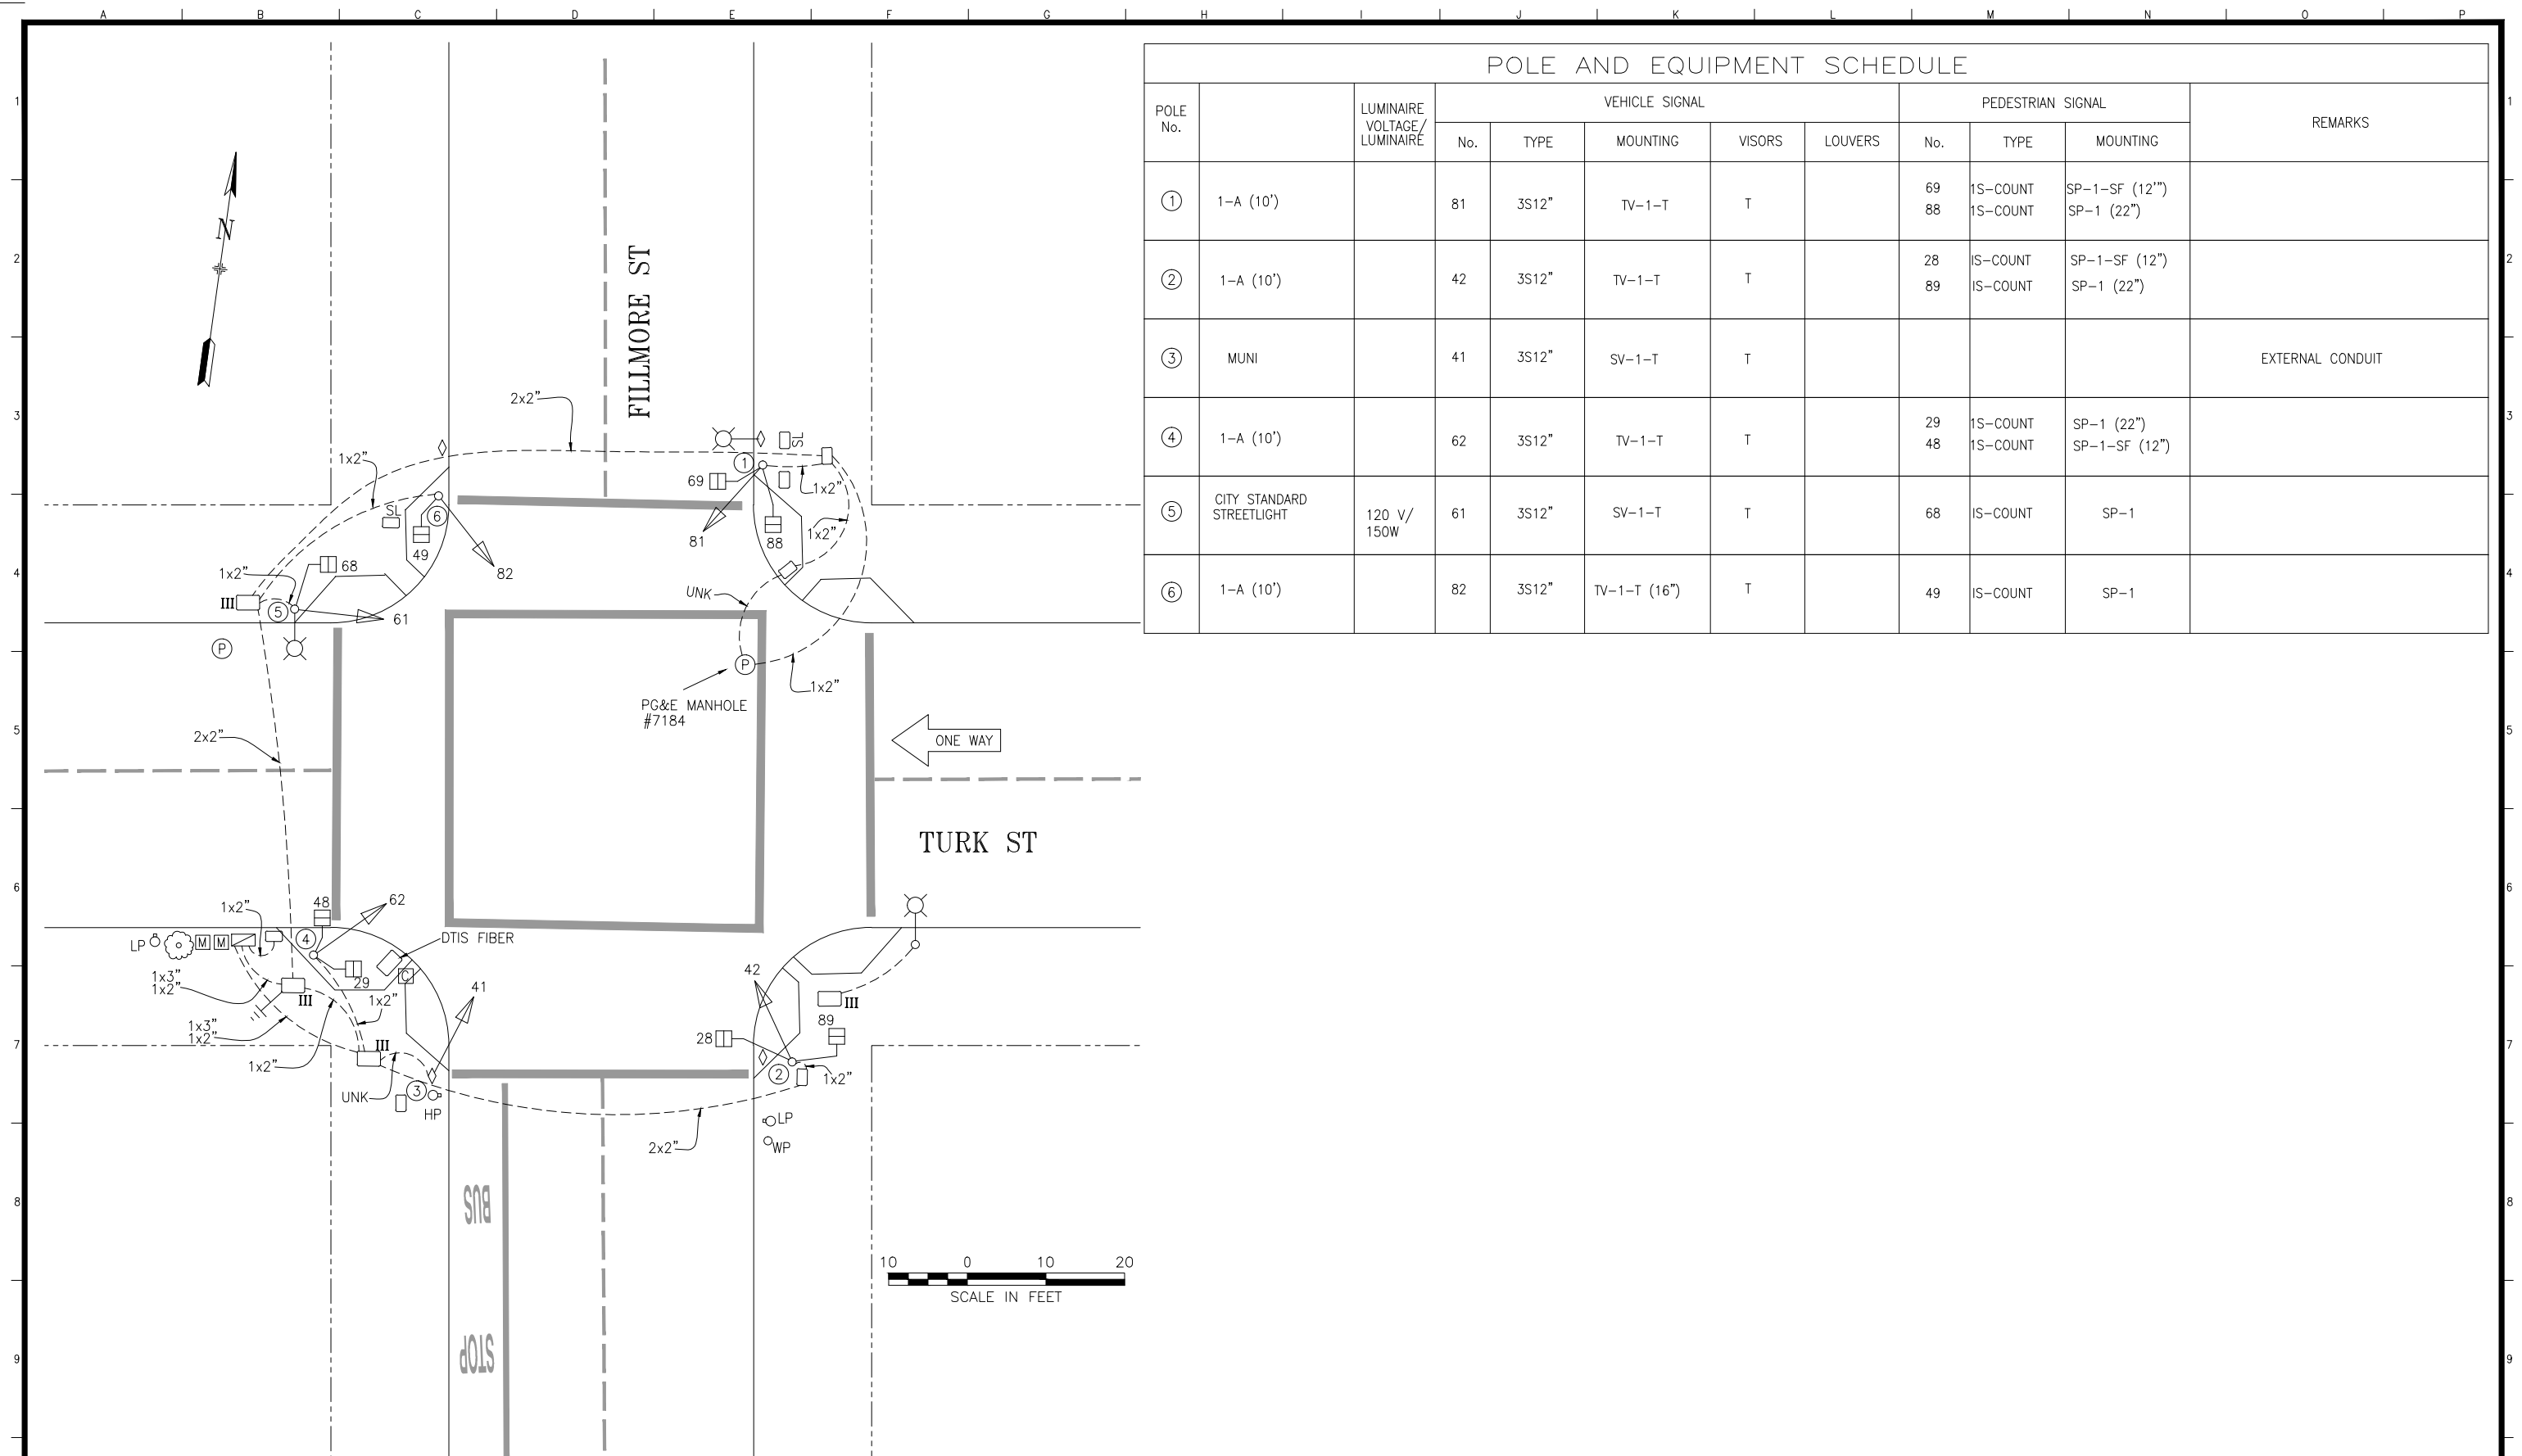

POLE AND EQUIPMENT SCHEDULE											
POLE No.		LUMINAIRE VOLTAGE/ LUMINAIRE	VEHICLE SIGNAL					PEDESTRIAN SIGNAL			REMARKS
			No.	TYPE	MOUNTING	VISORS	LOUVERS	No.	TYPE	MOUNTING	
①	1-A (10')		81	3S12"	TV-1-T	T		69 88	1S-COUNT 1S-COUNT	SP-1-SF (12") SP-1 (22")	
②	1-A (10')		42	3S12"	TV-1-T	T		28 89	1S-COUNT 1S-COUNT	SP-1-SF (12") SP-1 (22")	
③	MUNI		41	3S12"	SV-1-T	T					EXTERNAL CONDUIT
④	1-A (10')		62	3S12"	TV-1-T	T		29 48	1S-COUNT 1S-COUNT	SP-1 (22") SP-1-SF (12")	
⑤	CITY STANDARD STREETLIGHT	120 V/ 150W	61	3S12"	SV-1-T	T		68	1S-COUNT	SP-1	
⑥	1-A (10')		82	3S12"	TV-1-T (16")	T		49	1S-COUNT	SP-1	

[illegible]

COMPLETION DATE /
ELECTRICIAN INITIAL



SAN FRANCISCO MUNICIPAL TRANSPORTATION AGENCY
TRANSPORTATION ENGINEERING
CITY AND COUNTY OF SAN FRANCISCO

DRAWN: AScales	DATE: 07/06/2015	SCALE: AS SHOWN	TRAFFIC SIGNAL INVENTORY DIAGRAM	CNN NO. 25973000
CHECKED: MVelasco	DATE: 07/2015	SHEET OF SHEETS 1 OF 1	FILLMORE STREET AND TURK STREET	REV. NO. 0