


UNION & FILLMORE

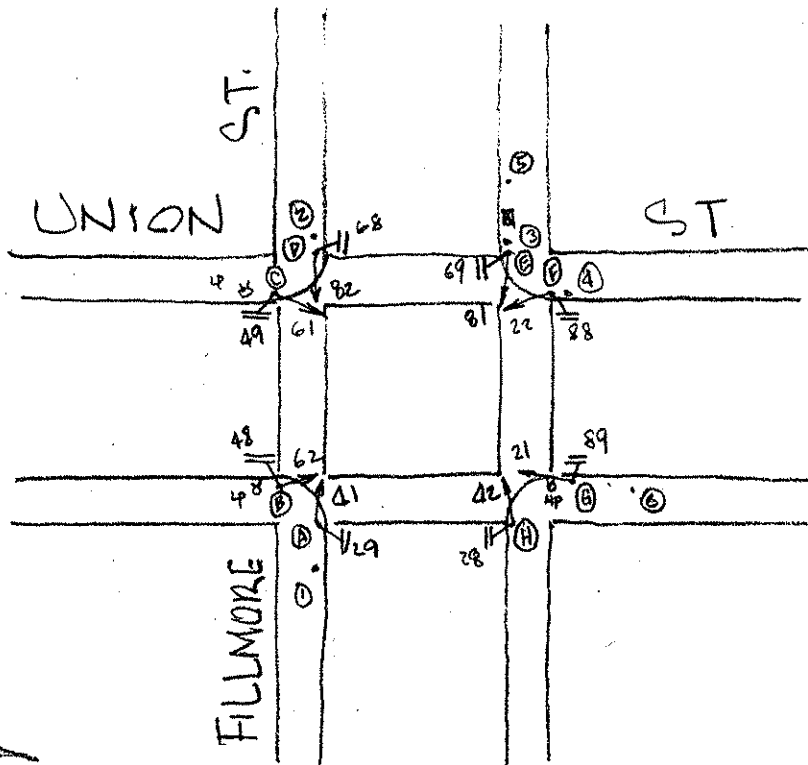

POLE	FUNC.	MAT'L	SIGNAL NO.	MAKE	NO. OF SECT.	SIZE	VISOR	B.P. OR LOUVERS	MOUN'T	PED SIGNAL NO.	LEGEND	MESSAGE		MAKE	MOUN'T
												ELEMENT	COLOR		
A	S	C	48	EA	3	8"	FC 8"	No	T	29	I	IS-1	OR/WH	ICC	S
B	S	C	62	EA	3	8"	FC 8"	No	T	48	I	IS-1	OR/WH	ICC	S
C	S	C	61	GA	3	8"	FC 8"	No	T	49	I	IS-1	OR/WH	ICC	S
D	S	C	82	EA	3	8"	FC 8"	No	T	68	I	IS-1	OR/WH	ICC	S
E	S	C	81	EA	3	8"	FC 8"	No	T	69	I	IS-1	OR/WH	ICC	S
F	S	C	22	TCT	3	8"	FC 8"	No	T	88	I	IS-1	OR/WH	ICC	S
G	S	C	21	EA	3	8"	FC 8"	No	T	89	I	IS-1	OR/WH	ICC	S
H	M	S	42	TCT	3	8"	FC 8"	No	S	28	I	IS-1	OR/WH	ICC	S
1	M	S													
2	M	S													
3	U	W													
4	M	S													
5	M	S													
6	M	S													

CONTROLLER CABINET SIZE : ORDINARY BASE CABINET: YES

COMMENTS : NEW MUNI POLE H AND NEW SIGNALS 28 & 42 WERE
INSTALLED UNDER NO. 30 STOCKTON LINE CONTRACT
MR-888