


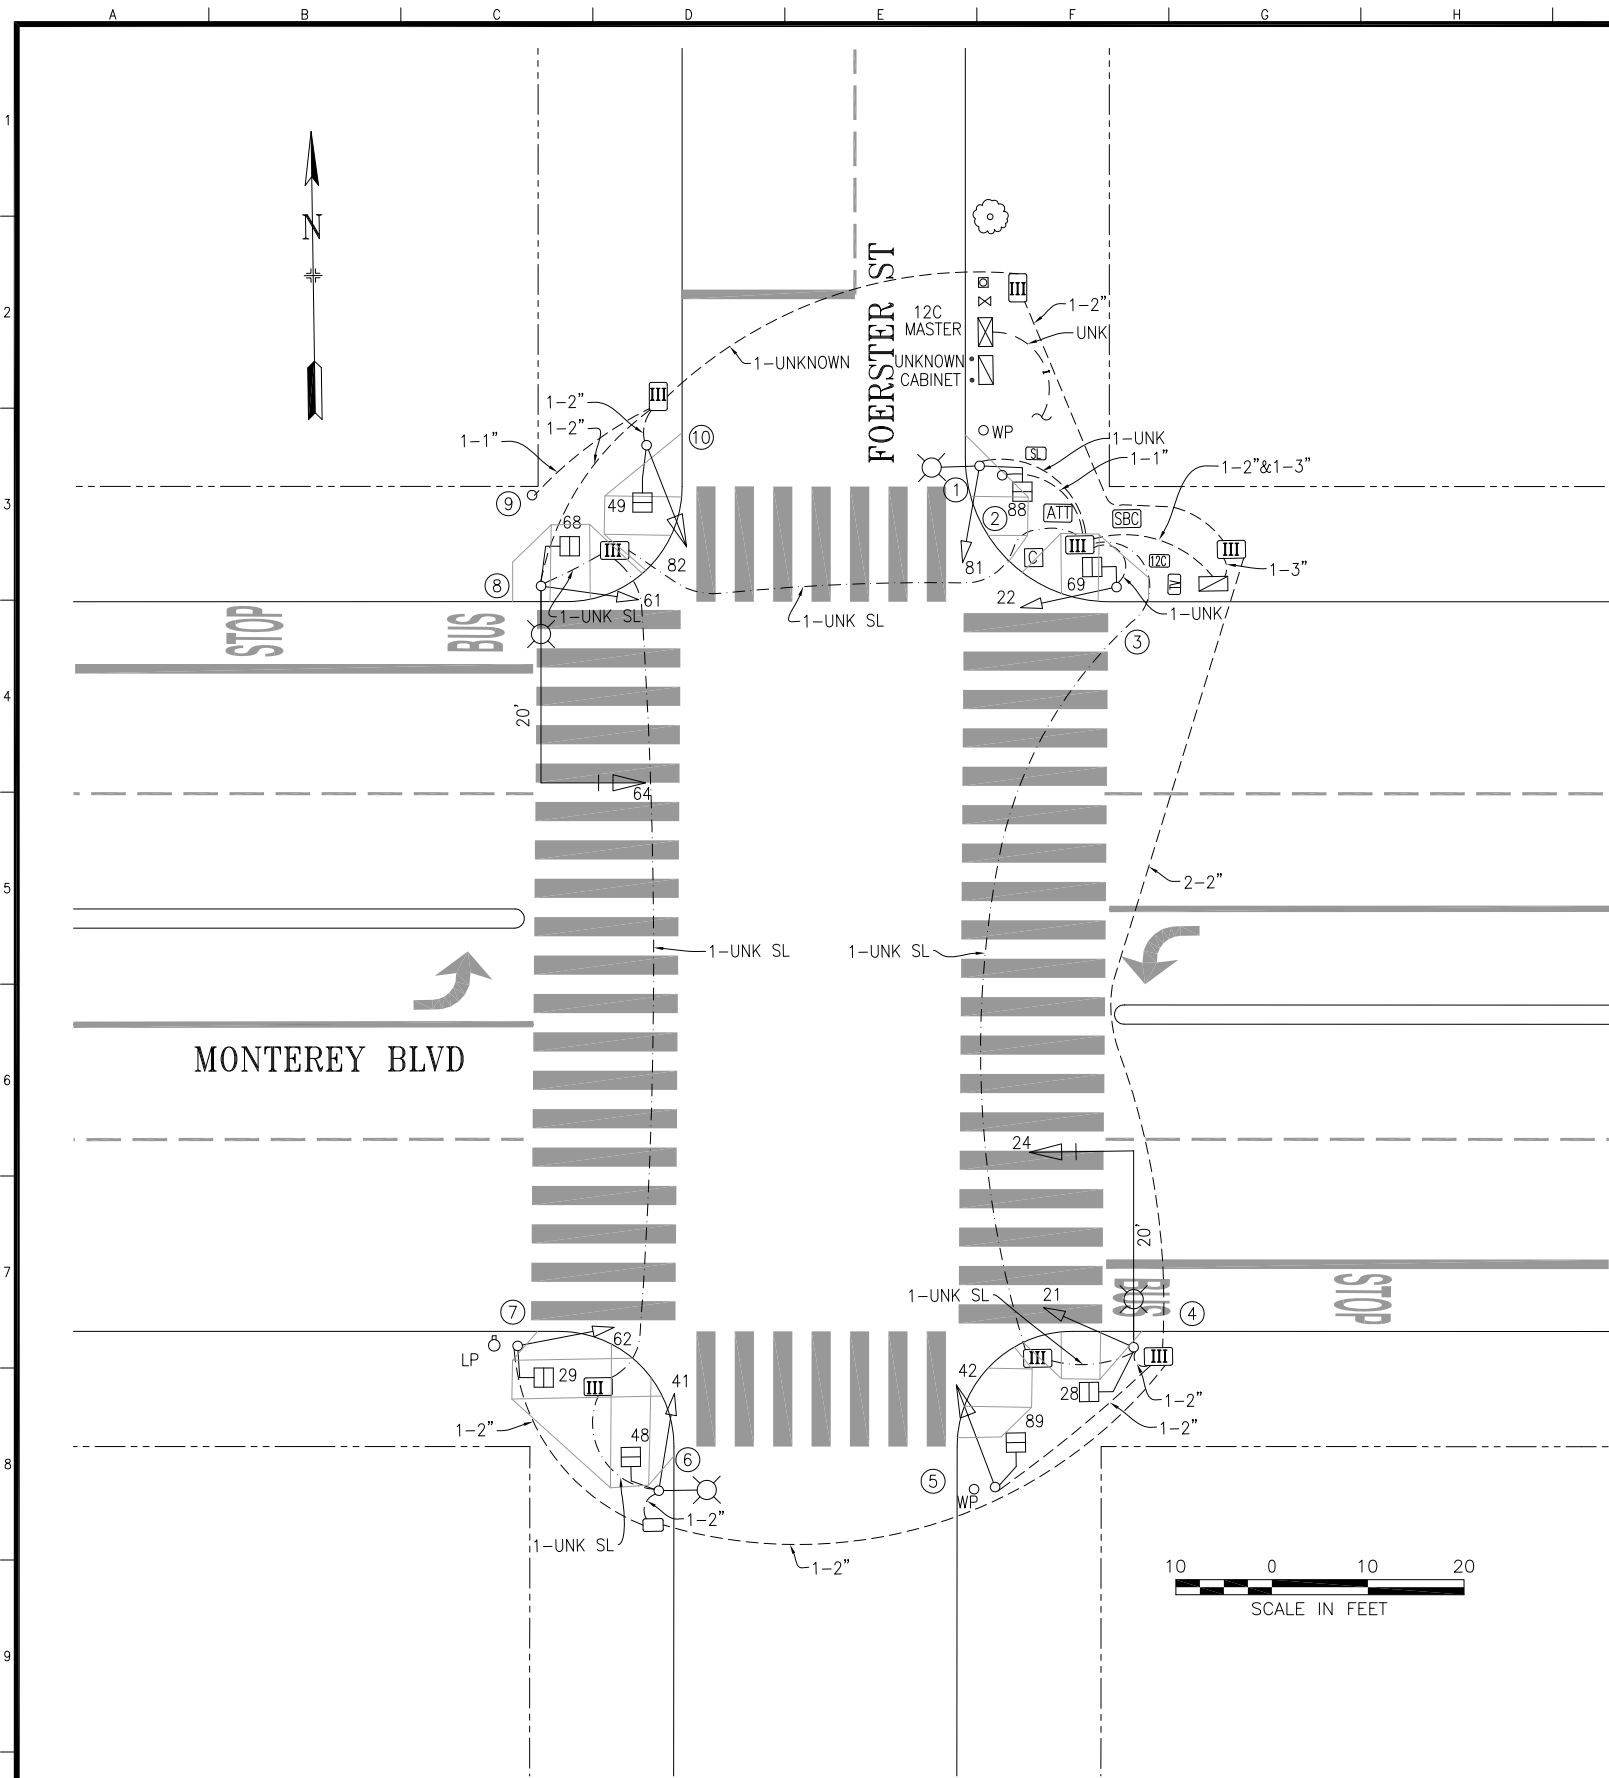

POLE AND EQUIPMENT SCHEDULE											
POLE No.	TYPE OF POLE	LUMINAIRE VOLTAGE/ WATTAGE	VEHICLE SIGNAL					PEDESTRIAN SIGNAL			REMARKS
			No.	TYPE	MOUNTING	VISORS	LOUVERS	No.	TYPE	MOUNTING	
①	MARBELITE SL W/ 6' LA		81	3S8"	SV-1	T		88	1S-COUNT	SP-1	
②	PPBP										
③	MARBELITE (10')		22	3S8"	TV-1	T		69	1S-COUNT	SP-1	
④	19-1-100 W/ 20' MA & 6' LA		21 24	3S8" 3S12"	SV-1-T MAS	T T		28	1S-COUNT	SP-1	BACKPLATE
⑤	1-A (10')		42	3S12"	TV-1-T	T		89	1S-COUNT	SP-1	
⑥	MARBELITE SL W/ 6' LA		41	3S8"	SV-1	T		48	1S-COUNT	SP-1	
⑦	MARBELITE (10')		62	3S8"	TV-1	T		29	1S-COUNT	SP-1	
⑧	19-1-100 W/ 20' MA & 6' LA		61 64	3S8" 3S12"	SV-1-T MAS	T T		68	1S-COUNT	SP-1	BACKPLATE
⑨	PPBP										
⑩	1-A (13')		82	3S12"	TV-1-T	T		49	1S-COUNT	SP-1	

TABLE OF REVISIONS				
NO.	DATE	DESCRIPTION	BY	APP.
2	2/27/17	NEW POLES 2,9,10 PER 2821J. MINOR CHANGES TO CONDUITS PER FIELD	DYeung	SDelcor
1	5/27/16	SIGNAL #82 REPLACED WITH 3S12"	JH	ET
0	3/17/09	UPGRADED BY 0985J; CONVERTED FROM AS-BUILTS	JH	ET

CHECK WITH TRACING TO SEE IF YOU HAVE LATEST REVISION

REFERENCE INFORMATION & FILE NO. OF SURVEYS



SAN FRANCISCO MUNICIPAL TRANSPORTATION AGENCY

CITY AND COUNTY OF SAN FRANCISCO

DRAWN:	DATE:
DY	1/2018
CHECKED:	DATE:
GD	1/2018

SCALE:
AS SHOWN
SHEET OF SHEETS
1 OF 1

TRAFFIC SIGNAL INVENTORY DIAGRAM
FOERSTER STREET AND MONTEREY BOULEVARD

CNN NO.
22232000
REV NO.
2