


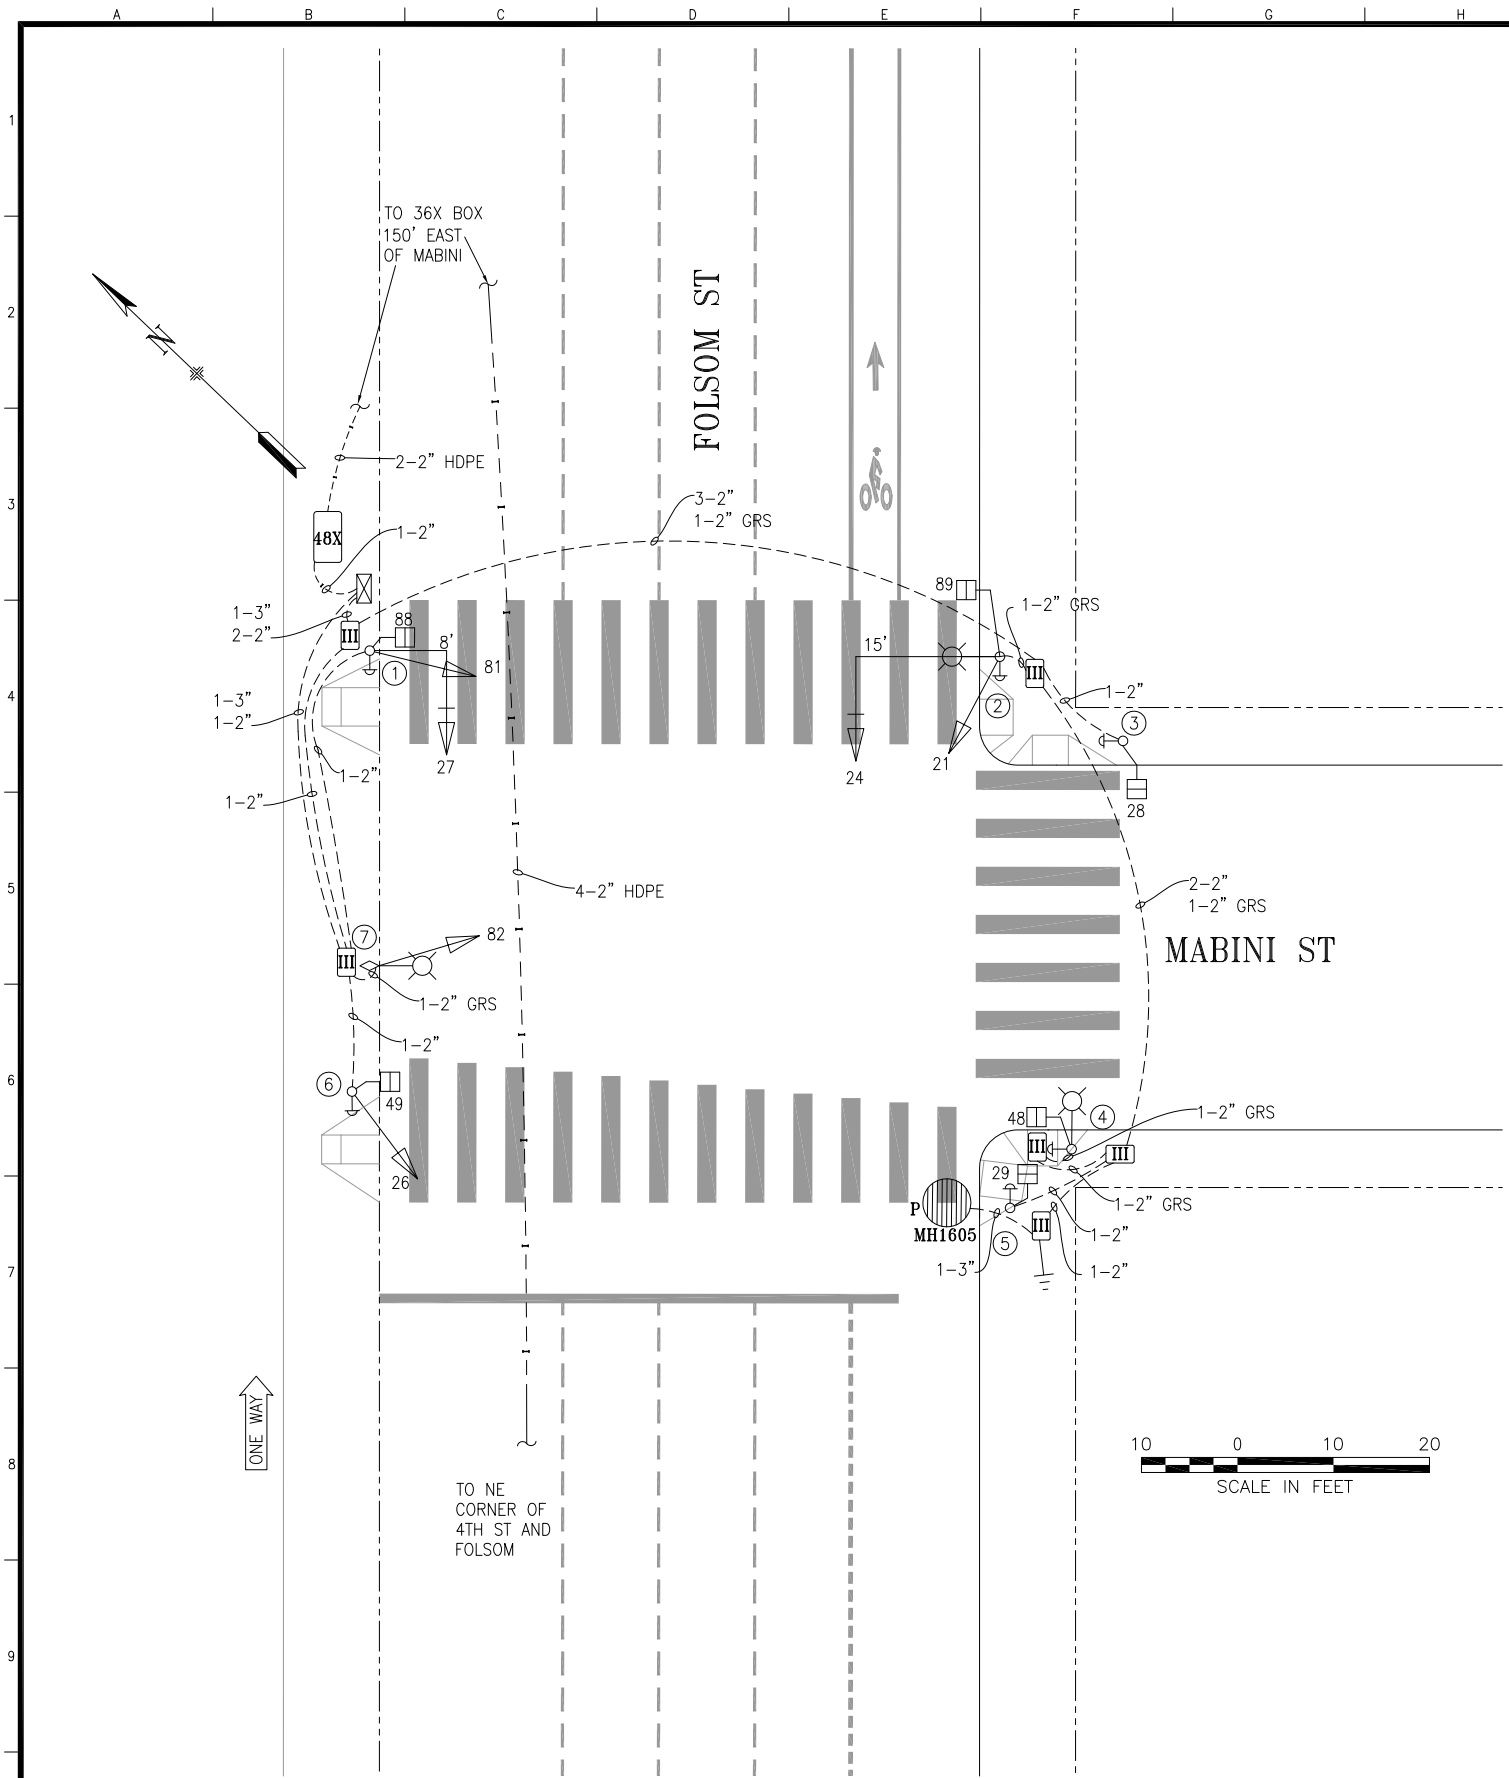


POLE AND EQUIPMENT SCHEDULE										
POLE No.	TYPE OF POLE	LUMINAIRE VOLTAGE/ WATTAGE	VEHICLE SIGNAL				PEDESTRIAN SIGNAL			REMARKS
			No.	TYPE	MOUNTING	VISORS	No.	TYPE	MOUNTING	
①	16-2-100 WITH 8' MAST ARM		27 81	3S12" 3S12"	MAS SV-1-T	T T	88	1S-COUNT	SP-1	BACKPLATE APS-2W
②	17-2-100 WITH 15' MAST ARM W/6' LUMINAIRE ARM	LED 120V/54W	21 24	3S12" 3S12"	SV-1-T MAS	T T	89	1S-COUNT	SP-1-SF (12")	APS-2W BACKPLATE
③	1-A (7')						28	1S-COUNT	TP-1	APS-2W
④	SL W/ 6' LUMINAIRE ARM	HPS 120V/100W					48	1S-COUNT	SP-1	APS-2W
⑤	1-A (7')						29	1S-COUNT	TP-1	APS-2W
⑥	1-A (10')		26	3S12"	TV-1-T	T	49	1S-COUNT	SP-1	APS-2W
⑦	MUNI POLE W/ 6' LUMINAIRE ARM	HPS 120V/250W	82	3S12"	SV-1-T	T				

SHEET NOTES:

① PLUMBIZER MOUNTED BETWEEN GREEN AND YELLOW

INTERCONNECT WIRING DETAIL

NOT TO SCALE

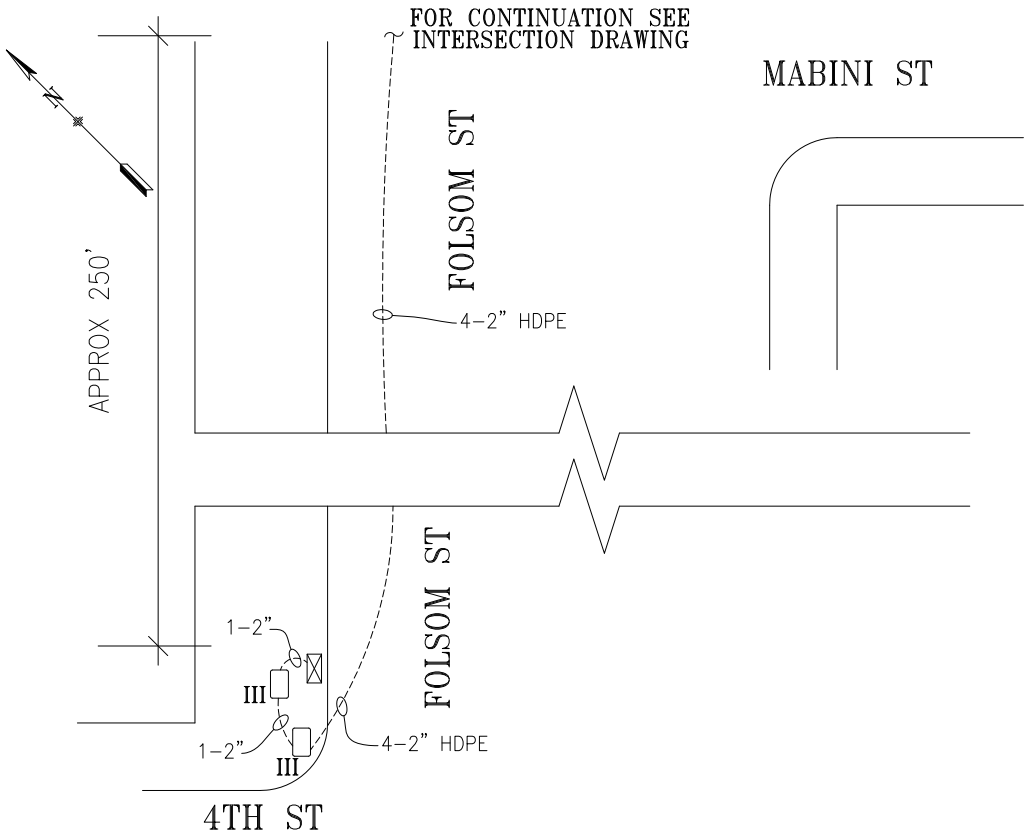

NO.	DATE	DESCRIPTION	BY	APP.
0	4/5/18	NEW SIGNAL ACTIVATED THROUGH #2772J	AScales	GDeLeon
TABLE OF REVISIONS				
CHECK WITH TRACING TO SEE IF YOU HAVE LATEST REVISION				

REFERENCE INFORMATION
& FILE NO. OF SURVEYS



SAN FRANCISCO MUNICIPAL TRANSPORTATION AGENCY
CITY AND COUNTY OF SAN FRANCISCO

DRAWN: AS
DATE: 7/5/18
CHECKED: GD
DATE: 8/3/18

SCALE:

AS SHOWN

SHEET OF SHEETS

1 OF 1

TRAFFIC SIGNAL INVENTORY DIAGRAM

FOLSOM STREET AND MABINI STREET

CNN NO.

24586000

REV NO.

0