



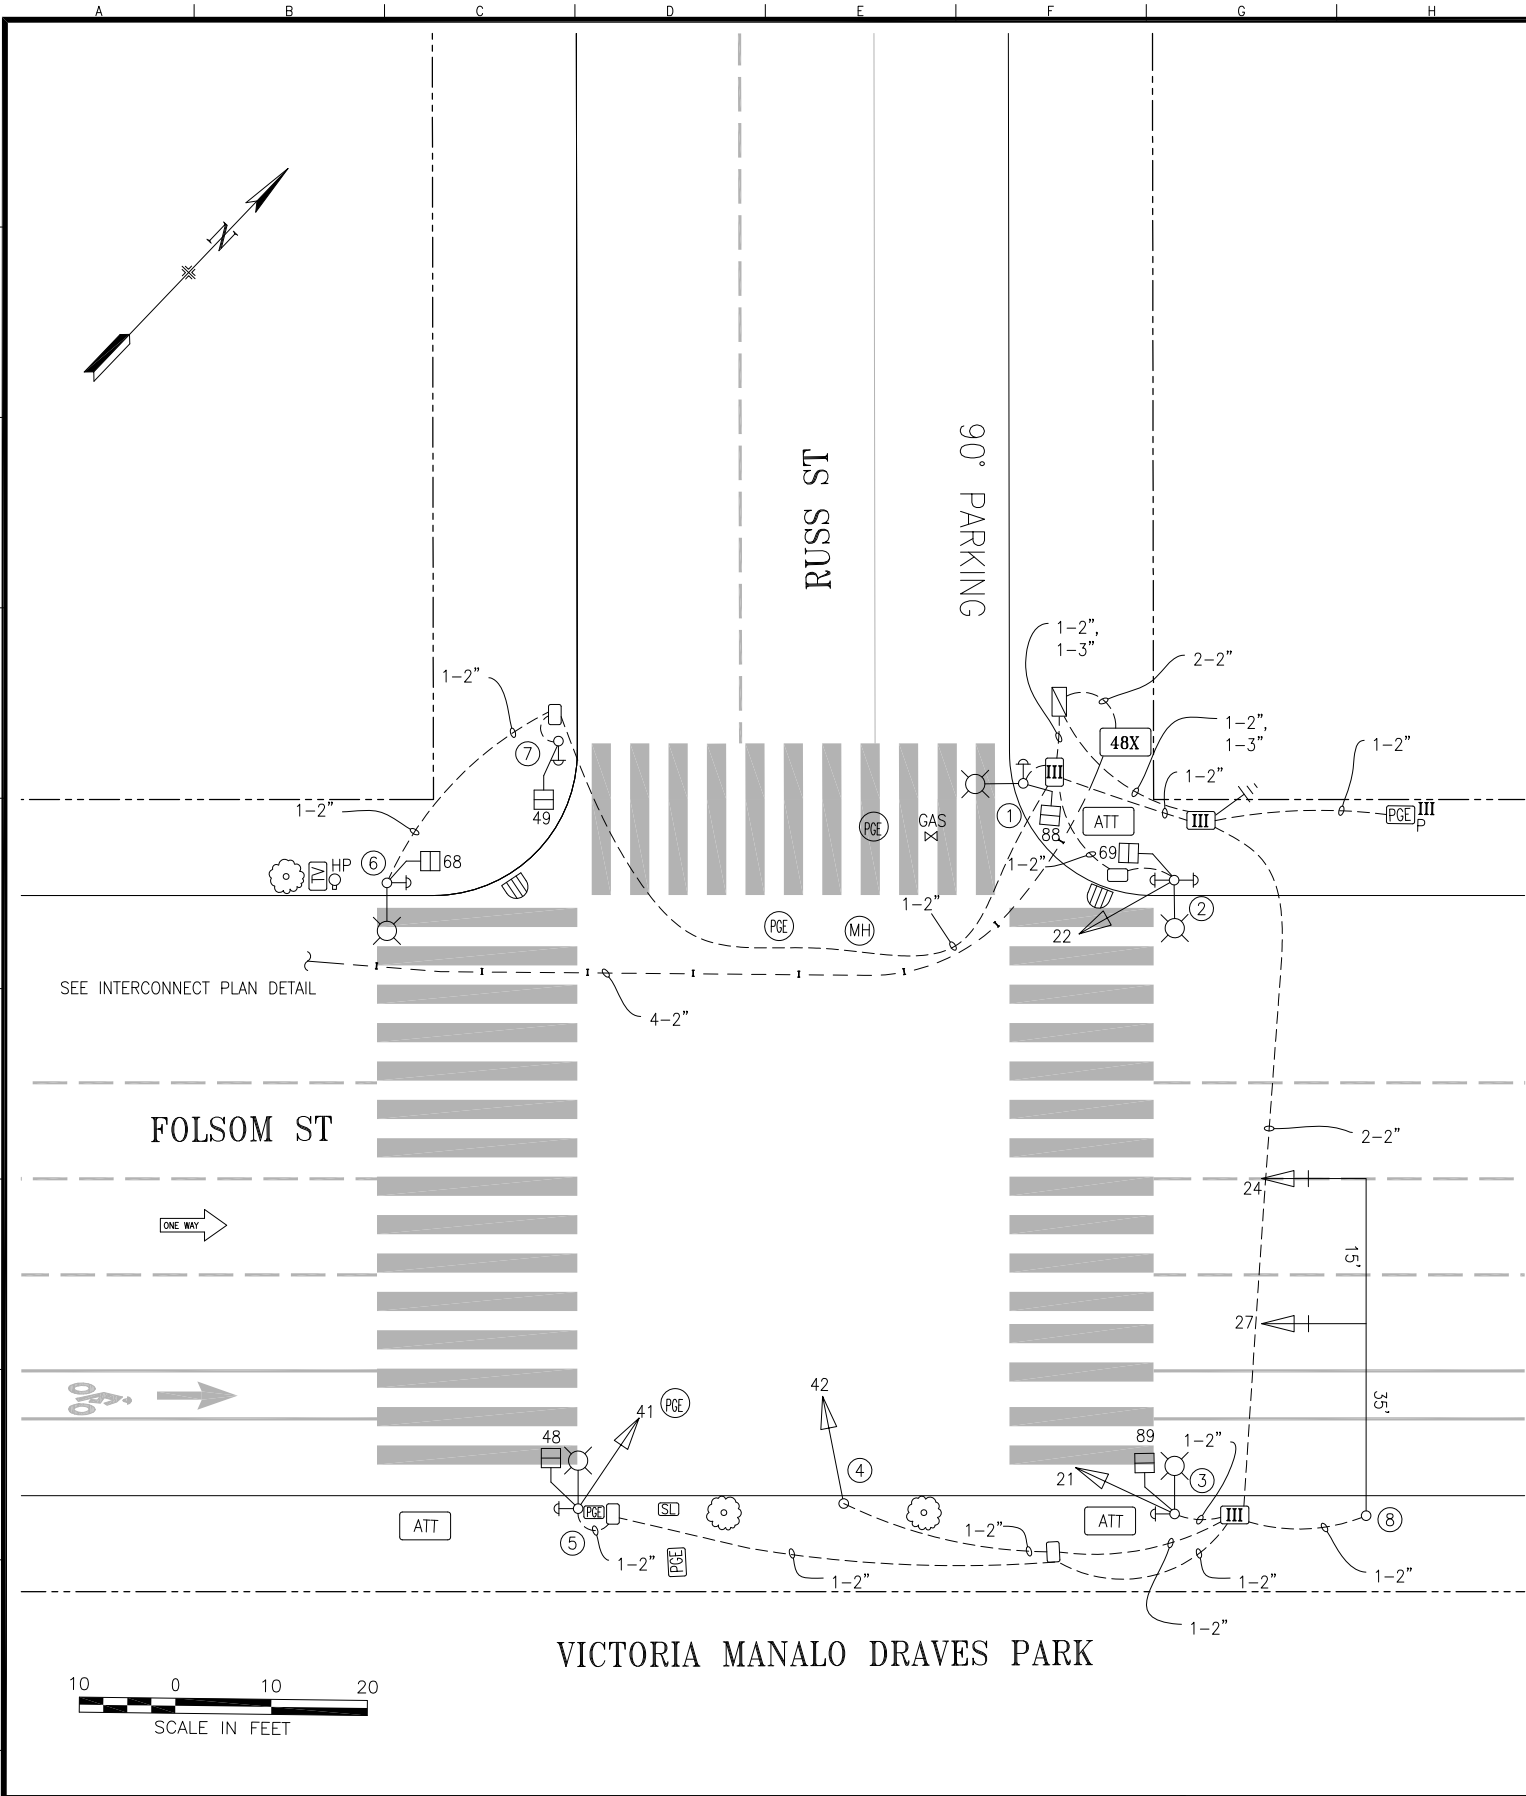


POLE AND EQUIPMENT SCHEDULE											
POLE No.	TYPE OF POLE	LUMINAIRE VOLTAGE/ WATTAGE	VEHICLE SIGNAL					PEDESTRIAN SIGNAL			REMARKS
			No.	TYPE	MOUNTING	VISORS	LOUVERS	No.	TYPE	MOUNTING	
①	CITY STANDARD STREET LIGHT	120V 250W						88	1S-COUNT	SP-1	APS
②	CITY STANDARD STREET LIGHT	120V 250W	22	3S12"	SV-1-T	T		69	1S-COUNT	SP-1	APS APS
③	19-1-100 WITH 6' LUMINAIRE	120V 250W	21	3S12"	SV-1-T	T		89	1S-COUNT	SP-1	APS
④	1-A (10')		42	3S12"	TV-1-T	T					
⑤	CITY STANDARD STREET LIGHT	120V 250W	41	3S12"	SV-1-T	T		48	1S-COUNT	SP-1	APS
⑥	CITY STANDARD STREET LIGHT	120V 250W						68	1S-COUNT	SP-1	APS
⑦	1-A (7')							49	1S-COUNT	TP-1	APS
⑧	23-3-100 WITH 35' MAST ARM		24 27	3S12" 3S12"	MAS MAS	T T					BACKPLATE BACKPLATE

INTERCONNECT PLAN DETAIL
NOT TO SCALE

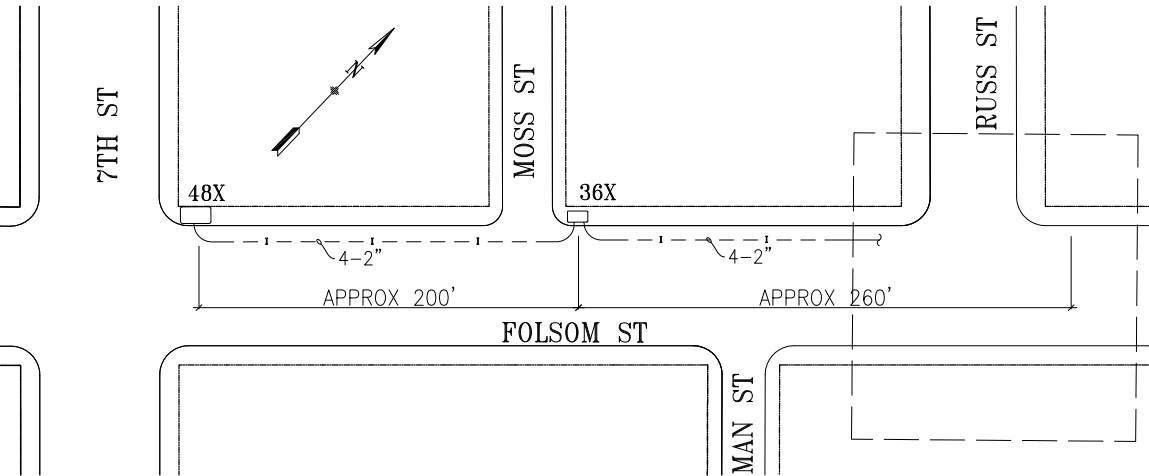

NO.	DATE	DESCRIPTION	BY	APPROVED
1	04/26/21	REMOVED ACTUATION FROM APS	A. LAM	E. TSUI
0	04/16/12	NEW SIGNAL ACTIVATED THROUGH CT 60	G. HO	G. DELEON
TABLE OF REVISIONS				
CHECKOUT DRAWING THROUGH THE SID CUSTODIAN FOR THE LATEST REVISION				

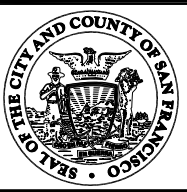

SFMTA

DRAWN BY:	DATE:
GD	12/2013
CHECKED BY:	DATE:
MV	12/2013

SCALE
AS SHOWN
SHEET OF SHEETS
1 OF 1

TRAFFIC SIGNAL INVENTORY DIAGRAM
FOLSOM ST AND RUSS ST

CNN NO:
24279000
REV NO:
1