


↑
#2

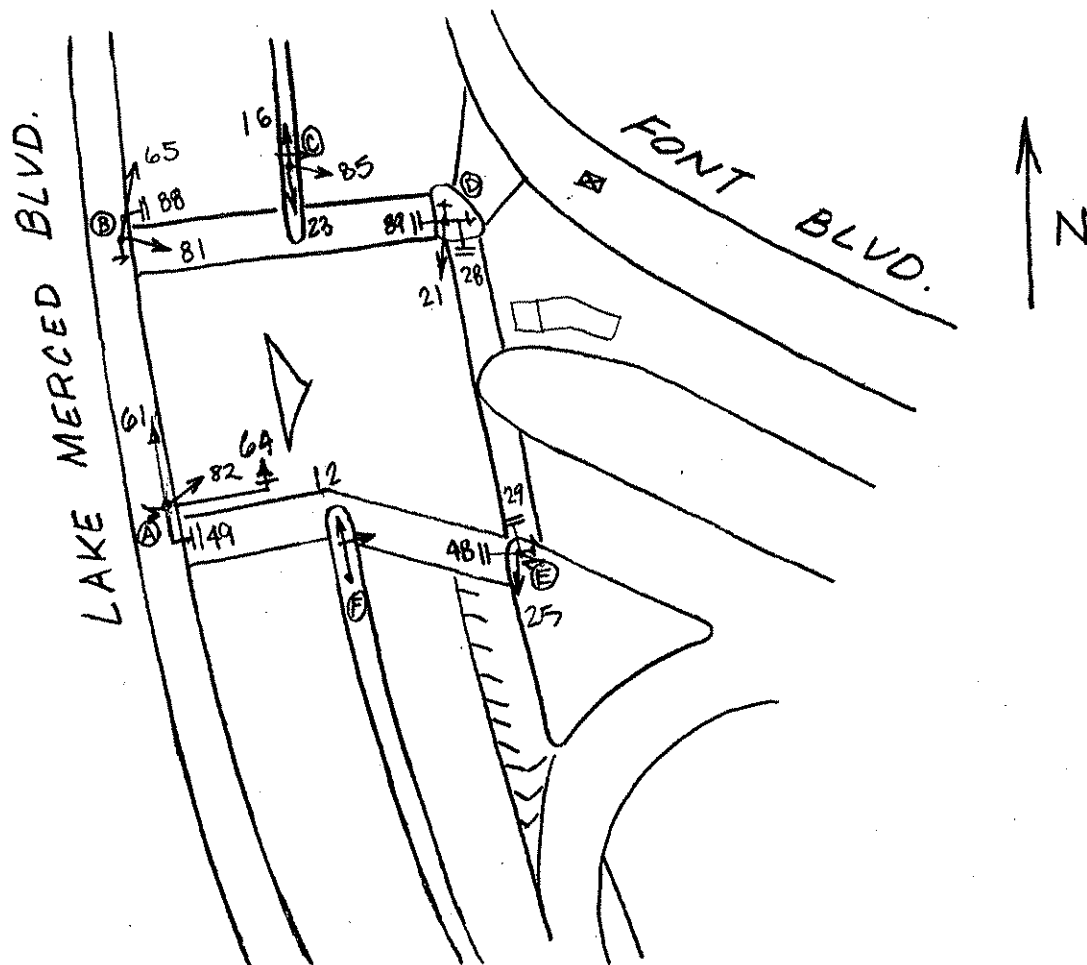

2-3-94

POLE	FUNC.	MAT'L	SIGNAL NO.	MAKE	NO. OF SECT.	SIZE	VISOR	B.P. OR LOUVERS	MOUN'T	PED SIGNAL NO.	LEGEND	MESSAGE		MAKE	MOUN'T
												ELEMENT	COLOR		
A	S	C	61	EC	3	12" R 8" Y, G	FC 12" FC 8"	-	S	49	I	15-1	w/or	ICC	S
B	S	C	81	EC	3	8"	FC 8"	-	T	88	I	15-1	w/or	ICC	S
C	L	C	23	EC	3	12" R 8" G+Y	FC 12" FC 8"	-	S	89	I	15-1	w/or	ICC	S
D	S	C	85	EC	3	8"	FC 8"	-	S	28	I	15-1	w/or	ICC	S
E	S	C	16	TCT	3	12" R Y G	FC 12"	-	S	29	I	15-1	w/or	ICC	S
F	L	C	21	EC	3	12" R 8" G+Y	FC 12" FC 8"	-	T	48	I	15-1	w/or	ICC	S
			25	EC	3	12" R 8" G+Y	FC 12" FC 8"	-	T						
			64	TCT	3	12"	FC 12"	B.P.	T						
			12	TCT	3	12" R Y G	FC 12"	-	S						
			82	TCT	3	8"	FC 8"	-	S						
			65	EC	3	12" R 8" YG	FC 12" FC 8"	-	T						

CONTROLLER CABINET SIZE : LARGE BASE CABINET: YES

COMMENTS: CONTACT 21