


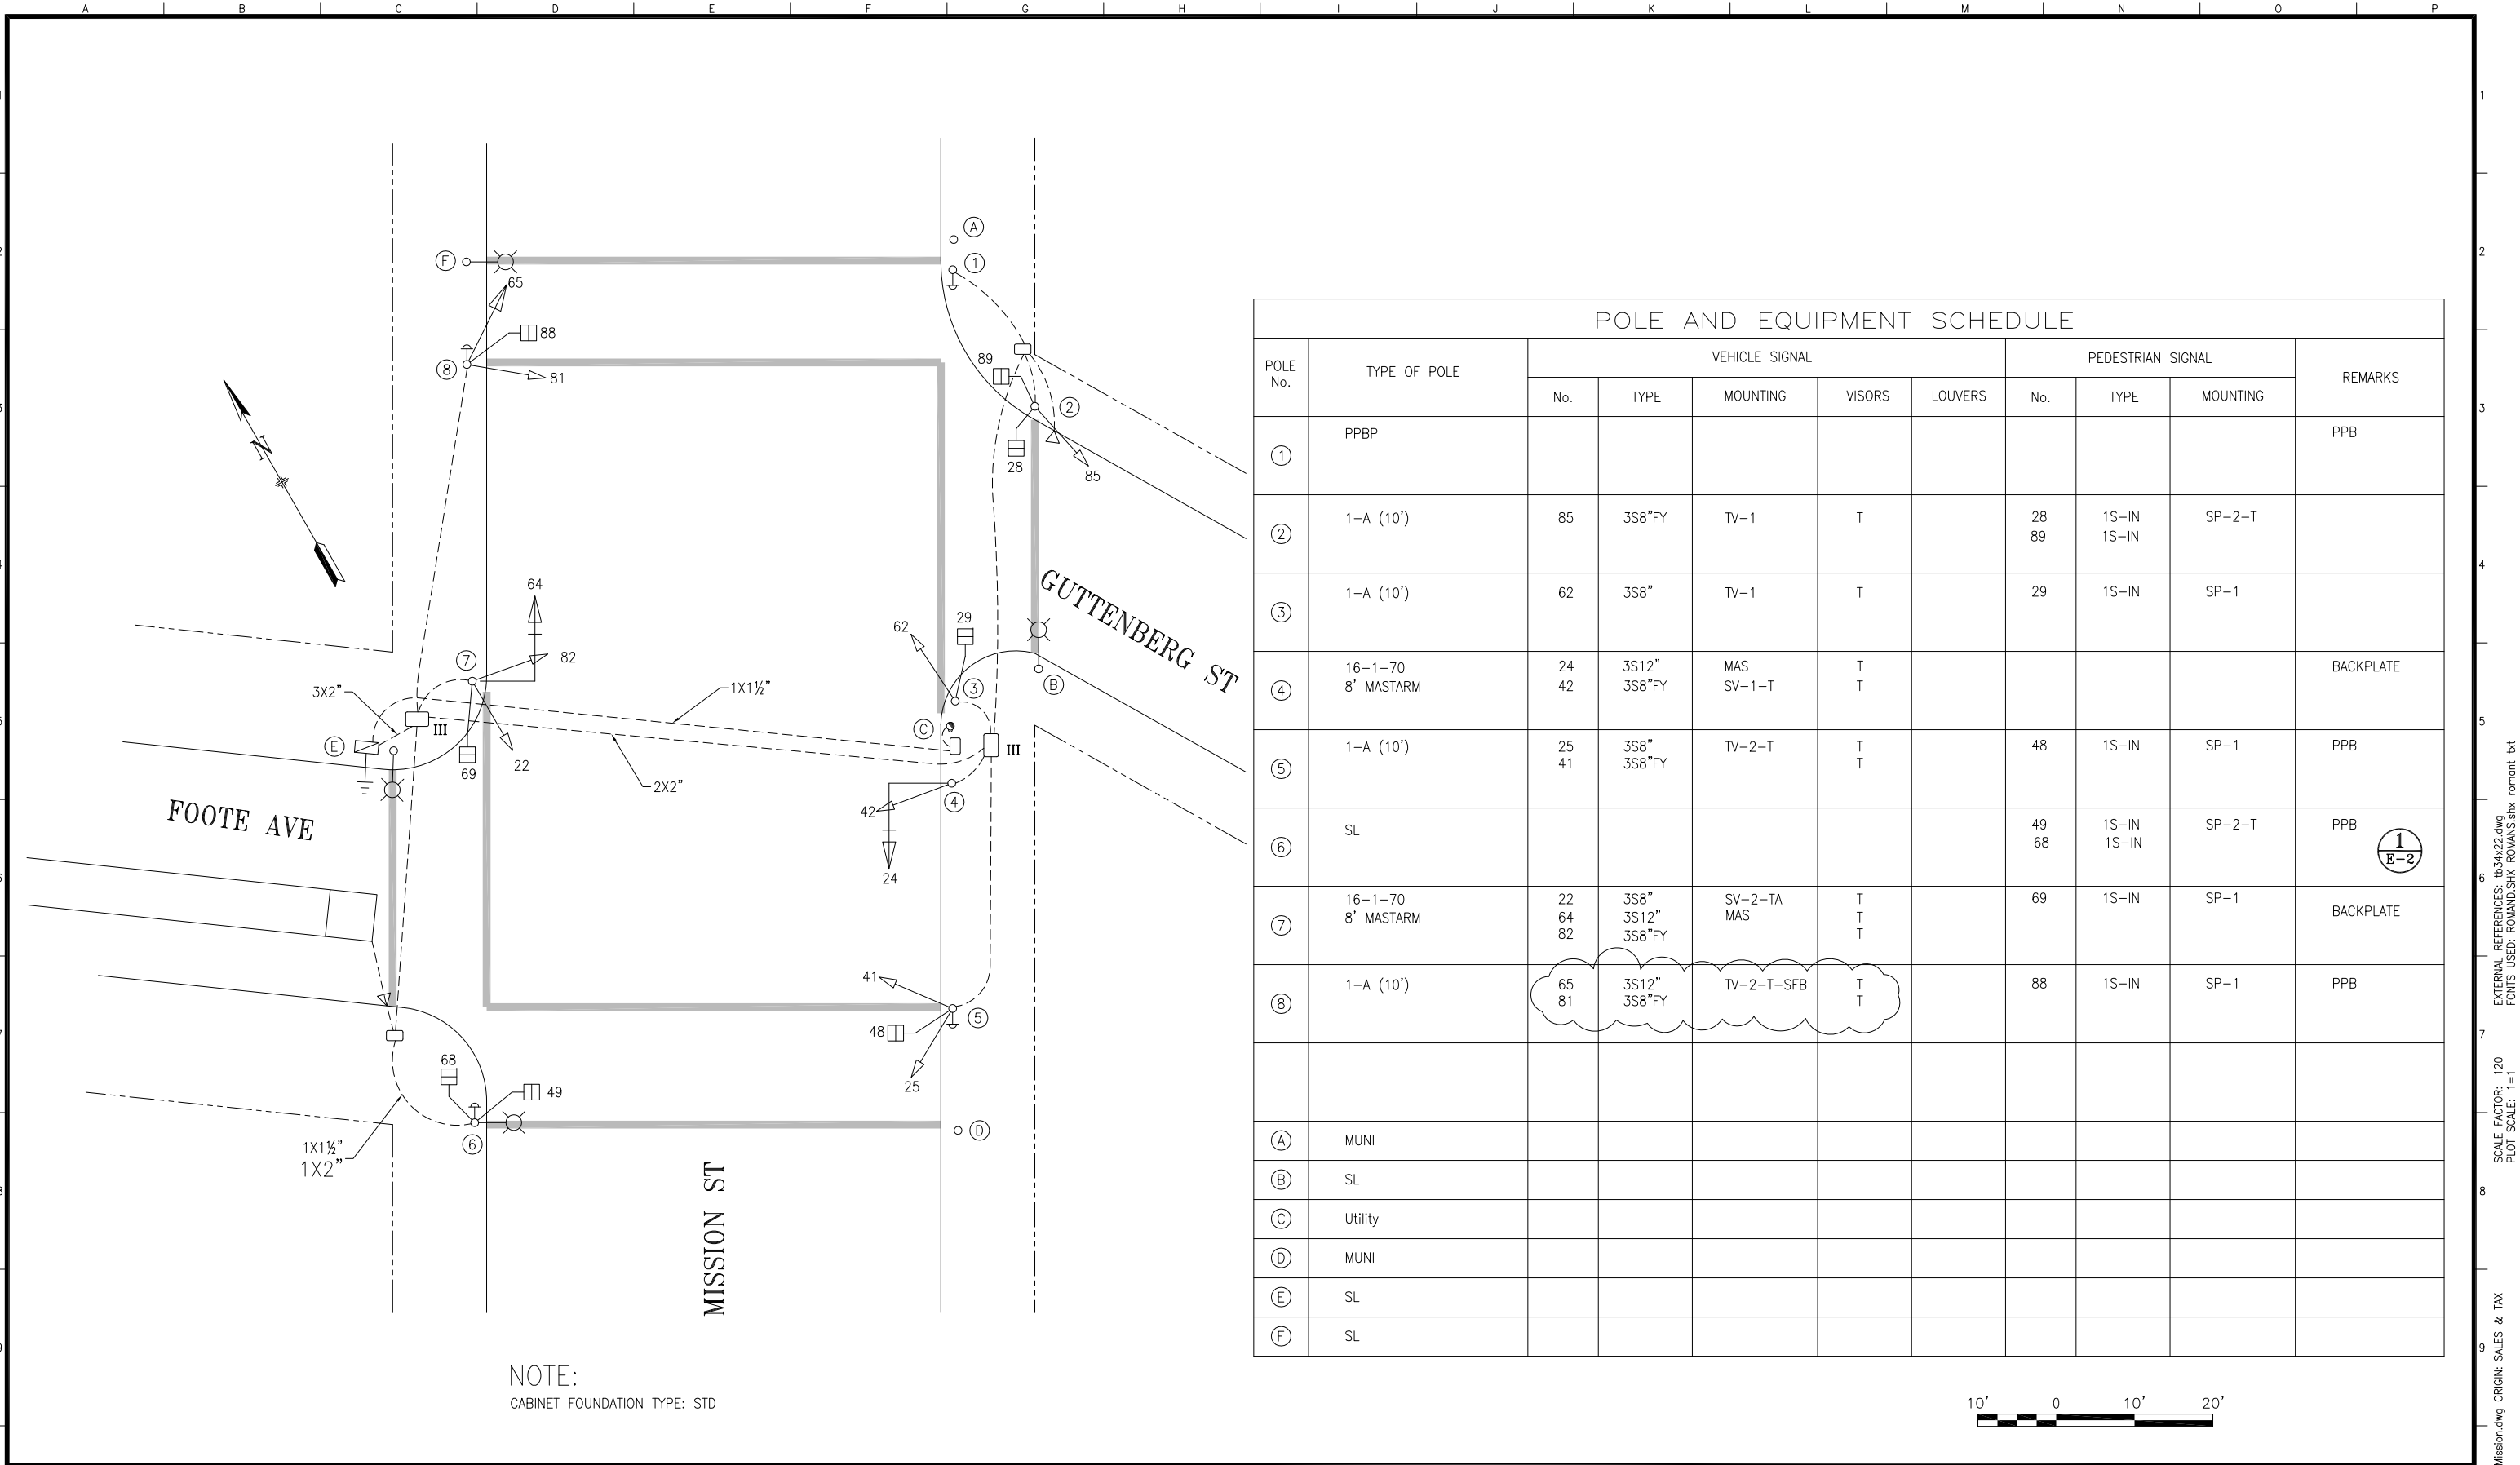

NO.	DATE	DESCRIPTION	BY	APP.
2	5/27/13	CHANGE 65 TO 3S12" AND TV-2-T-SFB	MV	HQ
1	01/97	NEW TRAFFIC SIGNALS CT48	CXL	DVS

TABLE OF REVISIONS
CHECK WITH TRACING TO SEE IF YOU HAVE LATEST REVISION

REFERENCE INFORMATION
& FILE NO. OF SURVEYS

SAN FRANCISCO MUNICIPAL TRANSPORTATION AGENCY
CITY AND COUNTY OF SAN FRANCISCO

DESIGNED: DATE:	APPROVED:	SCALE: 1" = 20' SHEET OF SHEETS 1 OF 1
DRAWN: DATE:	SECTION ENGINEER: DATE:	
CHECKED: DATE:	CITY TRAFFIC ENGINEER: DATE:	

TRAFFIC SIGNAL INVENTORY DIAGRAM	CNN NO. 21496000
	REV NO.

EXTERNAL REFERENCES: t634x22.dwg
FONTS USED: ROMAND.SHX ROMANS.shx roman.txt
SCALE FACTOR: 120
PLOT SCALE: 1"=1'
FILE NAME: Foote_Guttenberg_Mission.dwg ORIGIN: SALES & TAX
DATE: Aug 24 2000 11:54