


LAYOUT 12/3/03

PHASE SEQUENCE:

G	Y	R	LAGUNA HONDA BLVD
R	G	Y	LAGUNA HONDA NORTHBOUND U TURN, PHASE 8
RH	WM	FRH	PEDS XING LAGUNA HONDA BLVD

PHASE DIAGRAM:

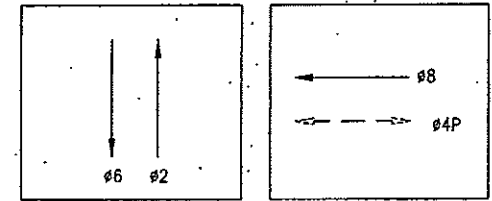

PHASES 2, 6

PHASES 8 & 8P

DETAIL NOTES:

- A4 R/C EX WIRING AND CONDUIT. REPAIR SIDEWALK TO MATCH EX.
- A5 EX CONDUIT AND WIRING. R/C EX WIRING. CUT CONDUIT FLUSH TO PULL BOX WALL OR 12" DEPTH, CAP OR DUCT SEAL END(S). ABANDON CONDUIT IN PLACE.
- A17 R/C EX TS WIRING. 12/C CABLE TO REMAIN.
- B SPLICE NEW WIRING TO EX SL WIRING TO MAINTAIN SL CIRCUIT.
- B6 SPLICE NEW DLC TO EX DLC/DLW TO MAINTAIN SIGNAL OPERATION.
- E5 R/S EX PULL BOX COVER. F/I NEW COVER.
- I EXTEND 12/C INTERCONNECT TO NEW IC LOCATION. SPLICE TO EX 12/C TO MAINTAIN INTERCONNECT SYSTEM.
- L F/I IN-LINE FUSE HOLDER W/ 40A FUSE FOR IC SERVICE.
- 15 CONTRACTOR SHALL COORDINATE WITH WALLY SUN OF HETCH HETCHY AT (415) 554-1873 TO DISCONNECT EX PG&E IC SERVICE WIRING. R/C EXISTING WIRING. CUT CONDUIT FLUSH TO PULL BOX WALL OR 12" DEPTH, CAP END(S). ABANDON CONDUIT IN PLACE.
- 17 COORDINATE WITH PG&E VIA WALLY SUN OF HETCH HETCHY AT (415) 554-1873 FOR CONNECTION WORK.


SHEET NOTES:

- CONTRACTOR SHALL COORDINATE WITH MUNI OVERHEAD BY CONTACTING RICHARD HAHN AT 554-8223 TO RELOCATE VIDEO CAMERA ON POLE #5.
- CONTRACTOR IS ADVISED LAGUNA HONDA BOULEVARD HAS RECENTLY BEEN PAVED AND THEREFORE IS A MORATORIUM STREET. CONTRACTOR TO CHECK WITH BSM FOR PAVING REQUIREMENTS/FEEs.

New Striping

LAGUNA HONDA BOULEVARD

SWITCHOVER THURS 11-18-04 1102
SIGNAL SHOP JN, WZ
ENGRG ET

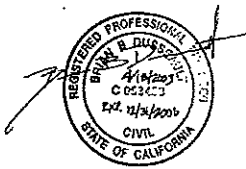

NO. DATE DESCRIPTION BY APP.		REFERENCE INFORMATION & FILE NO. OF SURVEYS		BUREAU OF ENGINEERING DEPARTMENT OF PUBLIC WORKS CITY AND COUNTY OF SAN FRANCISCO		DESIGNED: DATE: 3/03	APPROVED: DATE: 4/1/03	SCALE: 1"=10'-0"	SHEET OF SHEETS 41 OF 49	CONTRACT 28-29 TRAFFIC SIGNAL MODIFICATION	SPECIFICATION NO. 0435J
TABLE OF REVISIONS CHECK WITH TRACING TO SEE IF YOU HAVE LATEST REVISION						DRAWN: DATE: 3/03	SECTION MANAGER: DATE: 4/24/03				DRAWING NO. E-28.0
						CHECKED: DATE: 3/03	DEPUTY MANAGER: DATE: 4/25/03			LAGUNA HONDA BLVD AND FOREST HILL STATION	FILE NO. 83,131
							CITY ENGINEER: DATE: 4/25/03				REV. NO. 0

Drawing Path: V:\0435J TRAFFIC SIGNAL CONTRACT #28 AND#29\2 Design\Working Drawings\0435J E28.0.dwg, LogImpaint Scale 120

CONDUIT AND WIRING SCHEDULE (FURNISH AND INSTALL CONDUIT AND WIRES)

[illegible]

POLE AND EQUIPMENT SCHEDULE

[illegible]

DETAIL NOTES:


 F/I WITH INTEGRAL BALLAST AND PHOTOELECTRIC CONTROL F/I FUSE
 AND FUSE HOLDERS PER SPODWSF FILE #49,092.

[illegible]