


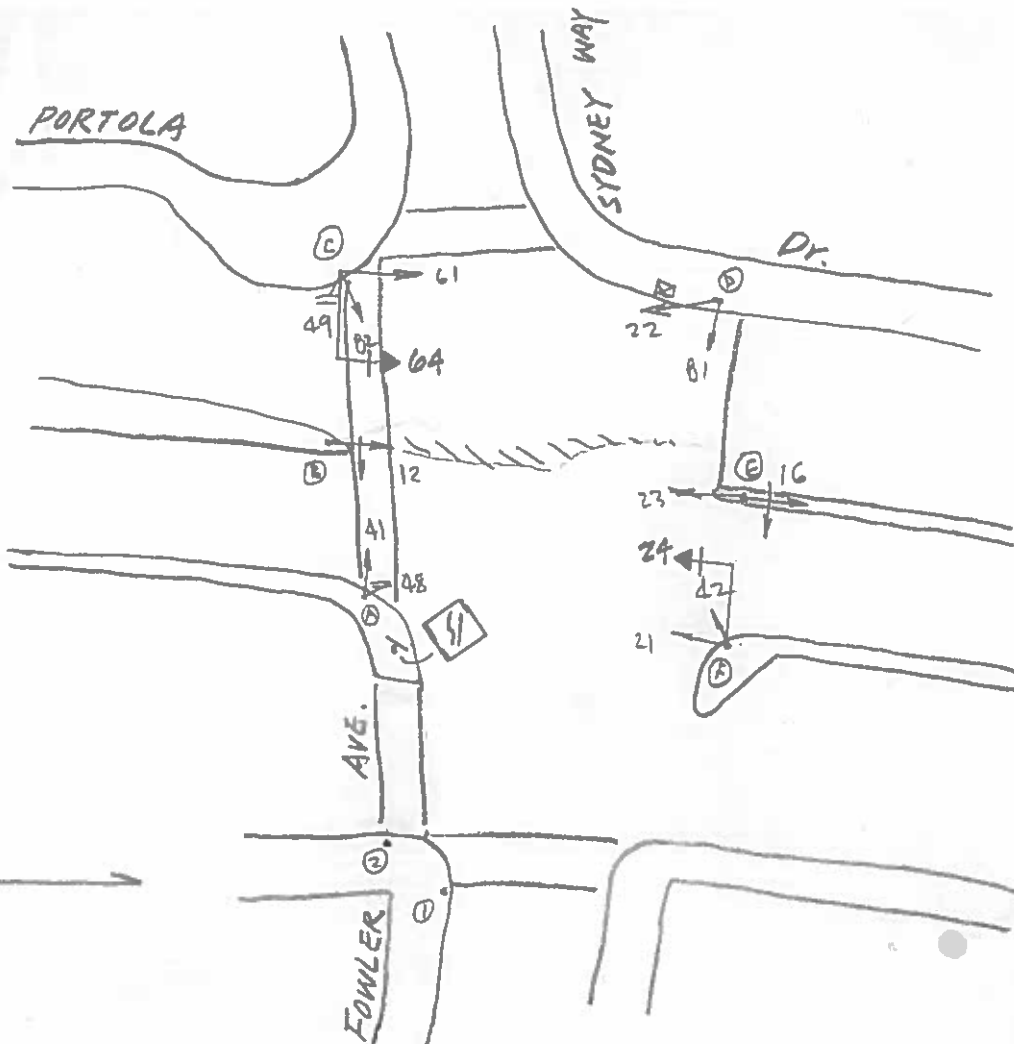

8-16-16

POLE	FUNC.	MAT'L	SIGNAL NO.	MAKE	NO. OF SECT.	SIZE	VISOR	B.P. OR LOUVERS	MOUNT	PED SIGNAL NO.	LEGEND	MESSAGE		MAKE	MOUN
												ELEMENT	COLOR		
A	S	C	41	TCT	1	12" R	FC 12"	NO	T	48	I	15-1	W/OR	ICC	S
B	L	C	12	EC	3	12" RY G	FC 12"	NO	S	49	I	15-1	W/OR	ICC	S
C	S	S	63	EC	3	12" RY G	FC 12"	NO	S						
D	S	C	82	TCT	1	12" R	FC 12"	NO	S						
E	L	C	61	TCT	3	12"	FC 8"	NO	S						
F	S	S	22	TCT	3	12"	FC 8"	NO	T						
			81	TCT	1	12" R	FC 12"	NO	T						
11	L	C	23	EC	3	12"	FC 12"	NO	S						
2	L	S	42	TCT	1	12" R	FC 12"	NO	S						
			21	TCT	3	12"	FC 8"	NO	S						
			64	TCT	3	12"	FC 12"	BP	MAS						
			24	TCT	3	12"	FC 12"	BP	MAS						
			16	EC	3	12" RY G	FC 12"	NO	S						

CONTROLLER CABINET SIZE : Ordinary BASE CABINET : Yes

COMMENTS : SIGNAL 61, 22, 21 TO 12" - ET