


SWITCHED OVER 7/21/2016  
DARK @ 11:03 AM, 3-COLOR AT 11:51 AM  
J. HORNOSTEL (MTA); J. TOM (SFPW)  
J. AFFOLTER, S. BUSS (Signal Shop)

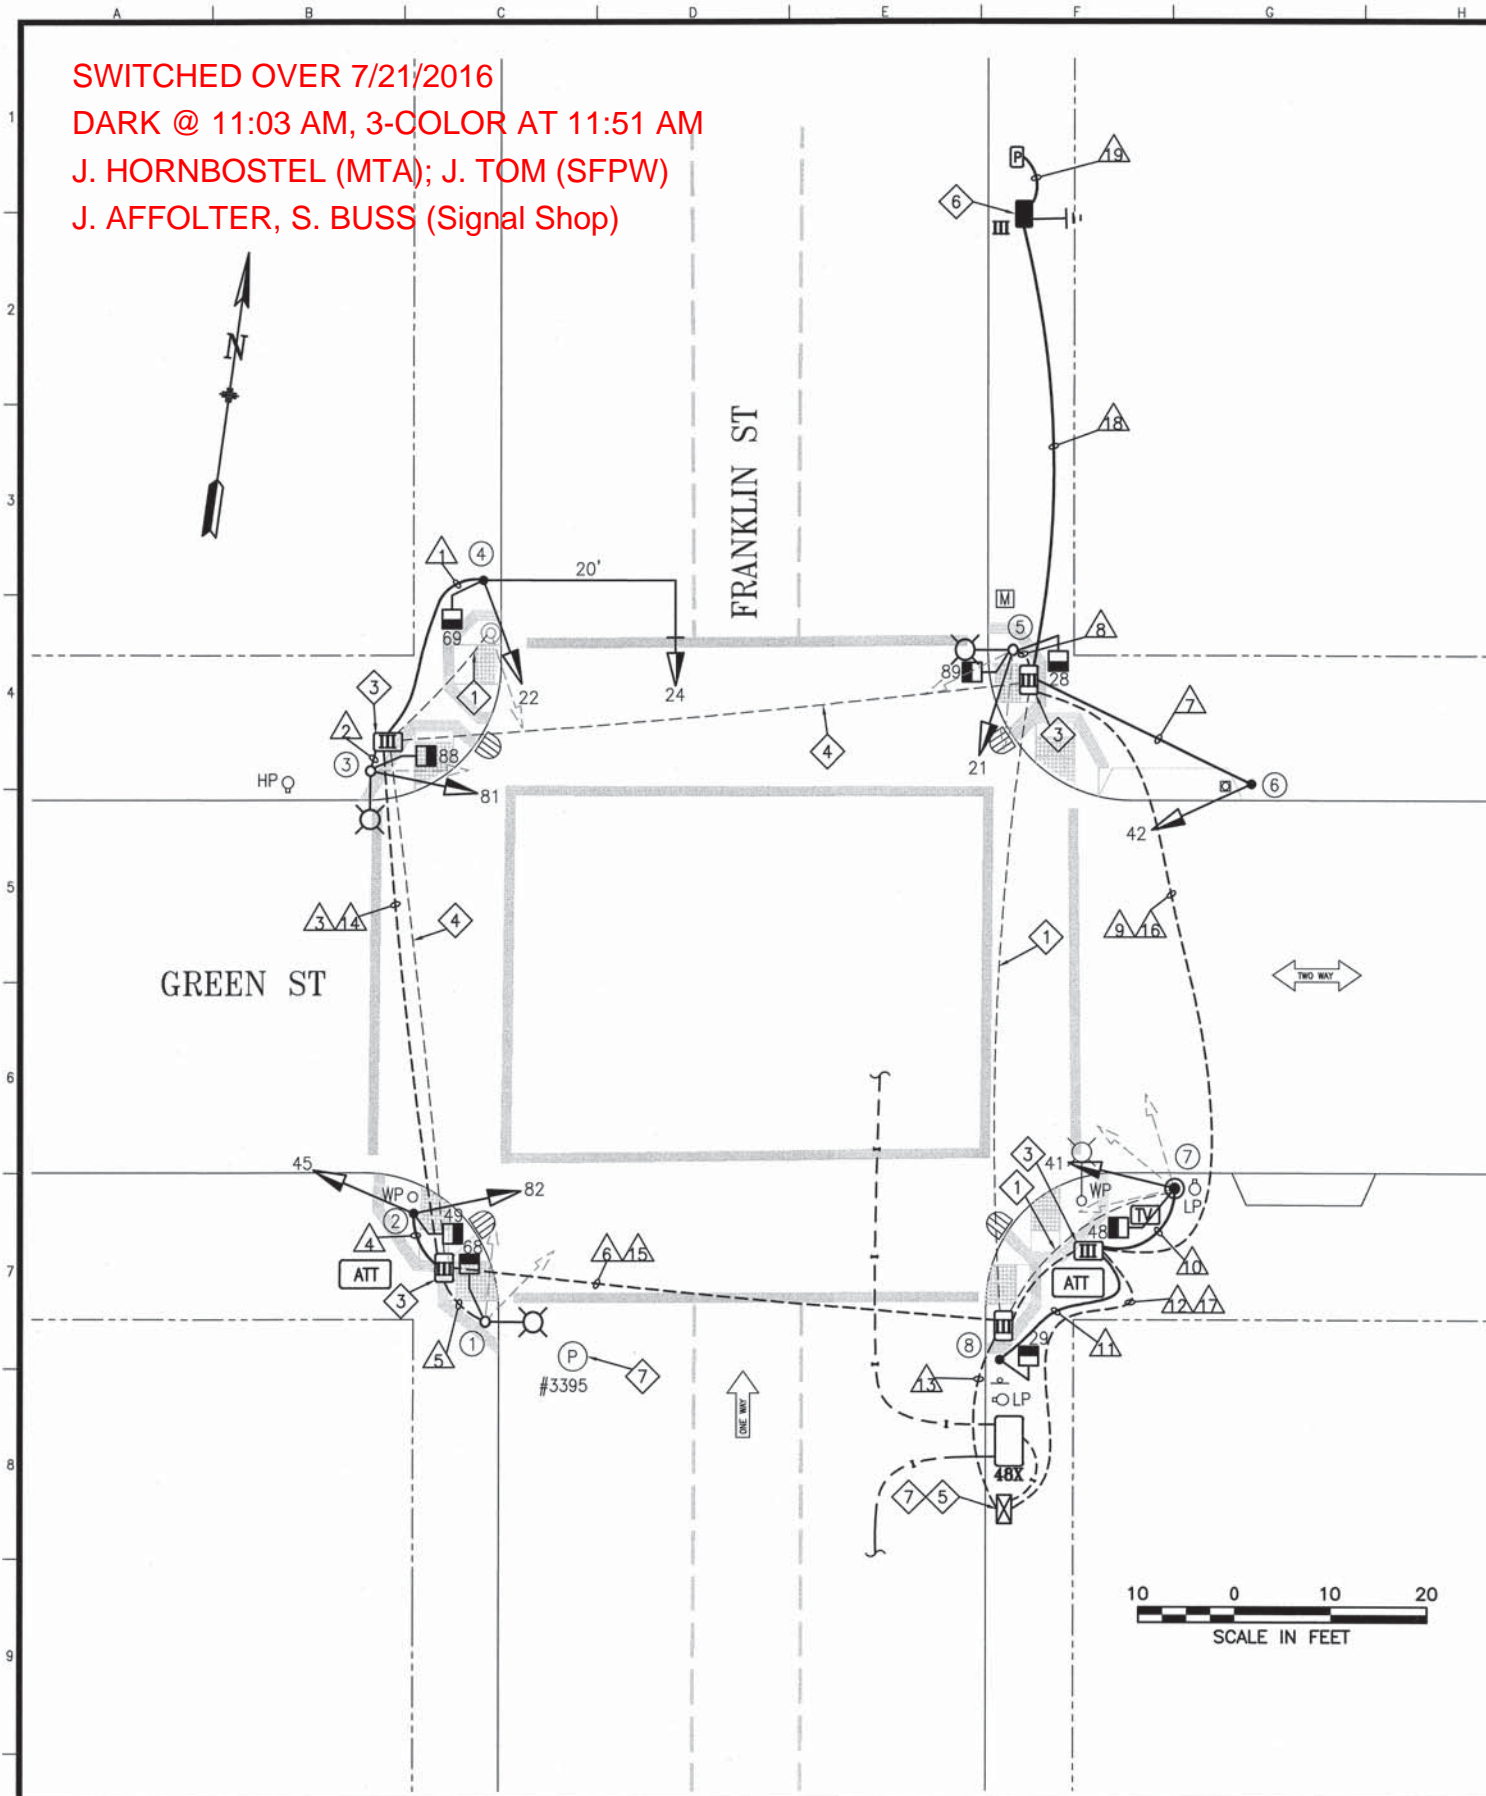

POLE AND EQUIPMENT SCHEDULE											
POLE No.	TYPE OF POLE	LUMINAIRE VOLTAGE/ WATTAGE	VEHICLE SIGNAL					PEDESTRIAN SIGNAL			REMARKS
			No.	TYPE	MOUNTING	VISORS	LOUVERS	No.	TYPE	MOUNTING	
①	EX MARBELITE STREET LIGHT							68	1S-COUNT 2	SP-1	
②	1-A (10')		82 45	3S12" 3S12"	TV-2-T	T T		49	1S-COUNT 2	SP-1	
③	EX MARBELITE STREET LIGHT		81	3S12"	SV-1-T	T		88	1S-COUNT 2	SP-1	
④	16-2-100 WITH 20' MAST ARM		22 24	3S12" 3S12"	SV-1-T MAS	T T		69	1S-COUNT 2	SP-1	BACKPLATE
⑤	EX MARBELITE STREET LIGHT		21	3S12"	SV-1-T	T		28 89	1S-COUNT 1S-COUNT 2	SP-1 (22") SP-1-SF (12")	
⑥	1-A (10')		42	3S12"	TV-1-T	T					
⑦	1-A (10')		41	3S12"	TV-1-T	T		48	1S-COUNT 2	SP-1 (22")	
⑧	1-A (10')							29	1S-COUNT 2	SP-1	


#### SHEET NOTES

- ABANDON EXISTING CONDUIT AND WIRING. CUT EXISTING CONDUIT AND WIRING TO PULLBOX WALL AND CAP ENDS. PRIOR TO ABANDONING OF EXISTING CABLES IN EXISTING CONDUIT, CONTRACTOR TO FIELD VERIFY AND MAINTAIN SERVICES TO STREETLIGHTS AND TRAFFIC CONTROLLER.
- CONTRACTOR TO INSTALL CITY FURNISHED ONE SECTION LED PEDESTRIAN COUNTDOWN SIGNAL MODULE IN CONTRACTOR FURNISHED ONE SECTION PEDESTRIAN SIGNAL HOUSING.
- BRING NEW CONDUITS INTO EXISTING PULL BOX. CONTRACTOR SHALL BE CAREFUL TO AVOID DAMAGE TO EXISTING PULL BOX.
- REMOVE EXISTING CABLES EXCEPT SERVICES TO STREETLIGHTS AND INTERCONNECT CABLES WHERE APPLICABLE. PRIOR TO REMOVAL OF EXISTING CABLES IN EXISTING CONDUIT, CONTRACTOR TO FIELD VERIFY AND MAINTAIN EXISTING SERVICES TO STREETLIGHTS AND INTERCONNECT.
- CONTROLLER SERVICE POINT IS A PG&E SECONDARY BOX LOCATED 60' NORTH OF THE NORTHEAST CORNER OF THE FRANKLIN AND GREEN STREETS PROPERTY LINE. CONTRACTOR TO COORDINATE WITH PG&E THROUGH SFPUC FOR ACTIVATION OF SERVICE POINT.
- CONTRACTOR SHALL PROVIDE 40A INLINE FUSE AND FUSE HOLDER TRAFFIC SIGNAL SERVICE DISCONNECT IN FIRST PULL BOX NEXT TO THE NEW PG&E SERVICE POINT.
- CONTRACTOR SHALL COORDINATE WITH PG&E THROUGH SFPUC FOR DEACTIVATION OF SERVICE CONNECTION WORK TO BE COMPLETED AFTER ACTIVATION OF NEW SERVICE POINT. TEN WORKING DAY'S NOTICE IS REQUIRED.

#### GENERAL NOTES

- CONTRACTOR TO REFER TO DRAWING G-0.4, GENERAL NOTE 15, 35, 44, 45, 46 FOR ADDITIONAL INFORMATION.

#### PHASE DIAGRAM

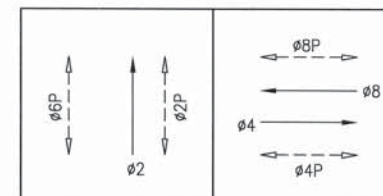


#### PHASE SEQUENCE


G	Y	R	FRANKLIN ST. (NB) - 02
R	G	Y R	GREEN ST. (EB & WB) - 04 & 08
W	FRH	RH	PEDS XING GREEN ST. (ES & WS) - 02P & 06P
RH	W	FRH RH	PEDS XING FRANKLIN ST. (SS & NS) - 04P & 08P

NO.	DATE	DESCRIPTION	BY	APP.
TABLE OF REVISIONS				

REFERENCE INFORMATION  
& FILE NO. OF SURVEYS

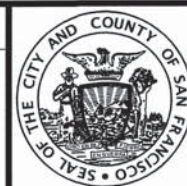

**INFRASTRUCTURE DIVISION**  
SAN FRANCISCO PUBLIC WORKS  
CITY AND COUNTY OF SAN FRANCISCO

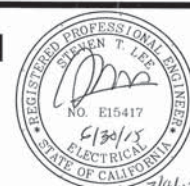

DESIGNED: DATE: 3/05/2015  
JH/WC  
DRAWN: DATE: 3/05/2015  
SS/WC  
CHECKED: DATE: 3/05/2015  
STL/NW

APPROVED  
SECTION MANAGER  
DEPUTY DIVISION MANAGER  
DIVISION MANAGER

SCALE:  
AS SHOWN  
SHEET OF SHEETS  
54 OF 73

FRANKLIN AND DIVISADERO STREET  
TRAFFIC SIGNAL UPGRADE

FRANKLIN STREET AND GREEN STREET  
TRAFFIC SIGNAL WORK

CONTRACT NO.  
2596J  
DRAWING NO.  
E-24.0  
FILE NO.  
100,843  
REV. NO.



[illegible][illegible]