




POLE AND EQUIPMENT SCHEDULE											
POLE No.	TYPE OF POLE	LUMINAIRE VOLTAGE/ WATTAGE	VEHICLE SIGNAL					PEDESTRIAN SIGNAL			REMARKS
			No.	TYPE	MOUNTING	VISORS	LOUVERS	No.	TYPE	MOUNTING	
①	17-2-80 W/ 30' MA & 12' LA		81 84	3S12" 3S12"	SV-1-T MAS	T T		88	1S-COUNT	SP-1-T	BACKPLATE BACKPLATE PPB VDC(ø8)
②	1-A (10')		22 65	3S12" 3S12"	TV-2-T	T T		69	1S-COUNT	SP-1-T	BACKPLATE BACKPLATE PPB
③	MARBELITE SL										
④	19A-2-80 W/ 25' MA & 12' LA		21 24	3S12" 3S12"	SV-1-T MAS	T T		28	1S-COUNT	SP-1-T	BACKPLATE BACKPLATE PPB VDC(ø2)
⑤	1-A (10')							89	1S-COUNT	SP-1-T	PPB
⑥	17-2-80 W/ 15' MA & 12' LA		51 54	3S12"RA 3S12"RA	SV-1-T MAS	T T					BACKPLATE BACKPLATE PPB VDC(ø6)
⑦	1-A (10')		25 62	3S12" 3S12"	TV-2-T	T T		29	1S-COUNT	SP-1-T	BACKPLATE BACKPLATE
⑧	MARBELITE SL										
⑨	19A-2-80 W/ 25' MA & 12' LA		61 64	3S12" 3S12"	SV-1-T MAS	T T		68	1S-COUNT	SP-1-T	BACKPLATE BACKPLATE
⑩	1-A (10')		55 82	3S12"RA 3S12"LA	TV-2-T	T T					BACKPLATE BACKPLATE PPB

NO.	DATE	DESCRIPTION	BY	APP.
2	6/30/16	CHANGE SIGNAL 82 TO ALL LEFT ARROWS, PER SRC 2014-273	DYeung	BWoo
1	5/9/11	REMOVE SIGNAL 85 ON POLE 5, PER SRC 2011-037, AS SHOWN ON AS-BUILT	DYeung	BWoo
0	1/16/06	SIGNAL UPGRD ACTIVATED THRU CALTRANS 04-171204 & CONVERTED FROM AS-BUILT	DYeung	BWoo
TABLE OF REVISIONS				
CHECK WITH TRACING TO SEE IF YOU HAVE LATEST REVISION				

REFERENCE INFORMATION
& FILE NO. OF SURVEYS

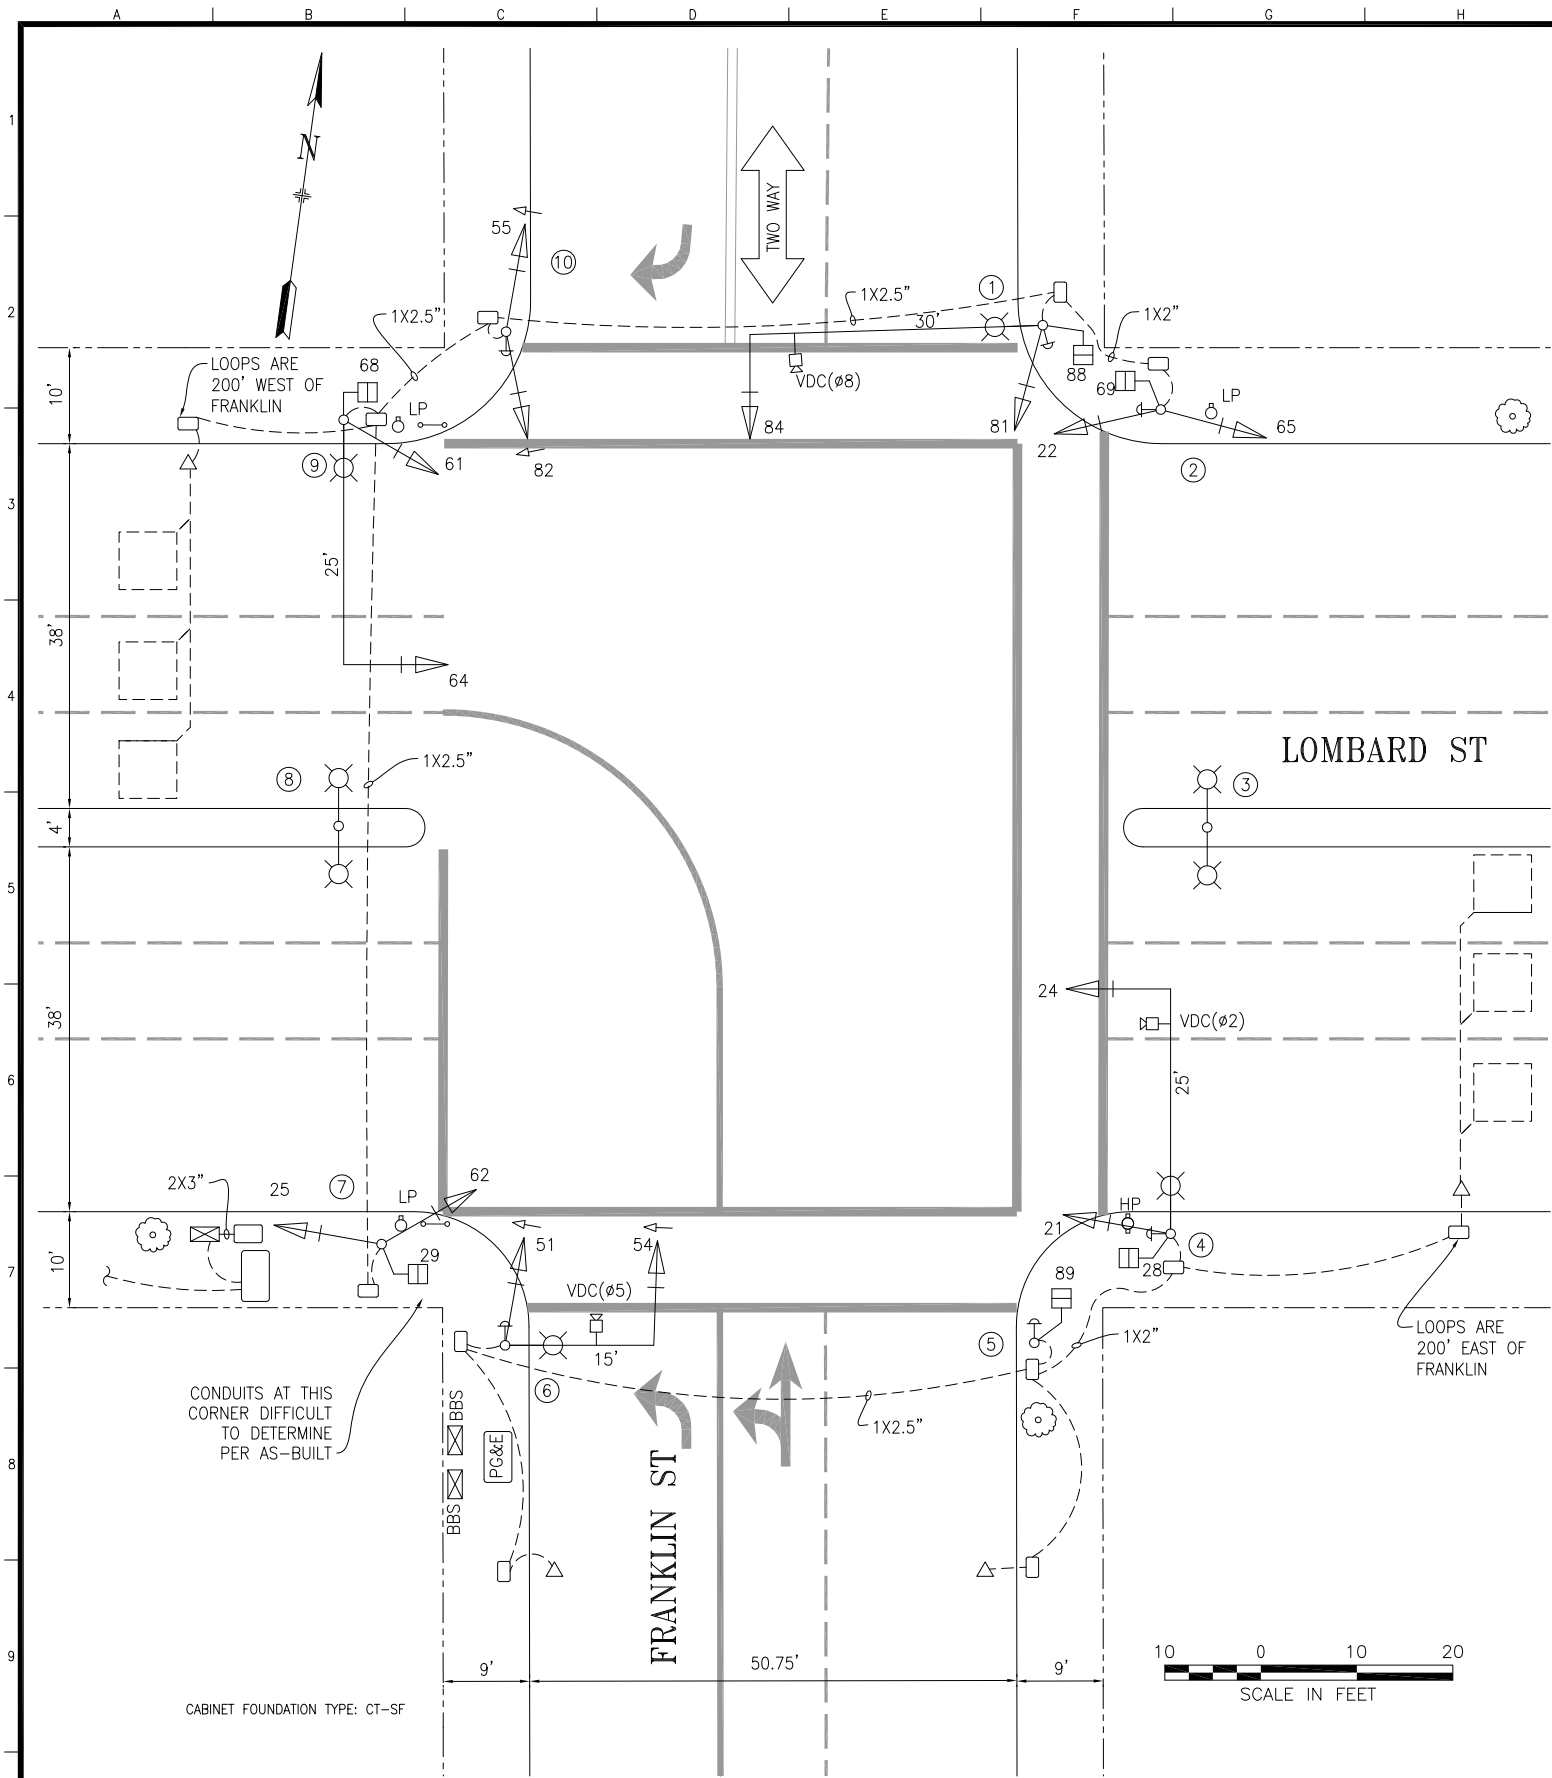

SAN FRANCISCO MUNICIPAL TRANSPORTATION AGENCY
CITY AND COUNTY OF SAN FRANCISCO

DRAWN: DATE:
DYeung 11/2014
CHECKED: DATE:
BWoo 11/2014

SCALE:

1" = 10'

SHEET OF SHEETS

1 OF 1

TRAFFIC SIGNAL INVENTORY DIAGRAM

FRANKLIN ST AND LOMBARD ST

CNN NO.

26699000

REV NO.