


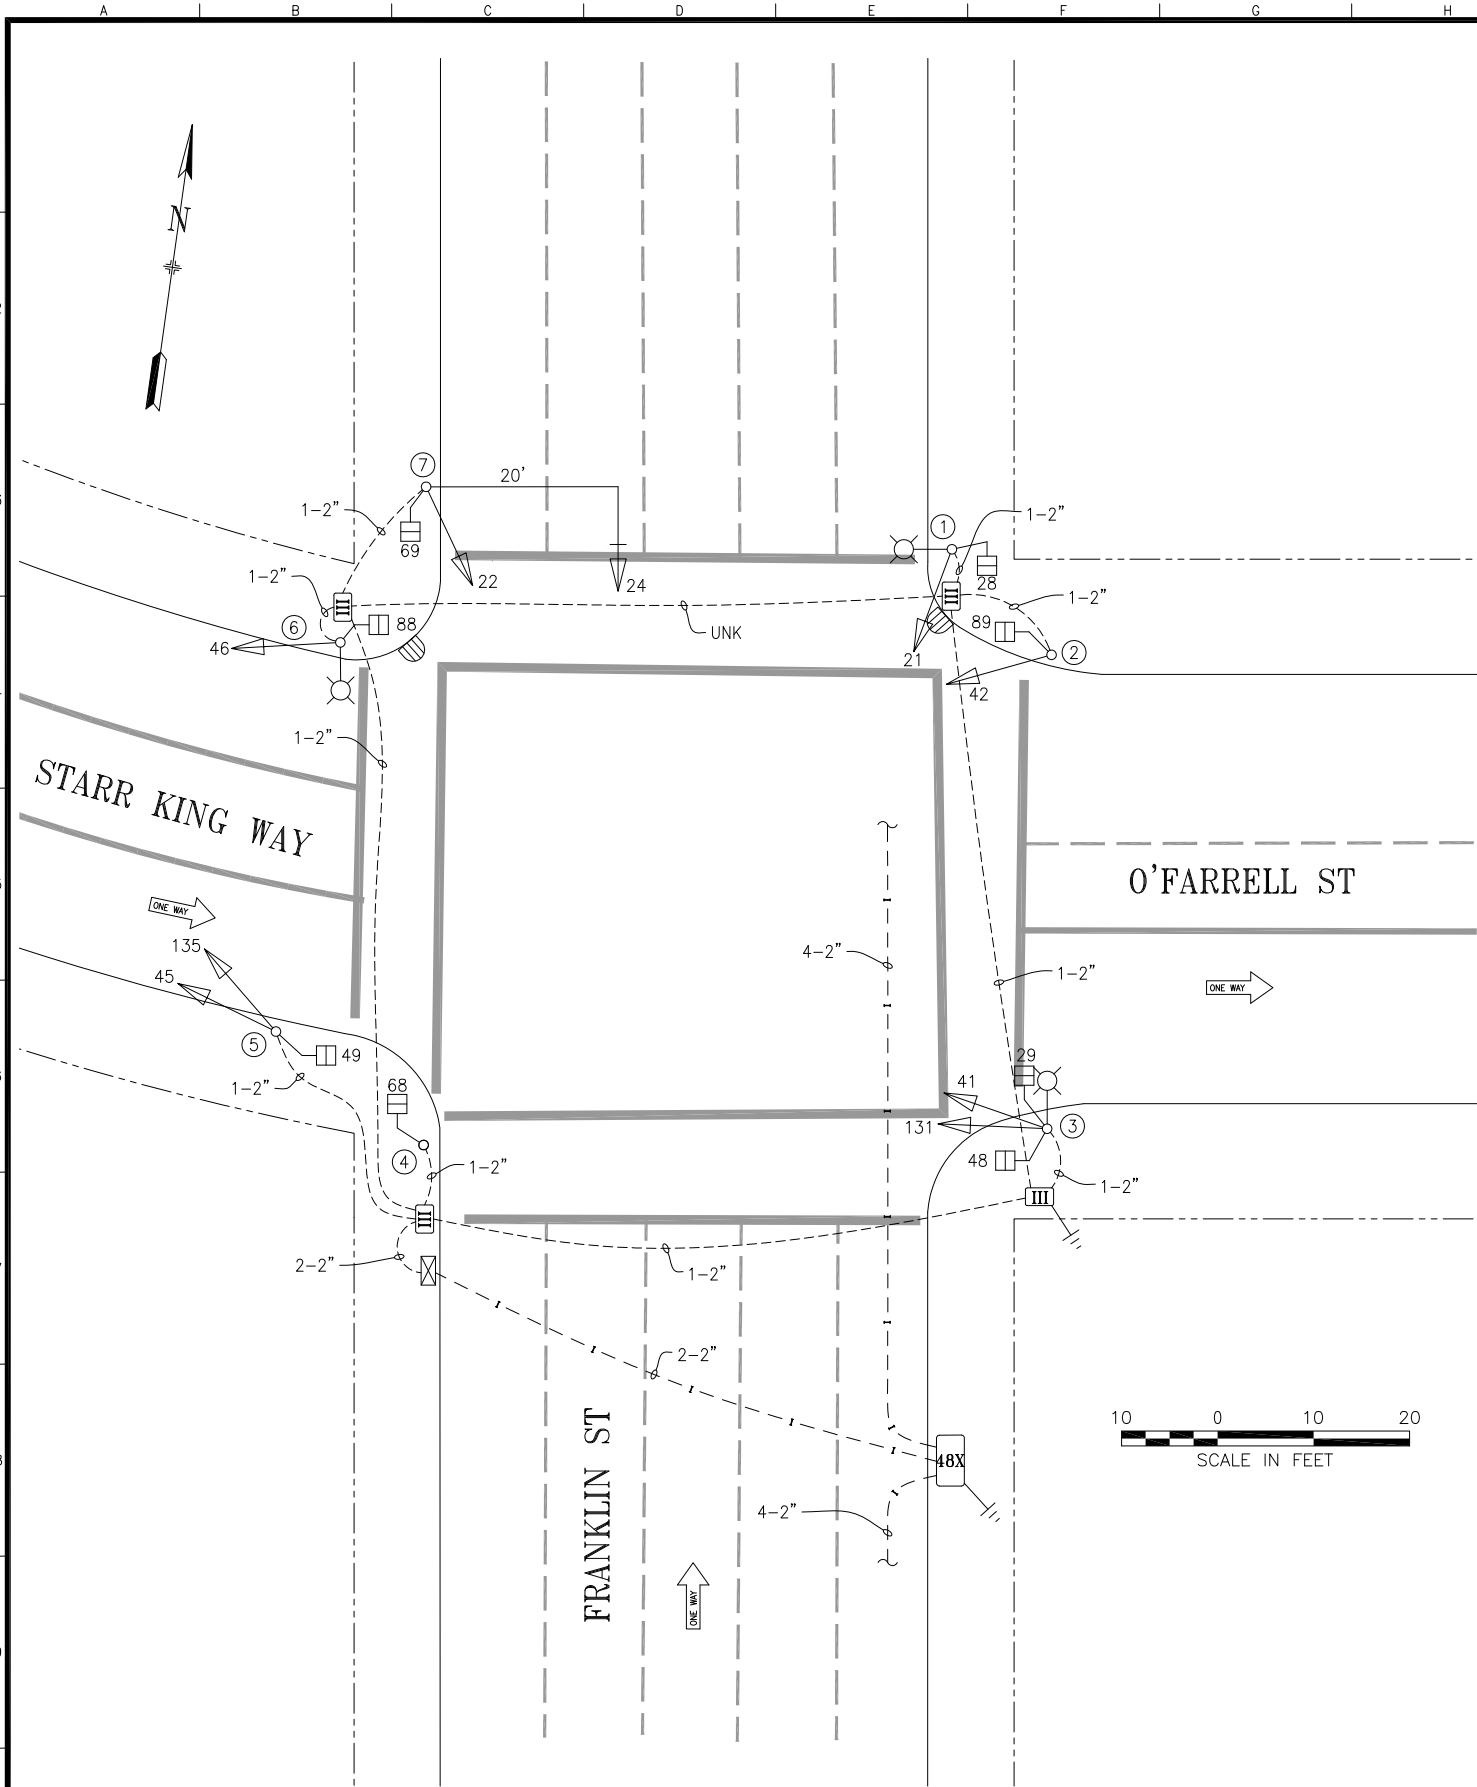

POLE AND EQUIPMENT SCHEDULE											
POLE No.	TYPE OF POLE	LUMINAIRE VOLTAGE/WATTAGE	VEHICLE SIGNAL					PEDESTRIAN SIGNAL			REMARKS
			No.	TYPE	MOUNTING	VISORS	LOUVERS	No.	TYPE	MOUNTING	
①	EX MARBELITE STREET LIGHT		21	3S12"	SV-1-T	T		28	1S-COUNT	SP-1	
②	1-A (10')		42	3S12"	TV-1-T	T		89	1S-COUNT	SP-1	
③	EX MARBELITE STREET LIGHT		41 131	3S12" 2S12"LB	SV-1-T SV-1-T	T		29 48	1S-COUNT 1S-COUNT	SP-1-SF(12") SP-1(22")	BACKPLATE
④	1-A (7')							68	1S-COUNT	TP-1	
⑤	1-A (15')		45 135	3S12" 2S12"LB	SV-2-T	T		49	1S-COUNT	SP-1	BACKPLATE
⑥	MARBELITE STREET LIGHT		46	3S12"	SV-1-T	T		88	1S-COUNT	SP-1	
⑦	16-2-100 WITH 20' MAST ARM		22 24	3S12" 3S12"	SV-1-T MAS	T T		69	1S-COUNT	SP-1	BACKPLATE

NO.	DATE	DESCRIPTION	BY	APP.
3	5/23/18	ADDED TRANSIT SIGNAL HEADS AND REPLACED POLE PER SRC 2018-019	AL	MV
2	10/5/16	SIGNAL MODS ACTIVATED BY 2586I; CONVERTED FROM CONTRACT PLANS	JH	GD
1	8/8/14	FO INTERCONNECT BY 1900J; CONVERTED FROM AS-BUILTS	JH	GD
0	7/22/99	SIGNAL MODS ACTIVATED BY 1434N; CONVERTED FROM AS-BUILTS	JH	GD
TABLE OF REVISIONS				
CHECK WITH TRACING TO SEE IF YOU HAVE LATEST REVISION				

REFERENCE INFORMATION & FILE NO. OF SURVEYS
--



SAN FRANCISCO MUNICIPAL TRANSPORTATION AGENCY

CITY AND COUNTY OF SAN FRANCISCO

DRAWN:	DATE:
JH	11/2017
CHECKED:	DATE:
GD	11/2017

SCALE:
AS SHOWN
SHEET OF SHEETS
1 OF 1

TRAFFIC SIGNAL INVENTORY DIAGRAM
FRANKLIN STREET AND O'FARRELL STREET/STARR KING WAY

CNN NO.
25196000
REV NO.
3