

POLE AND EQUIPMENT SCHEDULE											
POLE No.	TYPE OF POLE	LUMINAIRE VOLTAGE/ WATTAGE	VEHICLE SIGNAL					PEDESTRIAN SIGNAL			REMARKS
			No.	TYPE	MOUNTING	VISORS	LOUVERS	No.	TYPE	MOUNTING	
①	1-A (10')		21	3S12"	TV-1-T	T		28 89	1S-COUNT 1S-COUNT	SP-1(22") SP-1-SF (12")	②
②											②
③	1-A (7')							48	1S-COUNT	TP-1	
④	1-A (7')							29	1S-COUNT	TP-1	
⑤	EX MARBELITE STREET LIGHT							68	1S-COUNT	SP-1	
⑥	16-2-100 WITH 20' MAST ARM		82 84	3S12" 3S12"	SV-1-T MAS	T T		49	1S-COUNT	SP-1	MOUNT 82 @ 13' BACKPLATE
⑦	EX MARBELITE STREET LIGHT		81	3S12"	SV-1-T	T		69 88	1S-COUNT 1S-COUNT	SP-1 SP-1	
⑧	16-2-100 WITH 20' MAST ARM		22 24	3S12" 3S12"	SV-1-T MAS	T T					BACKPLATE


SHEET NOTES

- ABANDON EXISTING CONDUIT AND WIRING. CUT EXISTING CONDUIT AND WIRING TO PULLBOX WALL AND CAP ENDS. PRIOR TO ABANDONING OF EXISTING CABLES IN EXISTING CONDUIT, CONTRACTOR TO FIELD VERIFY AND MAINTAIN SERVICES TO STREETLIGHTS AND TRAFFIC CONTROLLER.
- CONTRACTOR TO INSTALL CITY FURNISHED ONE SECTION LED PEDESTRIAN COUNTDOWN SIGNAL MODULE IN CONTRACTOR FURNISHED ONE SECTION PEDESTRIAN SIGNAL HOUSING.
- BRING NEW CONDUITS INTO EXISTING PULL BOX. CONTRACTOR SHALL BE CAREFUL TO AVOID DAMAGE TO EXISTING PULL BOX.
- REMOVE EXISTING CABLES IN EXISTING CONDUITS EXCEPT SERVICES TO STREETLIGHTS AND INTERCONNECT CABLES WHERE APPLICABLE. PRIOR TO REMOVAL OF EXISTING CABLES IN EXISTING CONDUITS, CONTRACTOR TO FIELD VERIFY AND MAINTAIN EXISTING SERVICES TO STREETLIGHTS AND TRAFFIC CONTROLLER.
- NOT USED
- NOT USED
- NOT USED

GENERAL NOTES

- CONTRACTOR TO REFER TO DRAWING G-0.4, GENERAL NOTE 15, 36, 44, 45, 46 FOR ADDITIONAL INFORMATION.

PHASE DIAGRAM

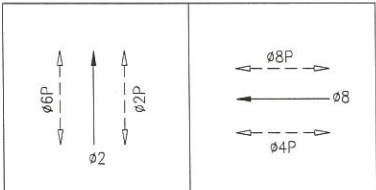

PHASE SEQUENCE

G	Y	R	FRANKLIN ST. (NB) - 02
R	G	Y R	SUTTER ST. (WB) - 08
W	FRH	RH	PEDS XING SUTTER ST. (ES & WS) - 02P & 06P
RH	W	FRH RH	PEDS XING FRANKLIN ST. (SS & NS) - 04P & 08P

NO.	DATE	DESCRIPTION	BY	APP.
2	2/2016	DELETE POLE 2, SIGNAL 85, CONDUIT 4; RELOCATE SIGNAL 89	JH	DY
1	11/2015	REVISED POLE 6 TO 16-2-100 W/ 20' MA; DELETED PG&E SERVICE WORK	JH	MV

REFERENCE INFORMATION
& FILE NO. OF SURVEYS



INFRASTRUCTURE DIVISION
SAN FRANCISCO PUBLIC WORKS
CITY AND COUNTY OF SAN FRANCISCO



DESIGNED: DATE: JH/WC 3/05/2015
DRAWN: DATE: SS/WC 3/05/2015
CHECKED: DATE: STL/NW 3/05/2015

APPROVED
SECTION MANAGER DATE:
DEPUTY DIVISION MANAGER DATE:
DIVISION MANAGER DATE:

SCALE:
AS SHOWN
SHEET OF SHEETS
32 OF 73

**FRANKLIN AND DIVISADERO STREET
TRAFFIC SIGNAL UPGRADE**

**FRANKLIN STREET AND SUTTER STREET
TRAFFIC SIGNAL WORK**

CONTRACT NO. 2596J
DRAWING NO. E-13.0
FILE NO. 100.821
REV. NO. 2

[illegible][illegible]