


FREMONT, FRONT, MARKET

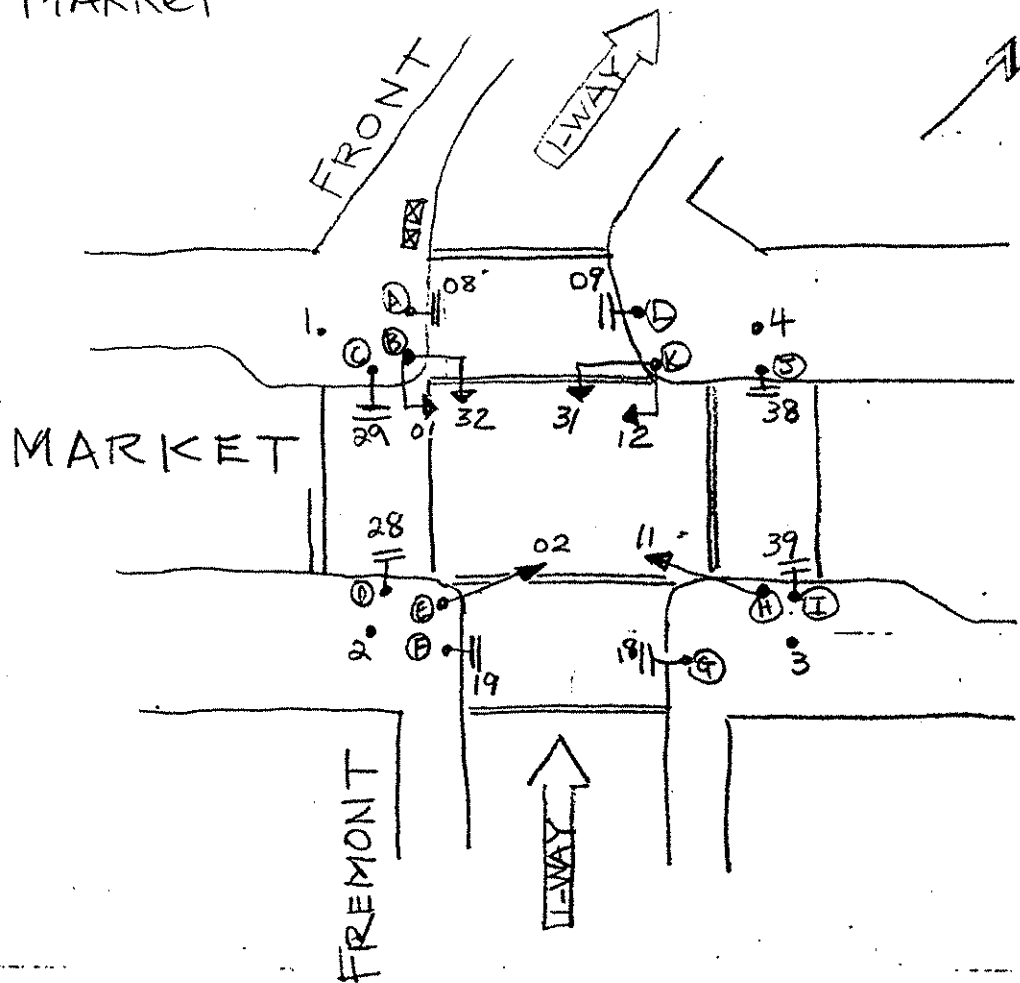

DATE

10-23-89

POLE	FUNC.	MATL	SIGNAL NO.	MAKE	NO. OF SECT.	SIZE	VISOR	B.P. OR LOUVERS	MOUNT	PED SIGNAL NO.	LEGEND	MESSAGE ELEMENT	COLOR	MAKE	MOU
A	S	S	32	—	3	8"	FC8"	BP	*	29	I	IS-I	W/OR	ICC	T
B	S	S	01	—	3	8"	FC8"	BP	*	28	I	IS-I	W/OR	ICC	T
C	S	S	02	—	3	8"	FC8"	BP	*	19	I	IS-I	W/OR	ICC	T
D	S	S	11	—	3	8"	FC8"	BP	*	18	I	IS-I	W/OR	ICC	T
E	S	S	12	—	3	8"	FC8"	BP	*	39	I	IS-I	W/OR	ICC	T
F	S	S	31	—	3	8"	FC8"	BP	*	38	I	IS-I	W/OR	ICC	T
G	S	S								09	I	IS-I	W/OR	ICC	T
H	S	S								08	I	IS-I	W/OR	ICC	T
I	S	S													
J	S	S													
K	S	S													
L	S	S													

1 L 0 CONTROLLER CABINET SIZE : 1-ORDINARY 1-NO
2 L 0 BASE CABINET : 1-Yes
3 0 COMMENTS : * MARKET STREET MASTARM SIGNALS
4 L 0