


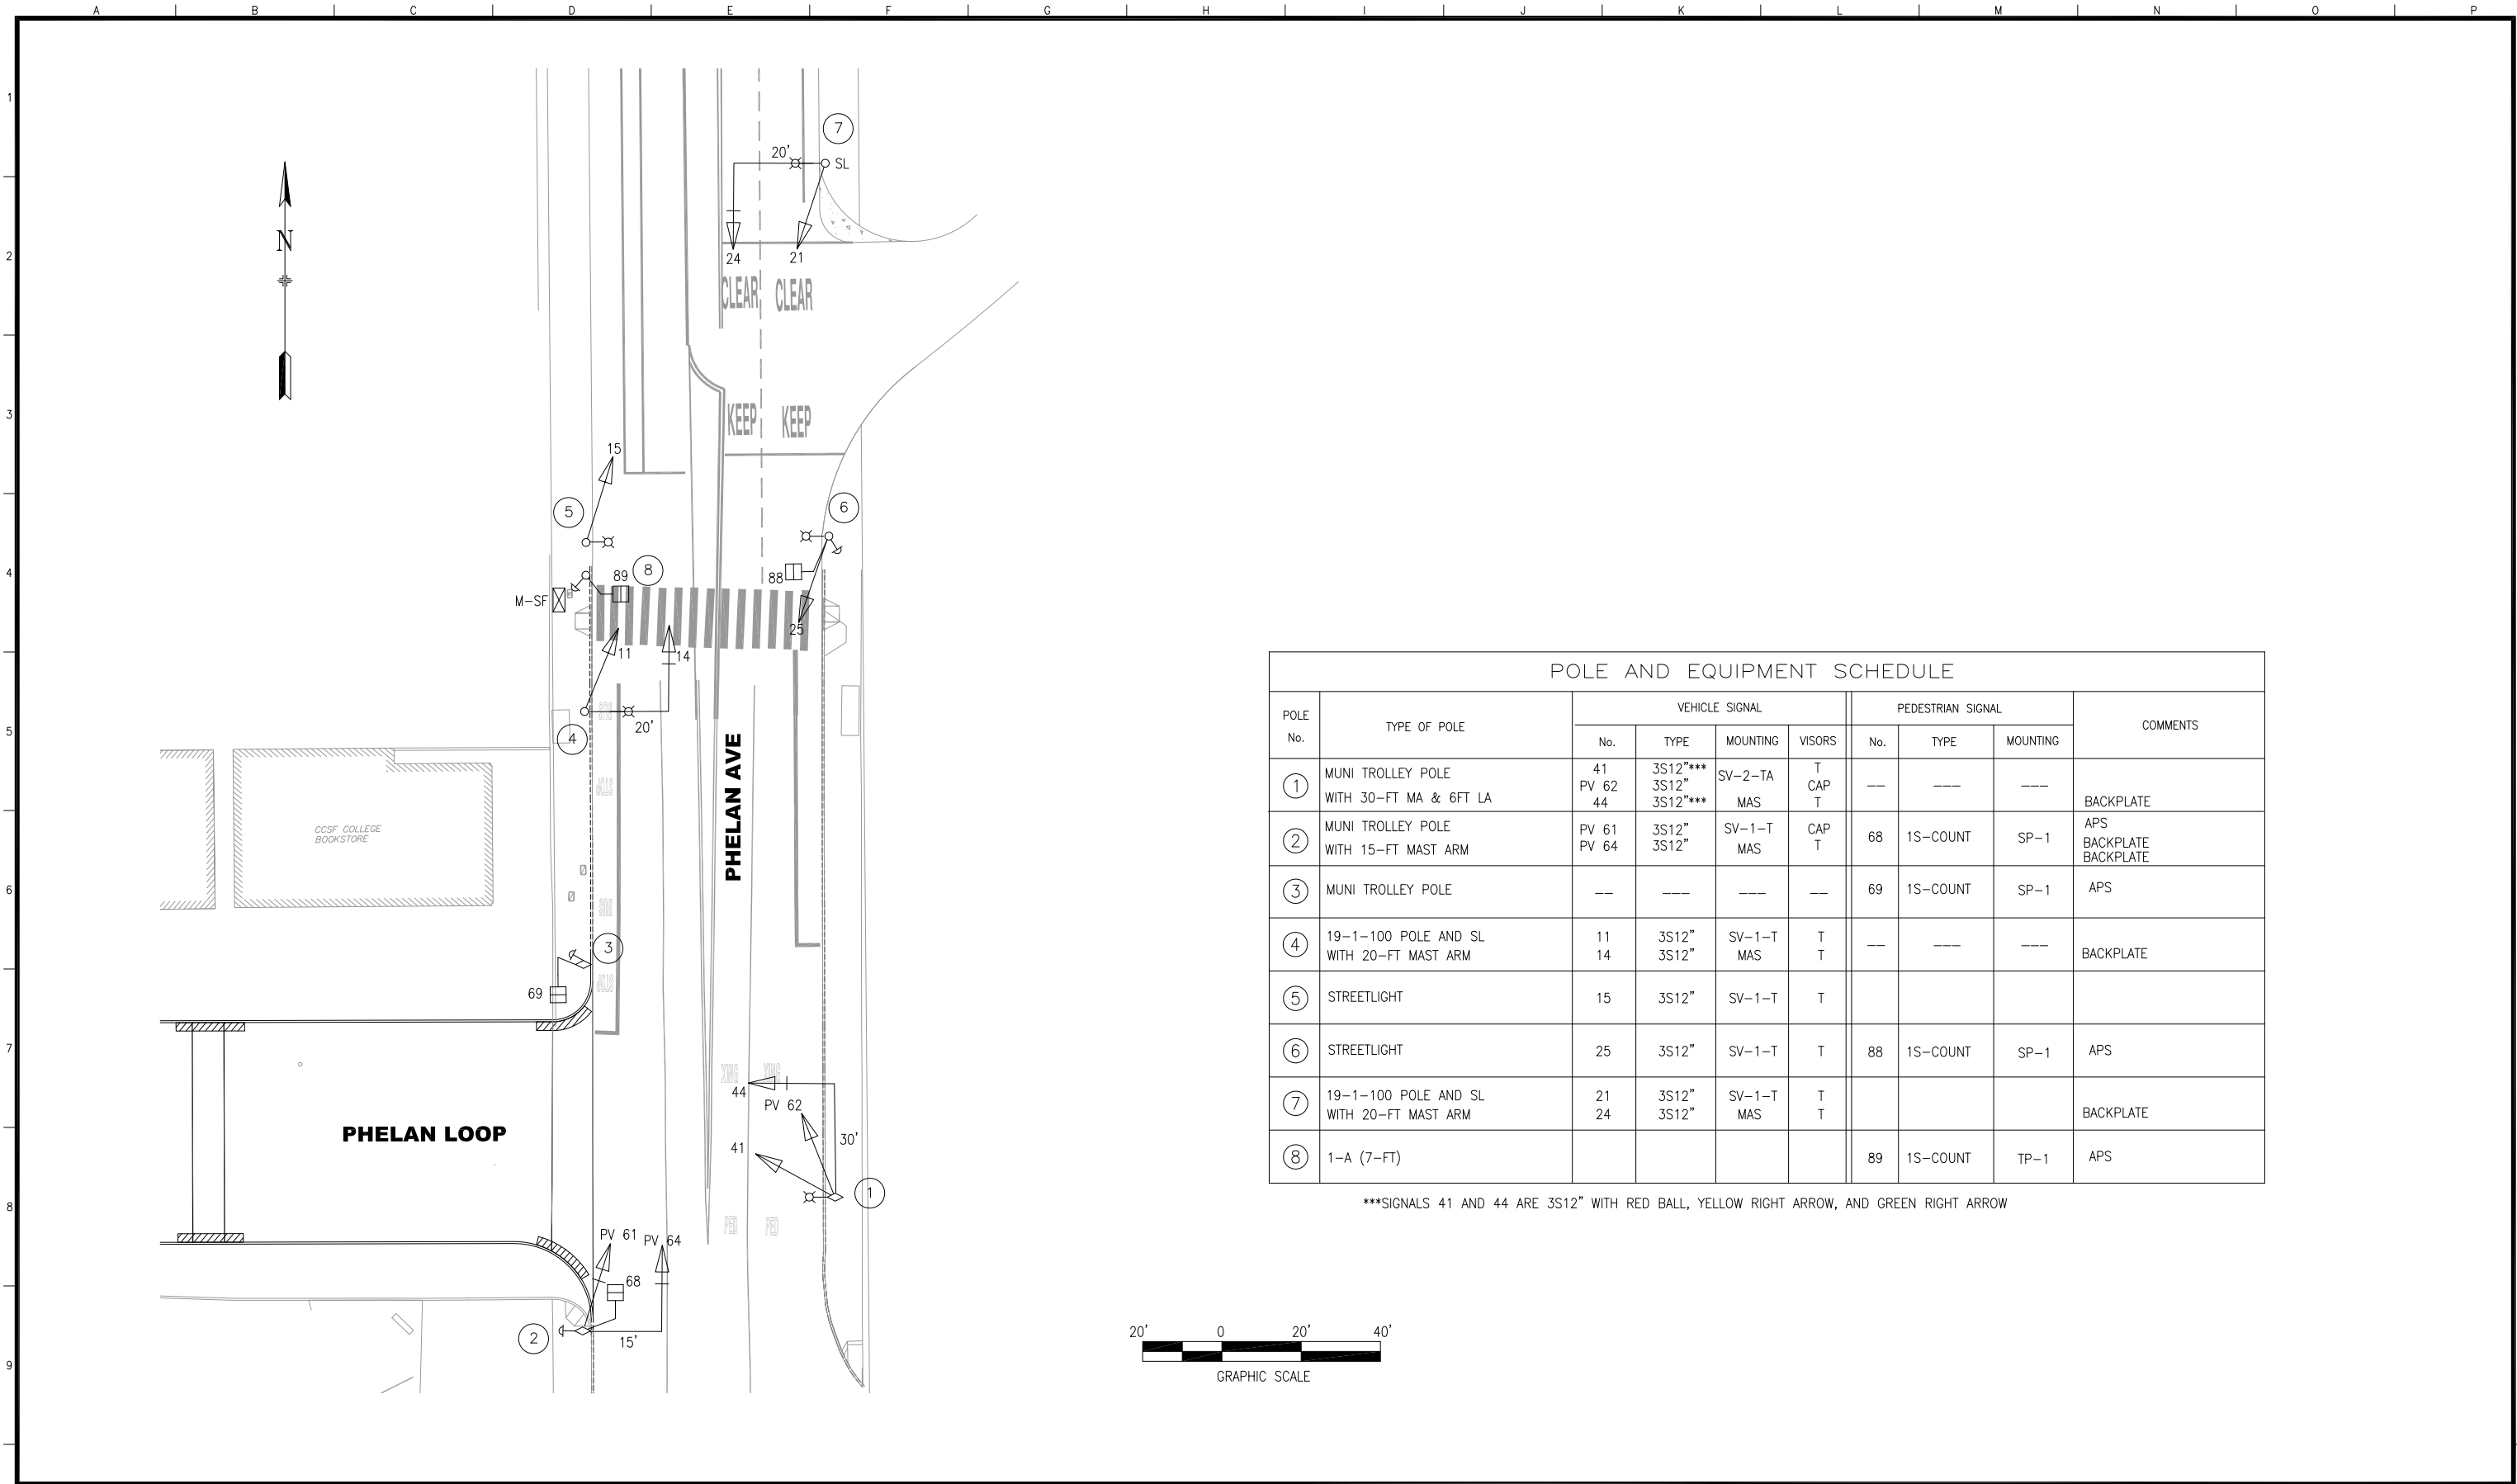

POLE AND EQUIPMENT SCHEDULE									
POLE No.	TYPE OF POLE	VEHICLE SIGNAL				PEDESTRIAN SIGNAL			COMMENTS
		No.	TYPE	MOUNTING	VISORS	No.	TYPE	MOUNTING	
①	MUNI TROLLEY POLE WITH 30-FT MA & 6FT LA	41 PV 62 44	3S12"*** 3S12" 3S12"***	SV-2-TA MAS	T CAP T	---	---	---	BACKPLATE
②	MUNI TROLLEY POLE WITH 15-FT MAST ARM	PV 61 PV 64	3S12" 3S12"	SV-1-T MAS	CAP T	68	1S-COUNT	SP-1	APS BACKPLATE BACKPLATE
③	MUNI TROLLEY POLE	---	---	---	---	69	1S-COUNT	SP-1	APS
④	19-1-100 POLE AND SL WITH 20-FT MAST ARM	11 14	3S12" 3S12"	SV-1-T MAS	T T	---	---	---	BACKPLATE
⑤	STREETLIGHT	15	3S12"	SV-1-T	T				
⑥	STREETLIGHT	25	3S12"	SV-1-T	T	88	1S-COUNT	SP-1	APS
⑦	19-1-100 POLE AND SL WITH 20-FT MAST ARM	21 24	3S12" 3S12"	SV-1-T MAS	T T				BACKPLATE
⑧	1-A (7-FT)					89	1S-COUNT	TP-1	APS

***SIGNALS 41 AND 44 ARE 3S12" WITH RED BALL, YELLOW RIGHT ARROW, AND GREEN RIGHT ARROW

NO.	DATE	DESCRIPTION	BY	APP.
△	8/29/18	UPDATE PER FIELD BACKPLATE FOR 61 AND CAP VISORS FOR 61/62	DYELUNG	GDELEON
△	3/10/14	CHANGE 41 & 44 RED ARROW TO RED BALL, PER SRC 2013-306	DYELUNG	GDELEON
△	5/1/2013	SIGNAL MODIFIED THRU PHELAN LOOP CONTRACT	JT	BBD
NO.	DATE	DESCRIPTION	BY	APP.
TABLE OF REVISIONS CHECK WITH TRACING TO SEE IF YOU HAVE LATEST REVISION				

REFERENCE INFORMATION & FILE NO. OF SURVEYS
--



SAN FRANCISCO MUNICIPAL TRANSPORTATION AGENCY
CITY AND COUNTY OF SAN FRANCISCO

DRAWN:	DATE:
PY	5/2014
CHECKED:	DATE:
JT	5/2014

SCALE:
AS SHOWN
SHEET OF SHEETS
1 OF 1

TRAFFIC SIGNAL INVENTORY DIAGRAM
PHELAN AVENUE AND PHELAN LOOP

CNN NO.
52189000
REV NO.
2