


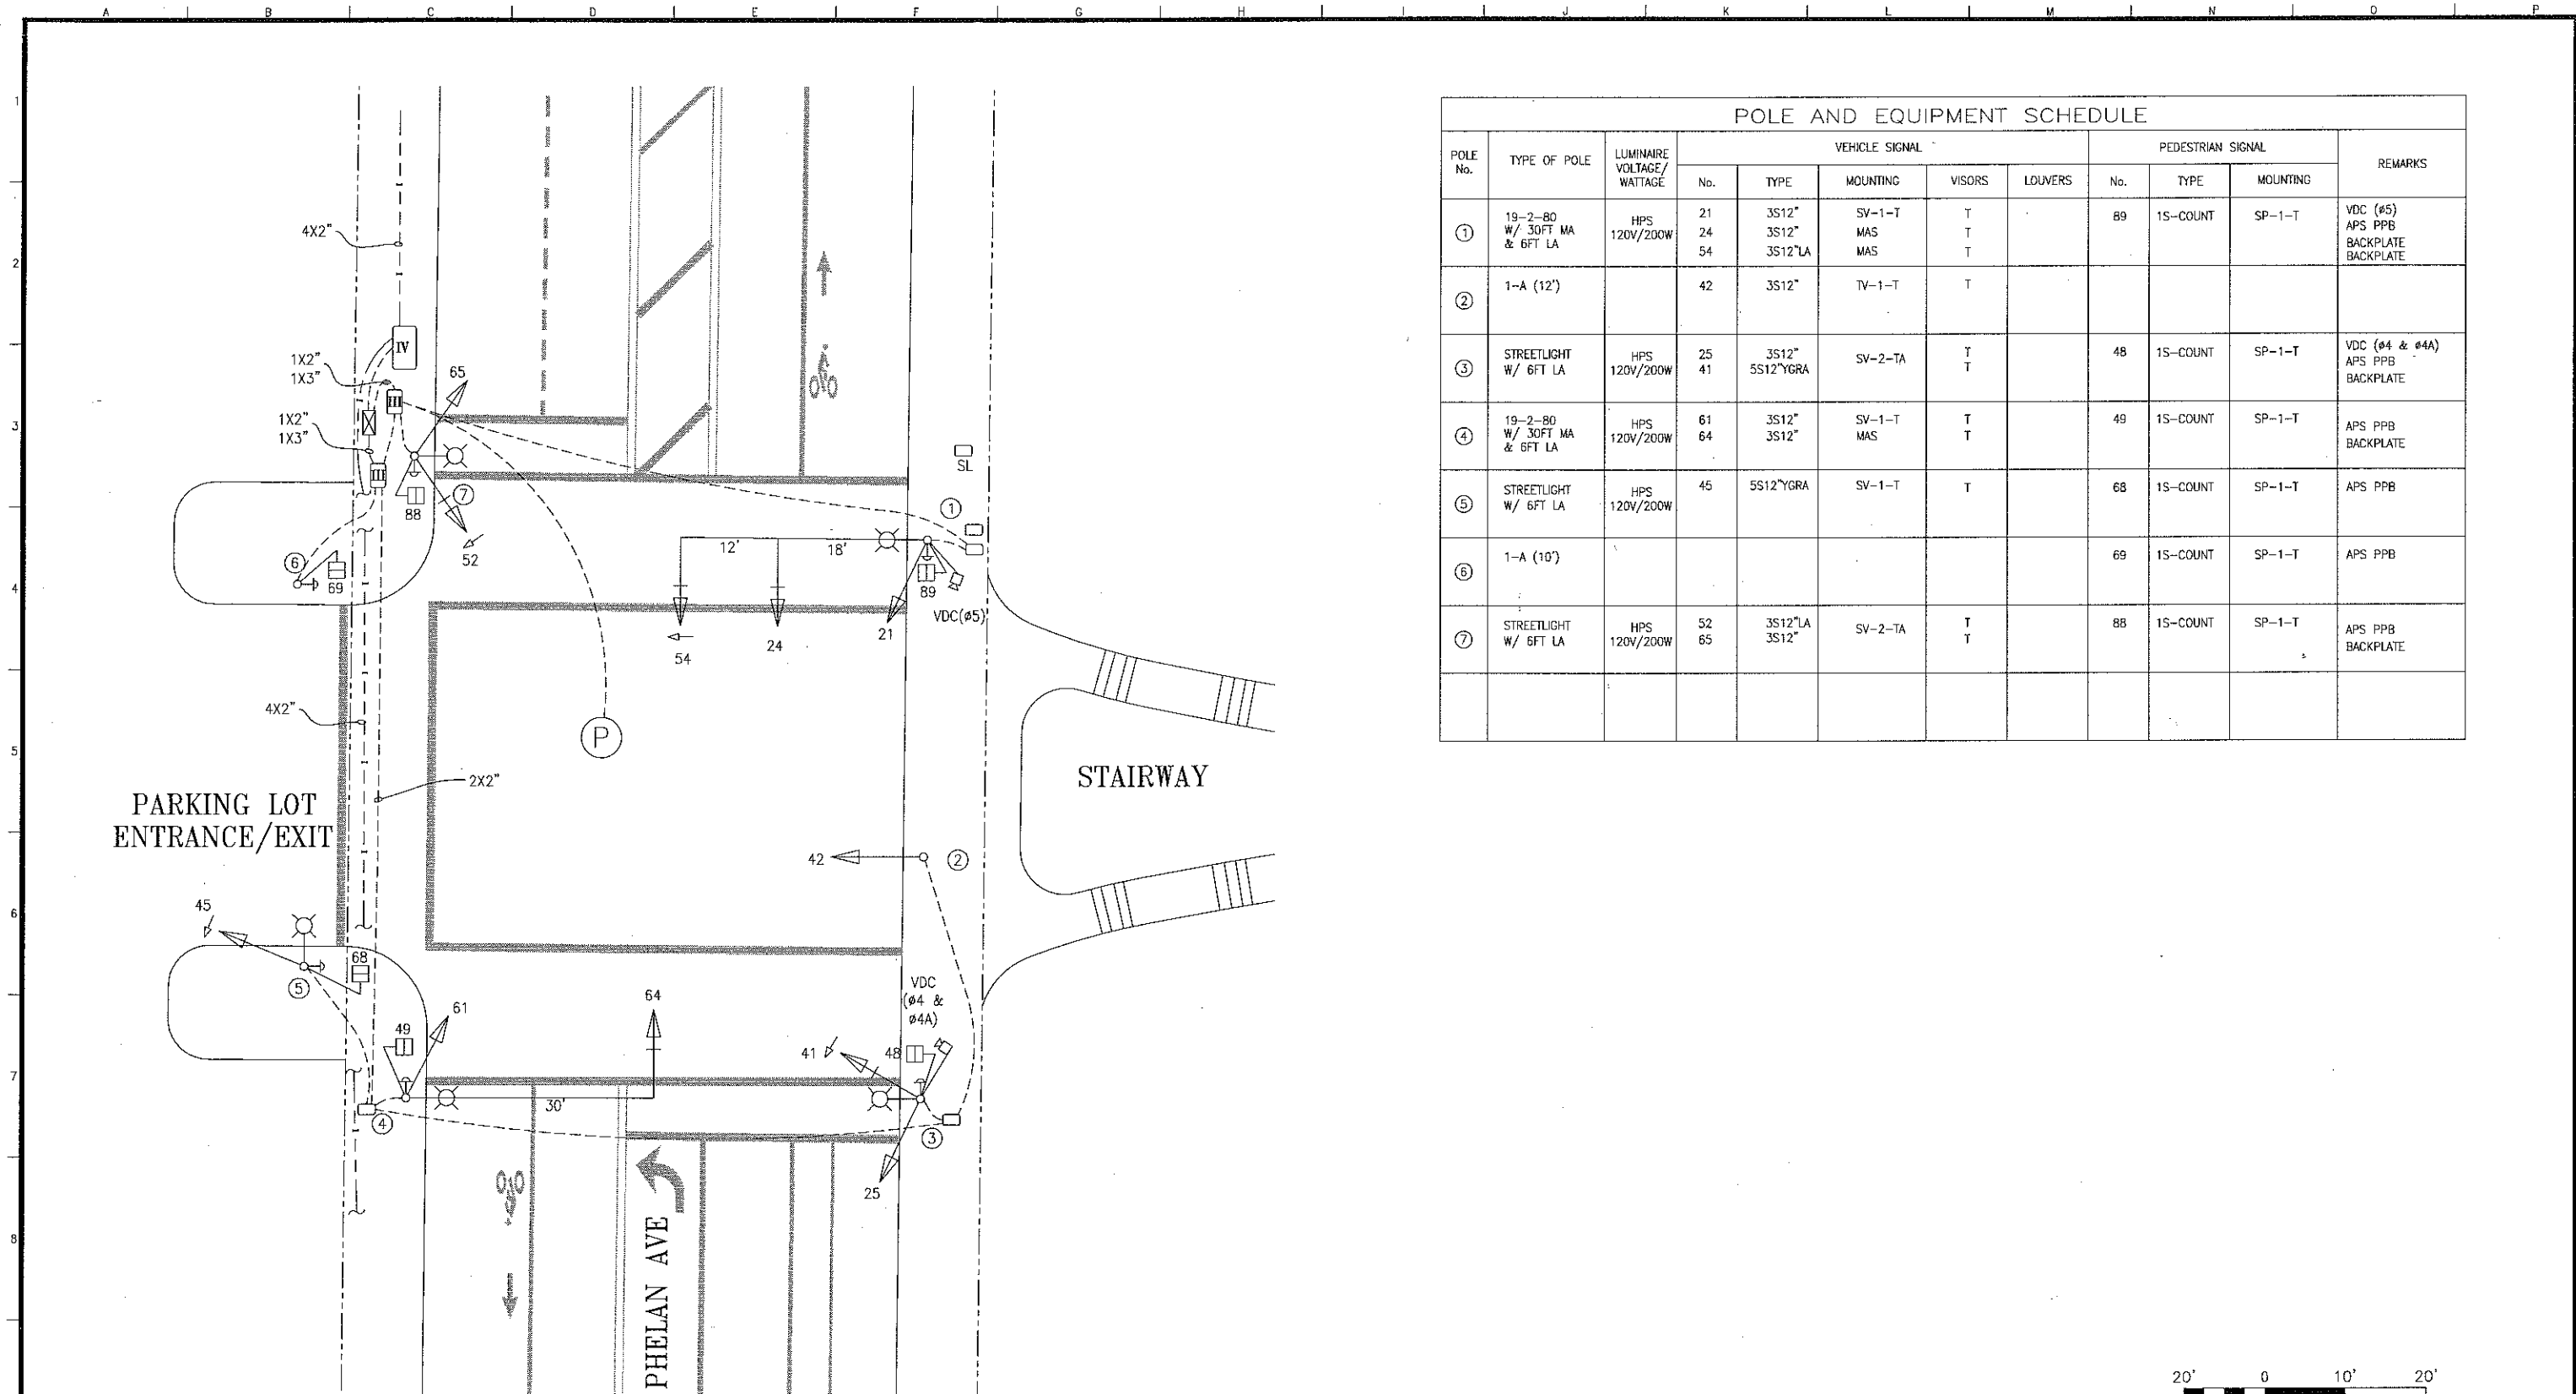

POLE AND EQUIPMENT SCHEDULE											
POLE No.	TYPE OF POLE	LUMINAIRE VOLTAGE/ WATTAGE	VEHICLE SIGNAL				PEDESTRIAN SIGNAL			REMARKS	
			No.	TYPE	MOUNTING	VISORS	LOUVERS	No.	TYPE		MOUNTING
①	19-2-80 W/ 30FT MA & 6FT LA	HPS 120V/200W	21 24 54	3S12* 3S12* 3S12*LA	SV-1-T MAS MAS	T T T		89	1S-COUNT	SP-1-T	VDC (#5) APS PPB BACKPLATE BACKPLATE
②	1-A (12')		42	3S12*	TV-1-T	T					
③	STREETLIGHT W/ 6FT LA	HPS 120V/200W	25 41	3S12* 5S12*YGRA	SV-2-TA	T T		48	1S-COUNT	SP-1-T	VDC (#4 & #4A) APS PPB BACKPLATE
④	19-2-80 W/ 30FT MA & 6FT LA	HPS 120V/200W	61 64	3S12* 3S12*	SV-1-T MAS	T T		49	1S-COUNT	SP-1-T	APS PPB BACKPLATE
⑤	STREETLIGHT W/ 6FT LA	HPS 120V/200W	45	5S12*YGRA	SV-1-T	T		68	1S-COUNT	SP-1-T	APS PPB
⑥	1-A (10')							69	1S-COUNT	SP-1-T	APS PPB
⑦	STREETLIGHT W/ 6FT LA	HPS 120V/200W	52 65	3S12*LA 3S12*	SV-2-TA	T T		88	1S-COUNT	SP-1-T	APS PPB BACKPLATE

NOTES:
1. CABINET FOUNDATION TYPE: M-SF
2. SIGNALS SWITCHED OVER 12/22/04.
3. EXISTING YELLOW LADDER CROSSWALKS DRAWN AS NORMAL CROSSWALKS FOR VISUAL CLARITY
