


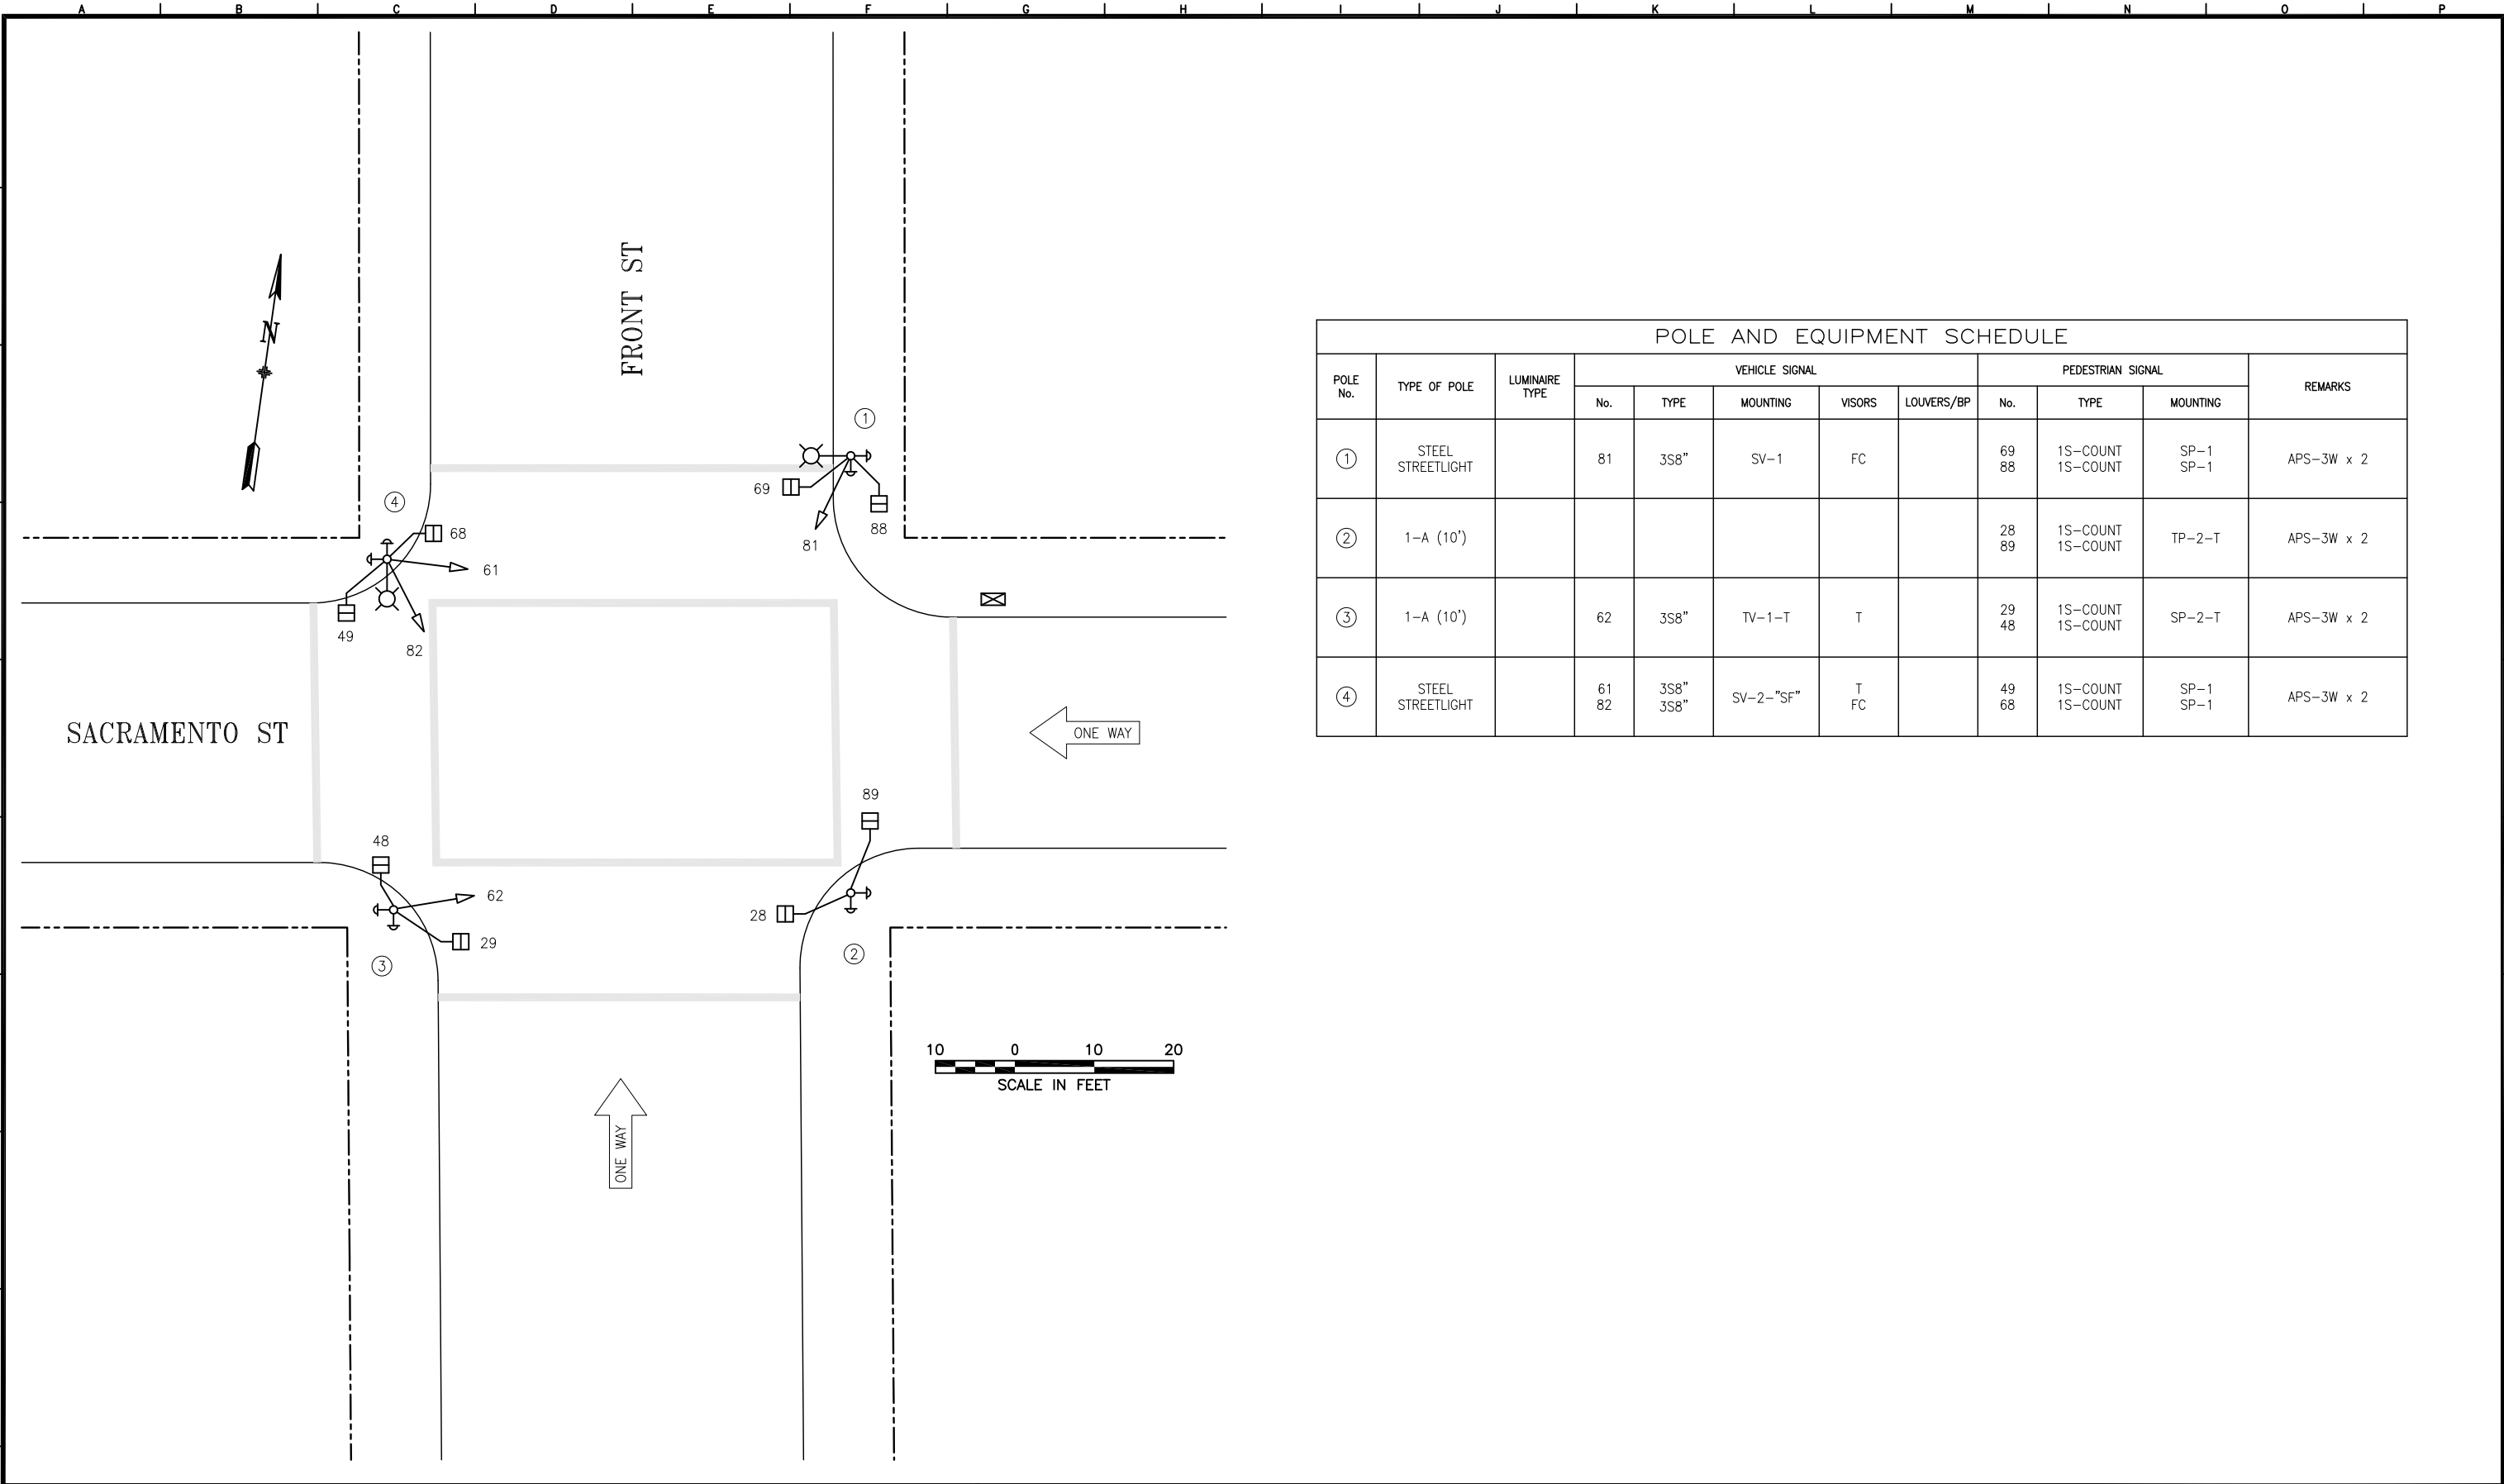

POLE AND EQUIPMENT SCHEDULE											
POLE No.	TYPE OF POLE	LUMINAIRE TYPE	VEHICLE SIGNAL					PEDESTRIAN SIGNAL			REMARKS
			No.	TYPE	MOUNTING	VISORS	LOUVERS/BP	No.	TYPE	MOUNTING	
①	STEEL STREETLIGHT		81	3S8"	SV-1	FC		69 88	1S-COUNT 1S-COUNT	SP-1 SP-1	APS-3W x 2
②	1-A (10')							28 89	1S-COUNT 1S-COUNT	TP-2-T	APS-3W x 2
③	1-A (10')		62	3S8"	TV-1-T	T		29 48	1S-COUNT 1S-COUNT	SP-2-T	APS-3W x 2
④	STEEL STREETLIGHT		61 82	3S8" 3S8"	SV-2-"SF"	T FC		49 68	1S-COUNT 1S-COUNT	SP-1 SP-1	APS-3W x 2

Δ	5/15/23	CONVERT FROM MSID. INSTALL APS (2023-027)	E. LUU	G. DE LEON	
NO.	DATE	DESCRIPTION	BY	APPROVED	

TABLE OF REVISIONS
CHECKOUT DRAWING THROUGH THE SID CUSTODIAN FOR THE LATEST REVISION



SFMTA

DRAWN BY: E. LUU	DATE: 10/2023
CHECKED BY: G. DE LEON	DATE: 10/2023

SCALE AS SHOWN	TRAFFIC SIGNAL INVENTORY DIAGRAM	CNN NO: 24691000
SHEET OF SHEETS 1 OF 1		REV NO: 0