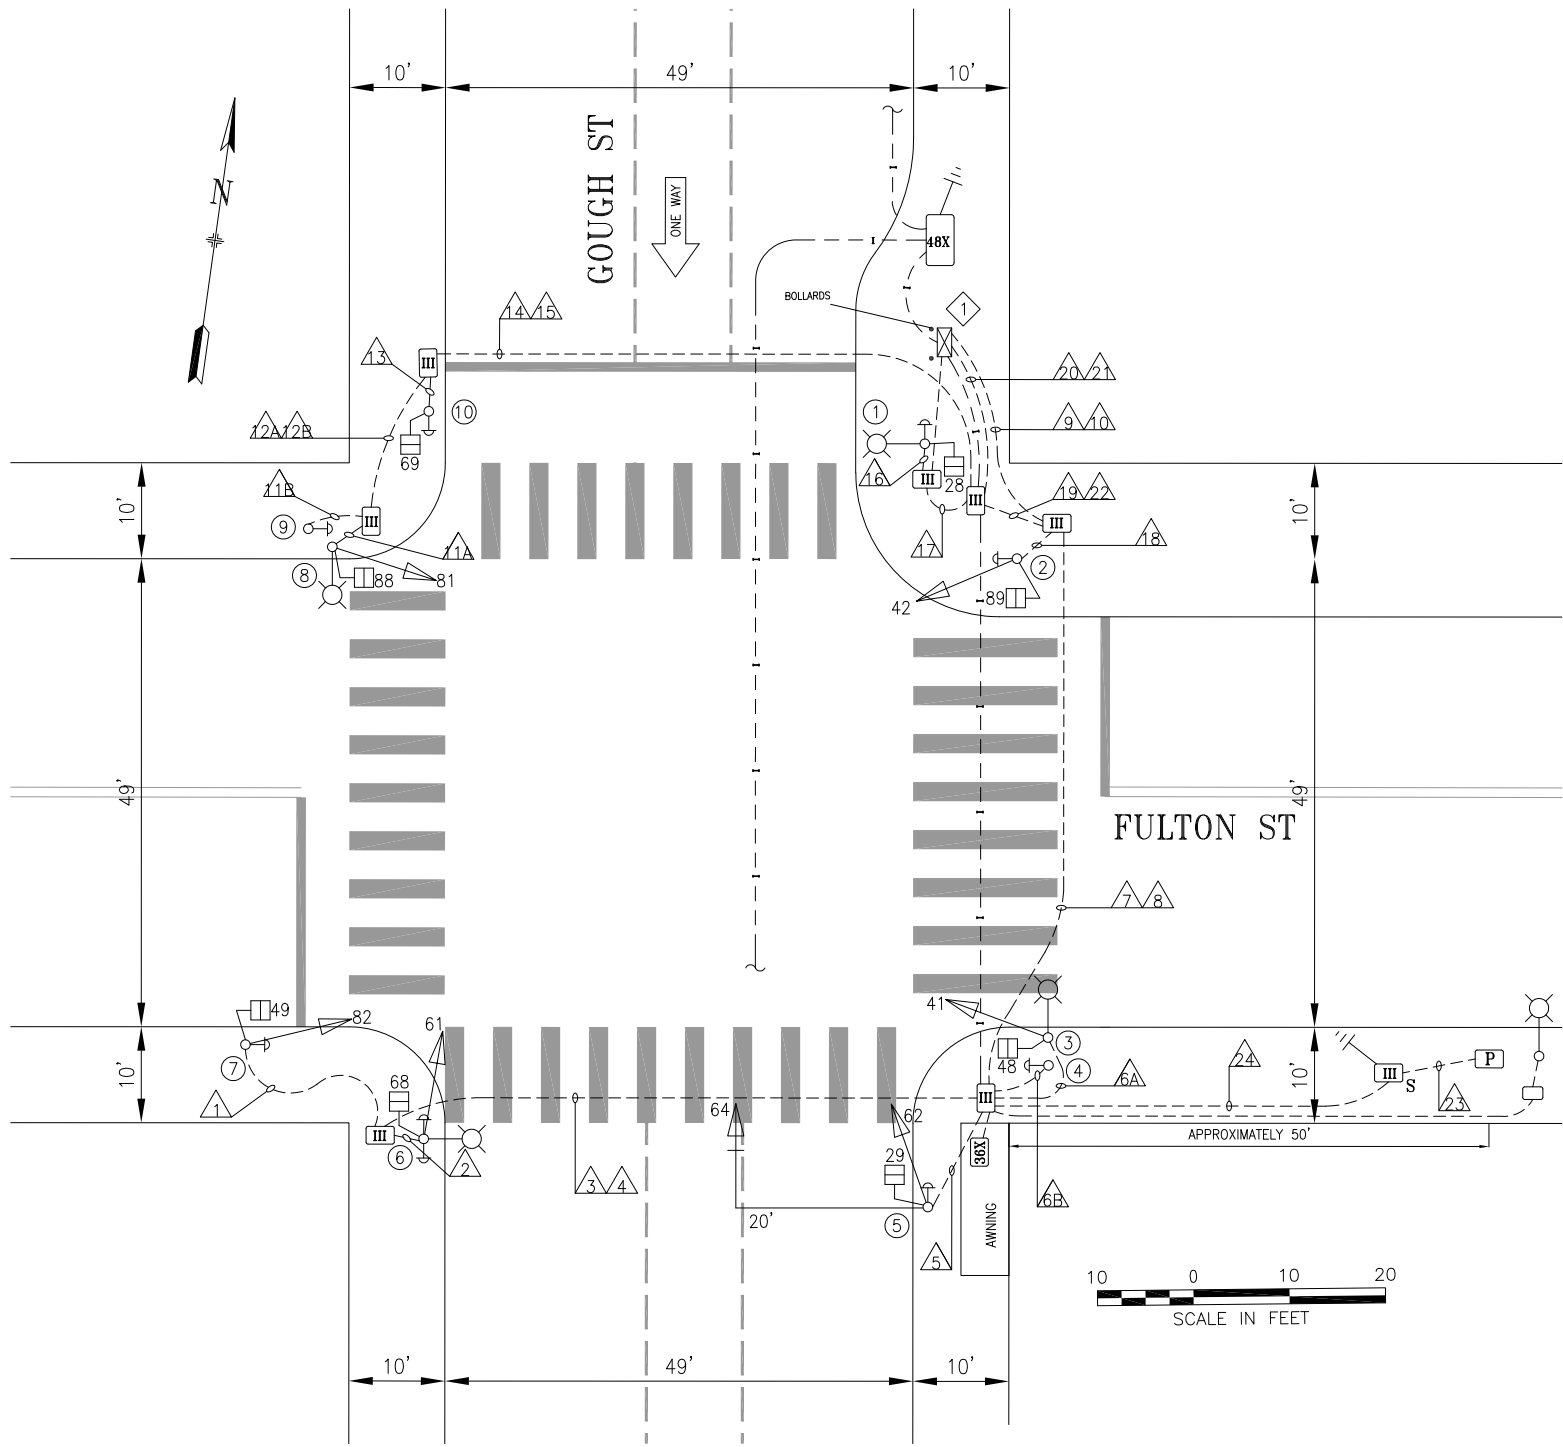


A B C D E F G H I J K L M N O P

1  
2  
3  
4  
5  
6  
7  
8  
9



POLE AND EQUIPMENT SCHEDULE											
POLE No.	TYPE OF POLE	LUMINAIRE VOLTAGE/WATTAGE	VEHICLE SIGNAL					PEDESTRIAN SIGNAL			REMARKS
			No.	TYPE	MOUNTING	VISORS	LOUVERS/BP	No.	TYPE	MOUNTING	
①	MARBELITE STREET LIGHT	LED						28	1S-COUNT	SP-1	APS-2W
②	1-A (10')		42	3S12"	TV-1-T	T		89	1S-COUNT	SP-1	APS-2W
③	MARBELITE STREET LIGHT	LED	41	3S12"	SV-1-T	T		48	1S-COUNT	SP-1	
④	PPB POLE										APS-2W
⑤	16-2-100 WITH 20' MAST ARM		62 64	3S12" 3S12"	SV-1-T MAS	T T	BP	29	1S-COUNT	SP-1	APS-2W
⑥	MARBELITE STREET LIGHT	LED	61	3S12"	SV-1-T	T		68	1S-COUNT	SP-1	APS-2W x 2
⑦	1-A (10')		82	3S12"	TV-1-T	T		49	1S-COUNT	SP-1	APS-2W
⑧	MARBELITE STREET LIGHT	LED	81	3S12"	SV-1-T	T		88	1S-COUNT	SP-1	
⑨	PPB POLE										APS-2W
⑩	1-A (7')							69	1S-COUNT	TP-1	APS-2W

SHEET NOTES

- ① CONTROLLER CABINET WITH ADAPTER PLATE

TABLE OF REVISIONS				
NO.	DATE	DESCRIPTION	BY	APP.
1	10/14/20	INSTALL APS-2W PER SRC 2020-062 AND VIA 3003J UPGRADE	C SKERRIT	DELEON
0	09/18/19	SIGNAL UPGRADE BY 3003J, CONVERTED FROM CONTRACT PLAN	C SKERRIT	DELEON

CHECK WITH TRACING TO SEE IF YOU HAVE LATEST REVISION

REFERENCE INFORMATION & FILE NO. OF SURVEYS
--



SAN FRANCISCO MUNICIPAL TRANSPORTATION AGENCY

CITY AND COUNTY OF SAN FRANCISCO

 




 




 
 
 
 


 
 




 
 
 


DRAWN:	DATE:
C SKERRIT	12/2019
CHECKED:	DATE:
G DELEON	12/2019

--

SCALE:
AS SHOWN
SHEET OF SHEETS
1 OF 2

TRAFFIC SIGNAL INVENTORY DIAGRAM
FULTON STREET AND GOUGH STREET

CNN NO.
25940000
REV NO.
1

CONDUIT AND WIRING SCHEDULE																																		
CONDUIT RUN NUMBER																																		
CONDUIT SIZE (INCH)	2	2	2	2	2	2	1	2	2	3	2	2	1	2	2	2	2	2	2	2	2	2	3	2	2	3	2							
NOTES		GRS				GRS						GRS			GRS				GRS			GRS		SP	SP		GRS							
	VEHICLE SIGNAL 82	3		3				3		3																								
	PED SIGNAL 49	2		2				2		2																								
	APS PPB XING FULTON ON POLE 7	2		2				2		2																								
	VEHICLE SIGNAL 61		3	3				3		3																								
	PED SIGNAL 68		2	2				2		2																								
	APS PPB & PPB XING GOUGH ON POLE 6		2	2				2		2																								
	VEHICLE SIGNAL 62					3		3		3																								
	VEHICLE SIGNAL 64					3		3		3																								
	PED SIGNAL 29					2		2		2																								
	APS PPB XING GOUGH ON POLE 5					2		2		2																								
	VEHICLE SIGNAL 41						3	3		3																								
	PED SIGNAL 48						2	2		2																								
	APS PPB XING FULTON ON POLE 4						2	2		2																								
	VEHICLE SIGNAL 81											3		3			3							3										
	PED SIGNAL 88											2		2			2						2											
	APS PPB XING FULTON ON POLE 9												2	2			2						2											
	PED SIGNAL 69															2	2						2											
	APS PPB XING GOUGH ON POLE 10															2	2						2											
	PED SIGNAL 28																		2	2			2											
	APS PPB XING GOUGH ON POLE 1																		2	2			2											
	VEHICLE SIGNAL 42																					3	3	3										
	PED SIGNAL 89																					2	2	2										
	APS PPB XING FULTON ON POLE 2																					2	2	2										
	#14 NEUTRAL	2	2			3	2					2		2		1			1	1	2													
	#14 SPARE			3				3		3							3						3											
	TOTAL #14 WIRES	9	9	17		13	7	2	34	34		7	2	9		5	14		5	5	9	7	25											
	#10 WIRES NEUTRAL			1				2		2							1					1	2											
	#10 WIRES STREET LIGHT																																	
	#8 WIRES STREET LIGHT				2				2						2						2								2					
	#8 WIRES (120 V SERVICE)								2		2																		2					
	#8 WIRES (120/240 V SERVICE)																											3						
	#6 BSCW																																	
	INTERCONNECT 12C CABLE																																	

[illegible]