


FULTON & Great Highway

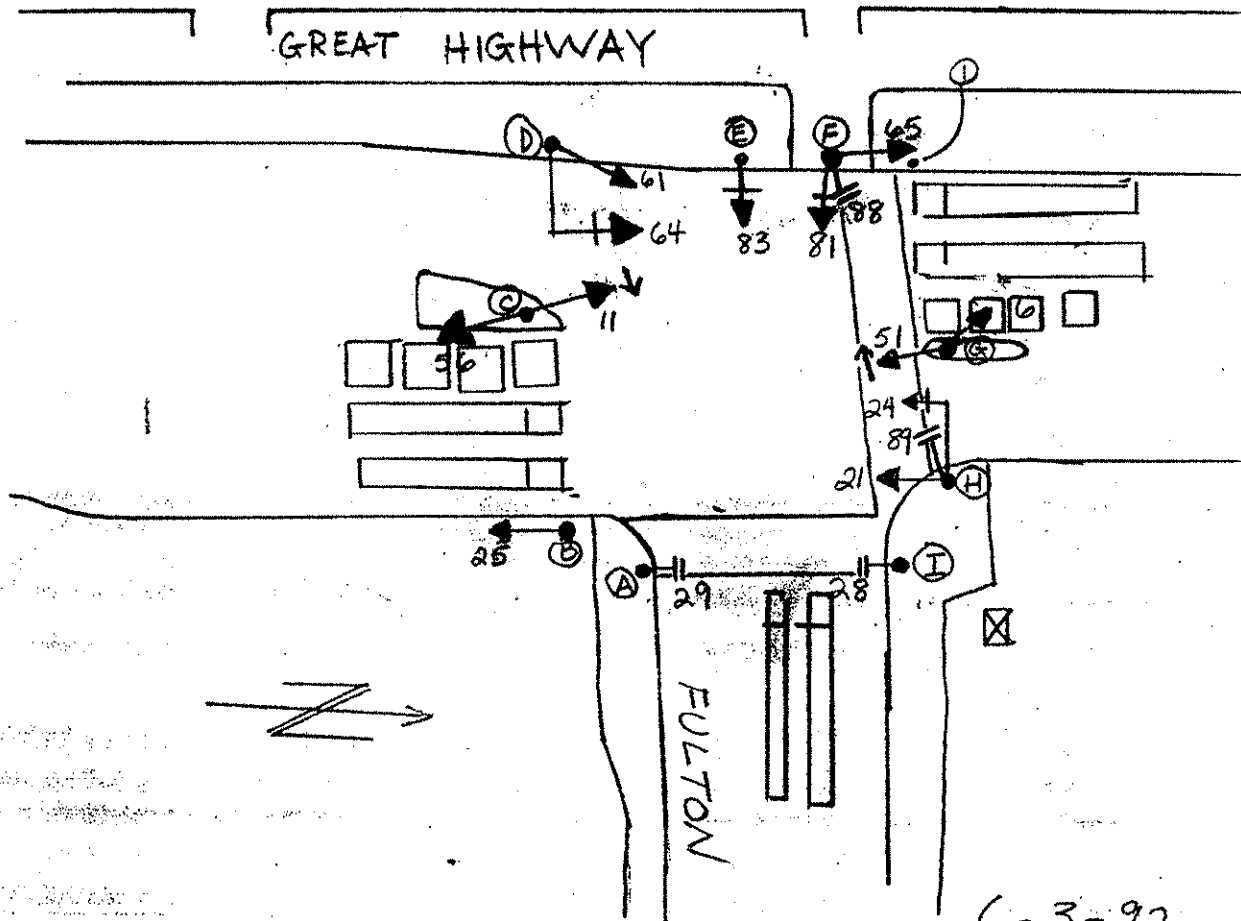

POLE	FUNC.	MAT'L	SIGNAL NO.	MAKE	NO. OF SECT.	SIZE	VISOR	B.P. OR LOUVERS	MOUN'T	PED SIGNAL NO.	LEGEND	MESSAGE		MAKE	MOU
												ELEMENT	COLOR		
A	L	S	25	TCT	3	12"	12"FC	NO	S	28	I	IS-I	W/OR	ICC	T
B	L	S	56	TCT	3	12" RY G	12"FC	NO	S	29	I	IS-I	W/OR	ICC	S
C	S	S	11	TCT	3	12" RY G	12"FC	NO	T	88	I	IS-I	W/OR	ICC	S
D	L	S	64	TCT	3	12"	12"FC	BP	MAS	89	I	IS-I	W/OR	ICC	S
E	S	S	61	TCT	3	12"	12"FC	NO	S						
F	S	S	83	TCT	3	12"	12"FC	BP	T						
G	S	S	21	TCT	3	12"	12"FC	BP	T						
H	L	S	65	TCT	3	12"	12"FC	NO	T						
I	S	S	16	TCT	3	12" RY G	12"FC	NO	S						
1	L	S	51	TCT	3	12" RY G	12"FC	NO	T						
			24	TCT	3	12"	12"FC	BP	MAS						
			21	TCT	3	12"	12"FC	NO	S						

CONTROLLER CABINET SIZE : LARGE BASE CABINET : ---

COMMENTS : TYPE "P" CABINET