


FULTON & HYDE

HYDE
ST.


FULTON
ST.

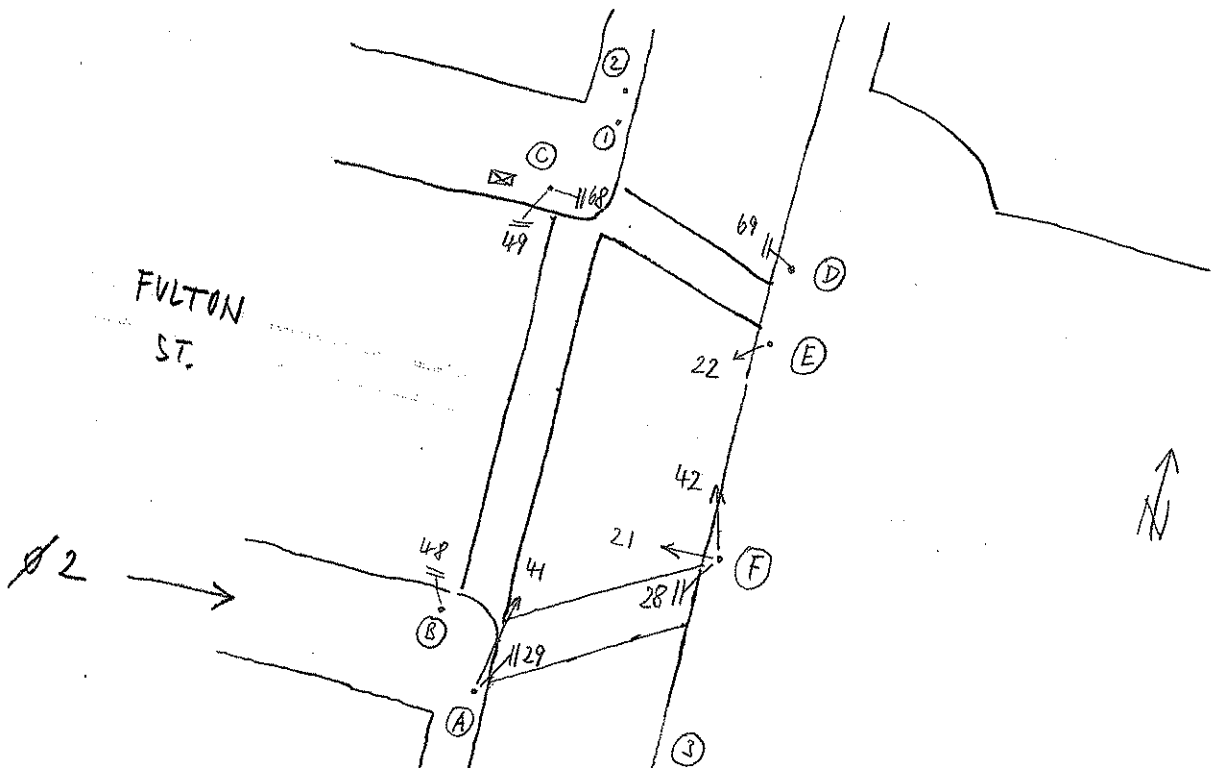

FULTON & HYDE

HYDE
ST.FULTON
ST.

Ø 2 →

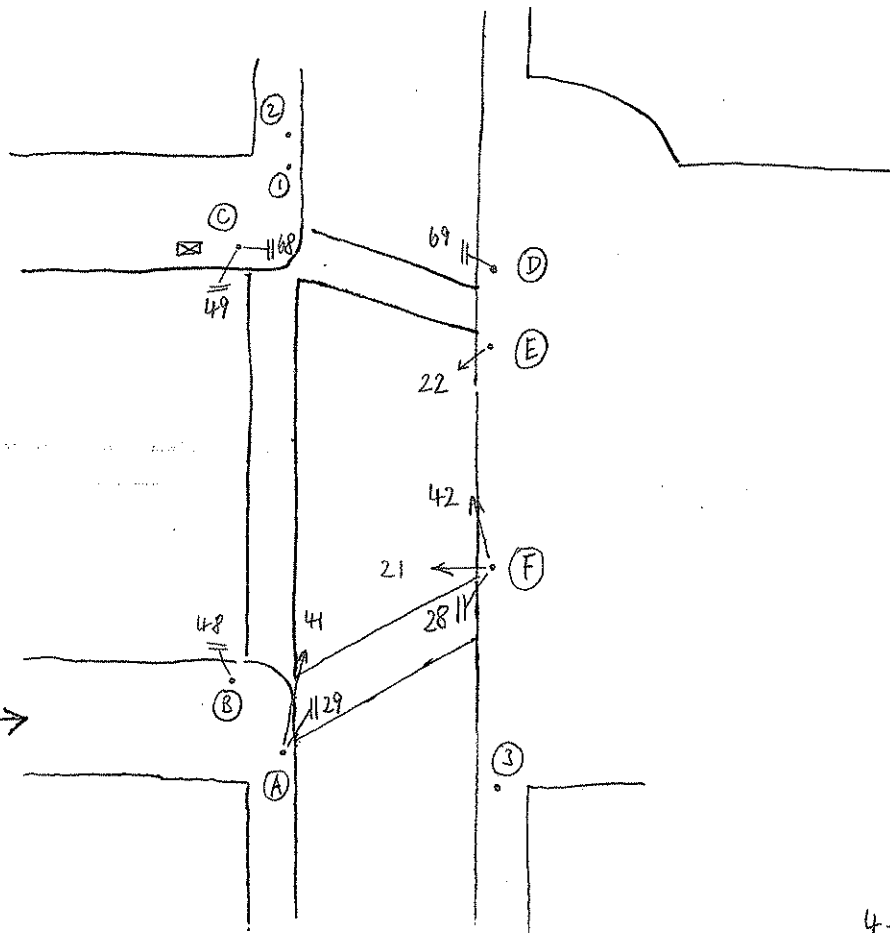

4-5-96

POLE	FUNC.	MAT'L	SIGNAL NO.	MAKE	NO. OF SECT.	SIZE	VISOR	B.P. OR LOUVERS	MOUN'T	PED SIGNAL NO.	LEGEND	MESSAGE		MAKE	MOUN'T
A	S	C	41	EA	3	12"	FC 12"	NO	T	29	I	IS-I	W/OR	TCT	T
B	L	C								48	I	IS-I	V/OR	TCT	S
C	S	C								49	I	IS-I	W/OR	ICC	T
D	S	C								69	I	IS-I	W/OR	TCT	T
E	S	C	22	EA	3	12"	FC 12"	NO	T						
F	S	C	21	EA	3	12"	FC 12"	NO	T						
F	S	C	42	EA	3	12"	FC 12"	NO	T	28	I	IS-I	W/OR	TCT	S
C	S	C								68	I	IS-I	V/OR	ICC	T

CONTROLLER CABINET SIZE : ORDINARY BASE CABINET : YESCOMMENTS :