


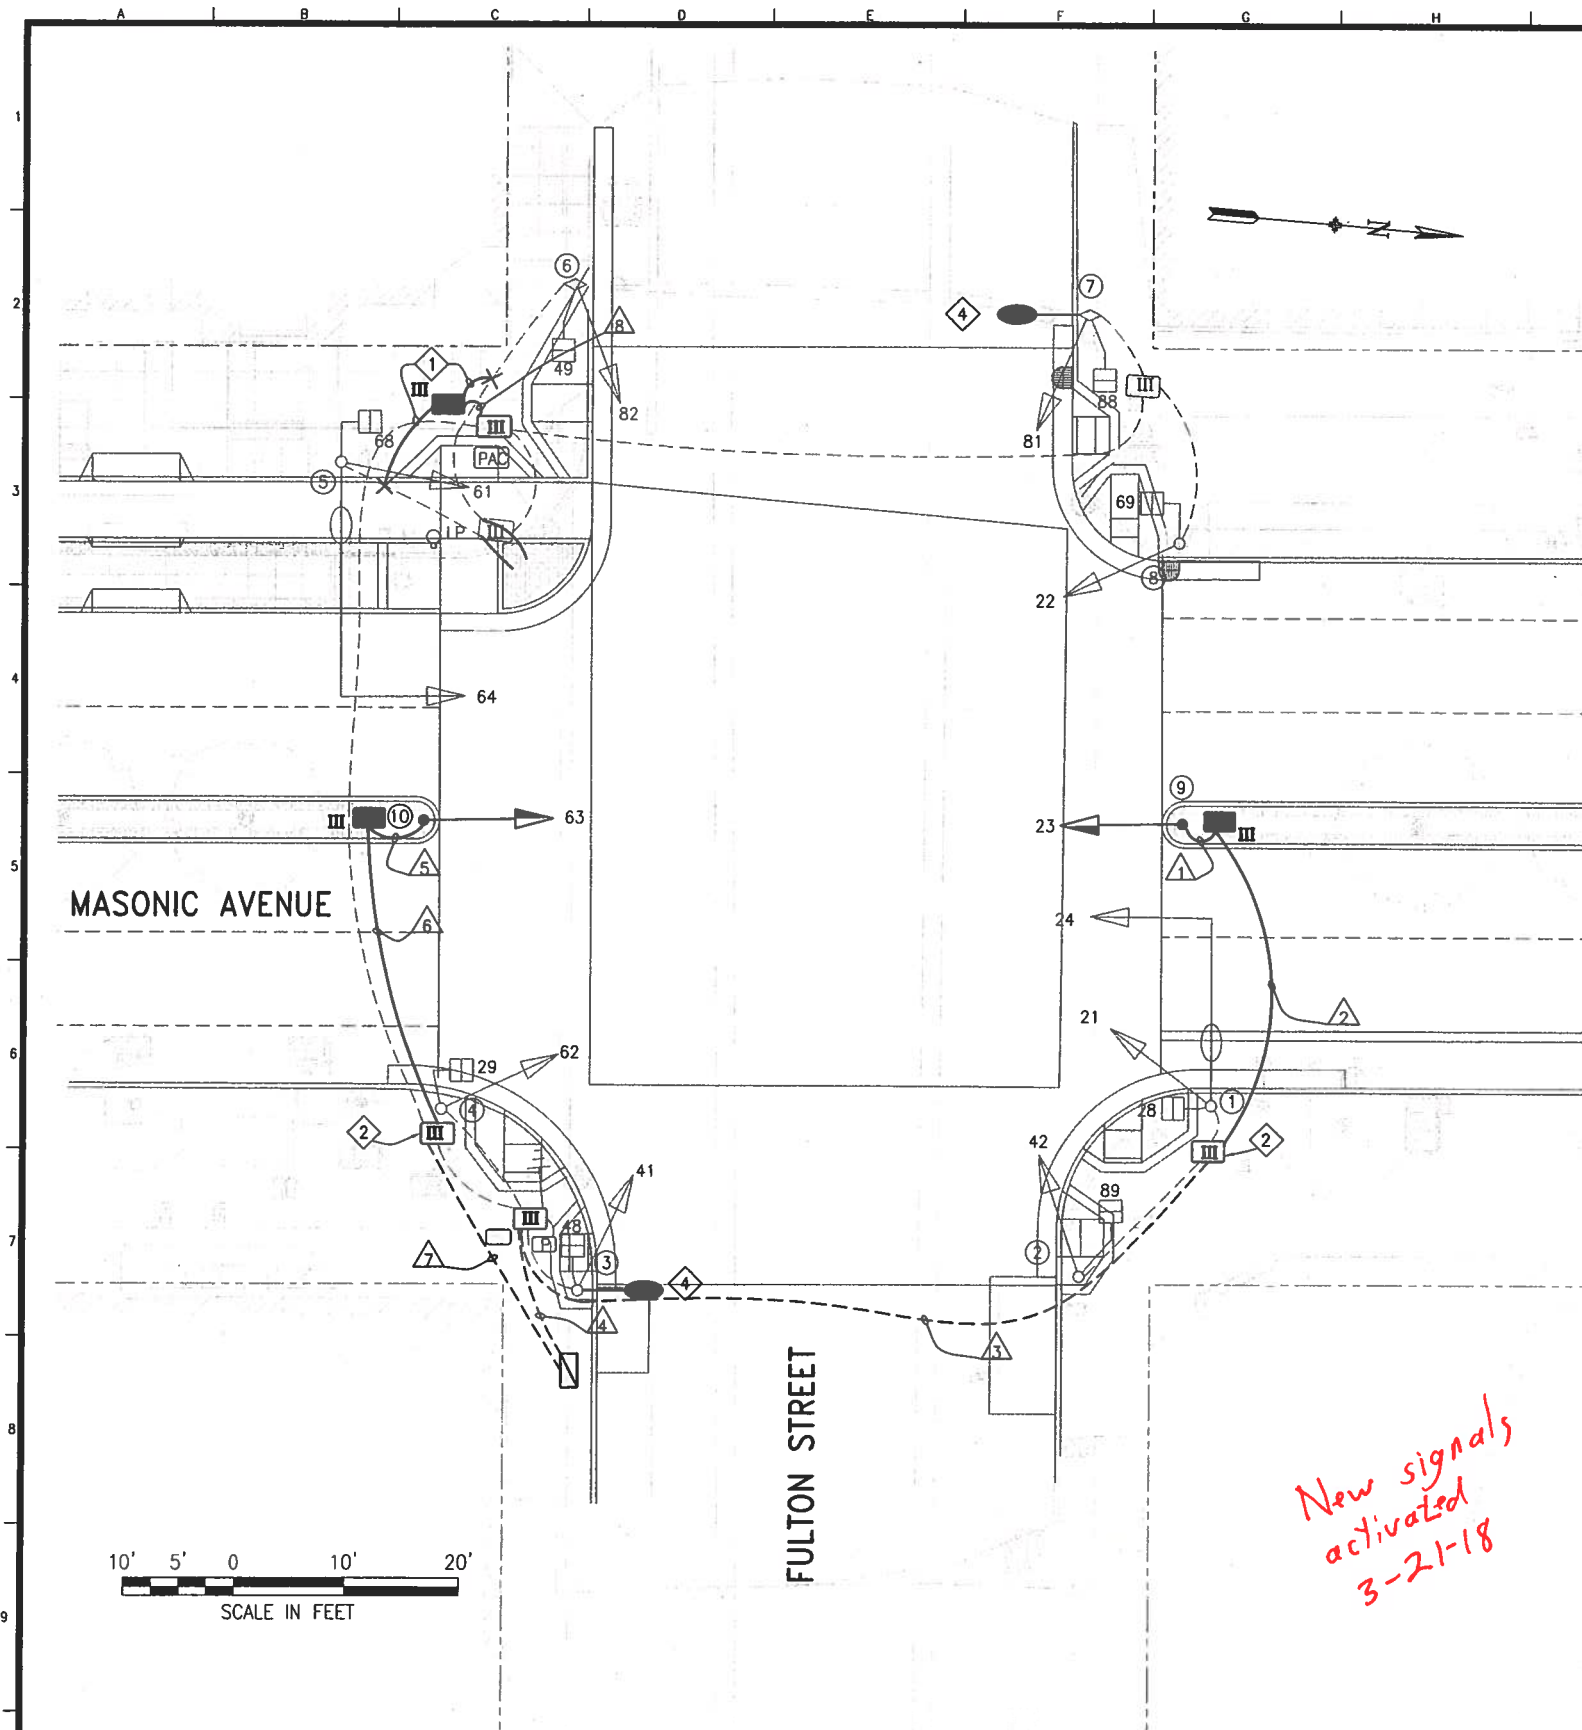

POLE AND EQUIPMENT SCHEDULE											
POLE No.	TYPE OF POLE	LUMINAIRE VOLTAGE/WATTAGE	VEHICLE SIGNAL					PEDESTRIAN SIGNAL			REMARKS
			No.	TYPE	MOUNTING	VISORS	LOUVERS/BP	No.	TYPE	MOUNTING	
①	17-2-100 WITH 20' MAST ARM AND 6' LUMINAIRE ARM	150W	21	3S12"	SV-1-T	T		28	1S-COUNT	SP-1	
			24	3S12"	MAS	T	BP				
②	1-A (10')		42	3S12"	TV-1-T	T		89	1S-COUNT	SP-1	
③	MARBELITE SL		41	3S12"	SV-1-T	T		48	1S-COUNT	SP-1	
④	1-A (13')		62	3S12"	TV-1-T	T		29	1S-COUNT	SP-1	
⑤	19-2-100 WITH 25' MAST ARM AND 12' LUMINAIRE ARM	150W	61	3S12"	SV-1-T	T		68	1S-COUNT	SP-1	
			64	3S12"	MAS	T	BP				
⑥	MUNI FEEDER		82	3S12"	SV-1-T	T		49	1S-COUNT	SP-1-T	EX EXTERNAL CONDUITS
⑦	MUNI SL		81	3S12"	SV-1-T	T		88	1S-COUNT	SP-1	
⑧	1-A (13')		22	3S12"	TV-1-T	T		69	1S-COUNT	SP-1	
⑨	1-A (15')		23	3S12"	SV-1-T	T					VEHICLE HEAD MOUNTED @ 10'
⑩	1-A (15')		63	3S12"	SV-1-T	T					VEHICLE HEAD MOUNTED @ 10'

SHEET NOTES:

- INTERCEPT EXISTING CONDUIT AND COUPLE NEW CONDUIT TO MATCH. RE-PULL EXISTING WIRES TO NEW PULLBOX LOCATION IF FEASIBLE, ELSE PROVIDE NEW WIRES TO MATCH EXISTING FOR ALL AFFECTED CIRCUITS.
- SPLICE NEW #14 NEUTRAL WIRES TO EXISTING #10 NEUTRAL.
- RE-PULL EXISTING WIRES TO PULLBOX TO ENSURE CONTINUITY OF CIRCUIT, ELSE PROVIDE NEW WIRES TO MATCH FOR ALL AFFECTED CIRCUITS.
- STREETLIGHT FIXTURE TO BE PROVIDED BY STREETLIGHT CONTRACTOR SEE E-1.1 DRAWINGS FOR STREETLIGHT FIXTURE DETAILS.


CONDUIT AND WIRING SCHEDULE

(FURNISH AND INSTALL CONDUIT)


CONDUIT RUN NUMBER		1	2	3	4	5	6	7	8
CONDUIT SIZE (INCH)		2	2	2 EX	2 EX	2	2	2 EX	2 3
NOTES	VEHICLE SIGNAL 23	3	3	3	3				
	VEHICLE SIGNAL 63					3	3	3	
	#14 NEUTRAL	1				1			
	#14 SPARE		3				3		
	TOTAL #14 WIRES	4	6	3	3	4	6	3	
	#10 NEUTRAL		1				1		
	#10 WIRES STREET LIGHT								
	#6 BSCW (SEE DRAWING E-0.6)								

NO.	DATE	DESCRIPTION	BY	APP.
TABLE OF REVISIONS				

REFERENCE INFORMATION
& FILE NO. OF SURVEYS

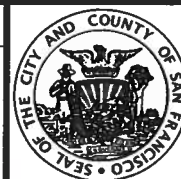

INFRASTRUCTURE DIVISION
DEPARTMENT OF PUBLIC WORKS
CITY AND COUNTY OF SAN FRANCISCO

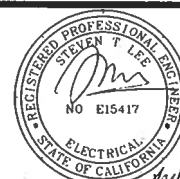

DESIGNED: DATE: 8/21/2015
W.CHAN
DRAWN: DATE: 8/21/2015
W.CHAN
CHECKED: DATE: 8/21/2015
S.LEE

APPROVED
SECTION MANAGER
DEPUTY DIVISION MANAGER
DIVISION MANAGER

SCALE:
AS SHOWN
SHEET OF SHEETS
OF

MASONIC AVENUE
STREETSCAPE IMPROVEMENTS

MASONIC AVENUE AND FULTON STREET
TRAFFIC SIGNAL WORK

CONTRACT NO.
2370J
DRAWING NO.
ET-3.0
FILE NO.
101,271
REV. NO.