




POLE AND EQUIPMENT SCHEDULE											
POLE No.	TYPE OF POLE	LUMINAIRE VOLTAGE/ WATTAGE	VEHICLE SIGNAL					PEDESTRIAN SIGNAL			REMARKS
			No.	TYPE	MOUNTING	VISORS	LOUVERS	No.	TYPE	MOUNTING	
①	MUNI										APS
②	MUNI W/6' LUMINAIRE ARM		22	3S12"	SV-1	T		69 88	1S-COUNT 1S-COUNT	SP-2-T-SF	APS
③	PPB POLE										APS
④	MUNI		21 42	3S8" 3S8"	SV-2-T-SF	FC FC		89	1S-COUNT	SP-1-T	EXT. COND.
⑤	MUNI W/6' LUMINAIRE ARM		27 41 66	3S8" 3S8" 3S8"	SV-3-TA	FC FC FC		28	1S-COUNT	SP-1	
⑥	MUNI W/6' LUMINAIRE ARM										APS
⑦	PPB POLE										APS
⑧	MARBELITE (10')		47 62	3S8" 3S8"	TV-2-T	FC FC		29 48	1S-COUNT 1S-COUNT	SP-2-T-SF	APS
⑨	MUNI		82	3S8"	SV-1-T	FC					EXT. COND.
⑩	1-A (13')		61 81	3S12" 3S12"	TV-2-T-SF	T T		49 68	1S-COUNT 1S-COUNT	SP-1-SF (12") SP-1 (22")	APS
⑪	MUNI W/6' LUMINAIRE ARM										APS APS

2	5/12/15	CHANGE POLE 11 PPB TO APS	ET	MV	
1	1/12/15	ADDED APS, APS POLES, ONE PPB, NEW POLE 10	MV	ET	
0	1/14/09	SIGNAL UPGRADE ACTIVATED THRU CT 32; CONVERTED FROM AS-BUILTS	GD	BC	
NO.	DATE	DESCRIPTION	BY	APP.	
TABLE OF REVISIONS CHECK WITH TRACING TO SEE IF YOU HAVE LATEST REVISION					

REFERENCE INFORMATION & FILE NO. OF SURVEYS
--

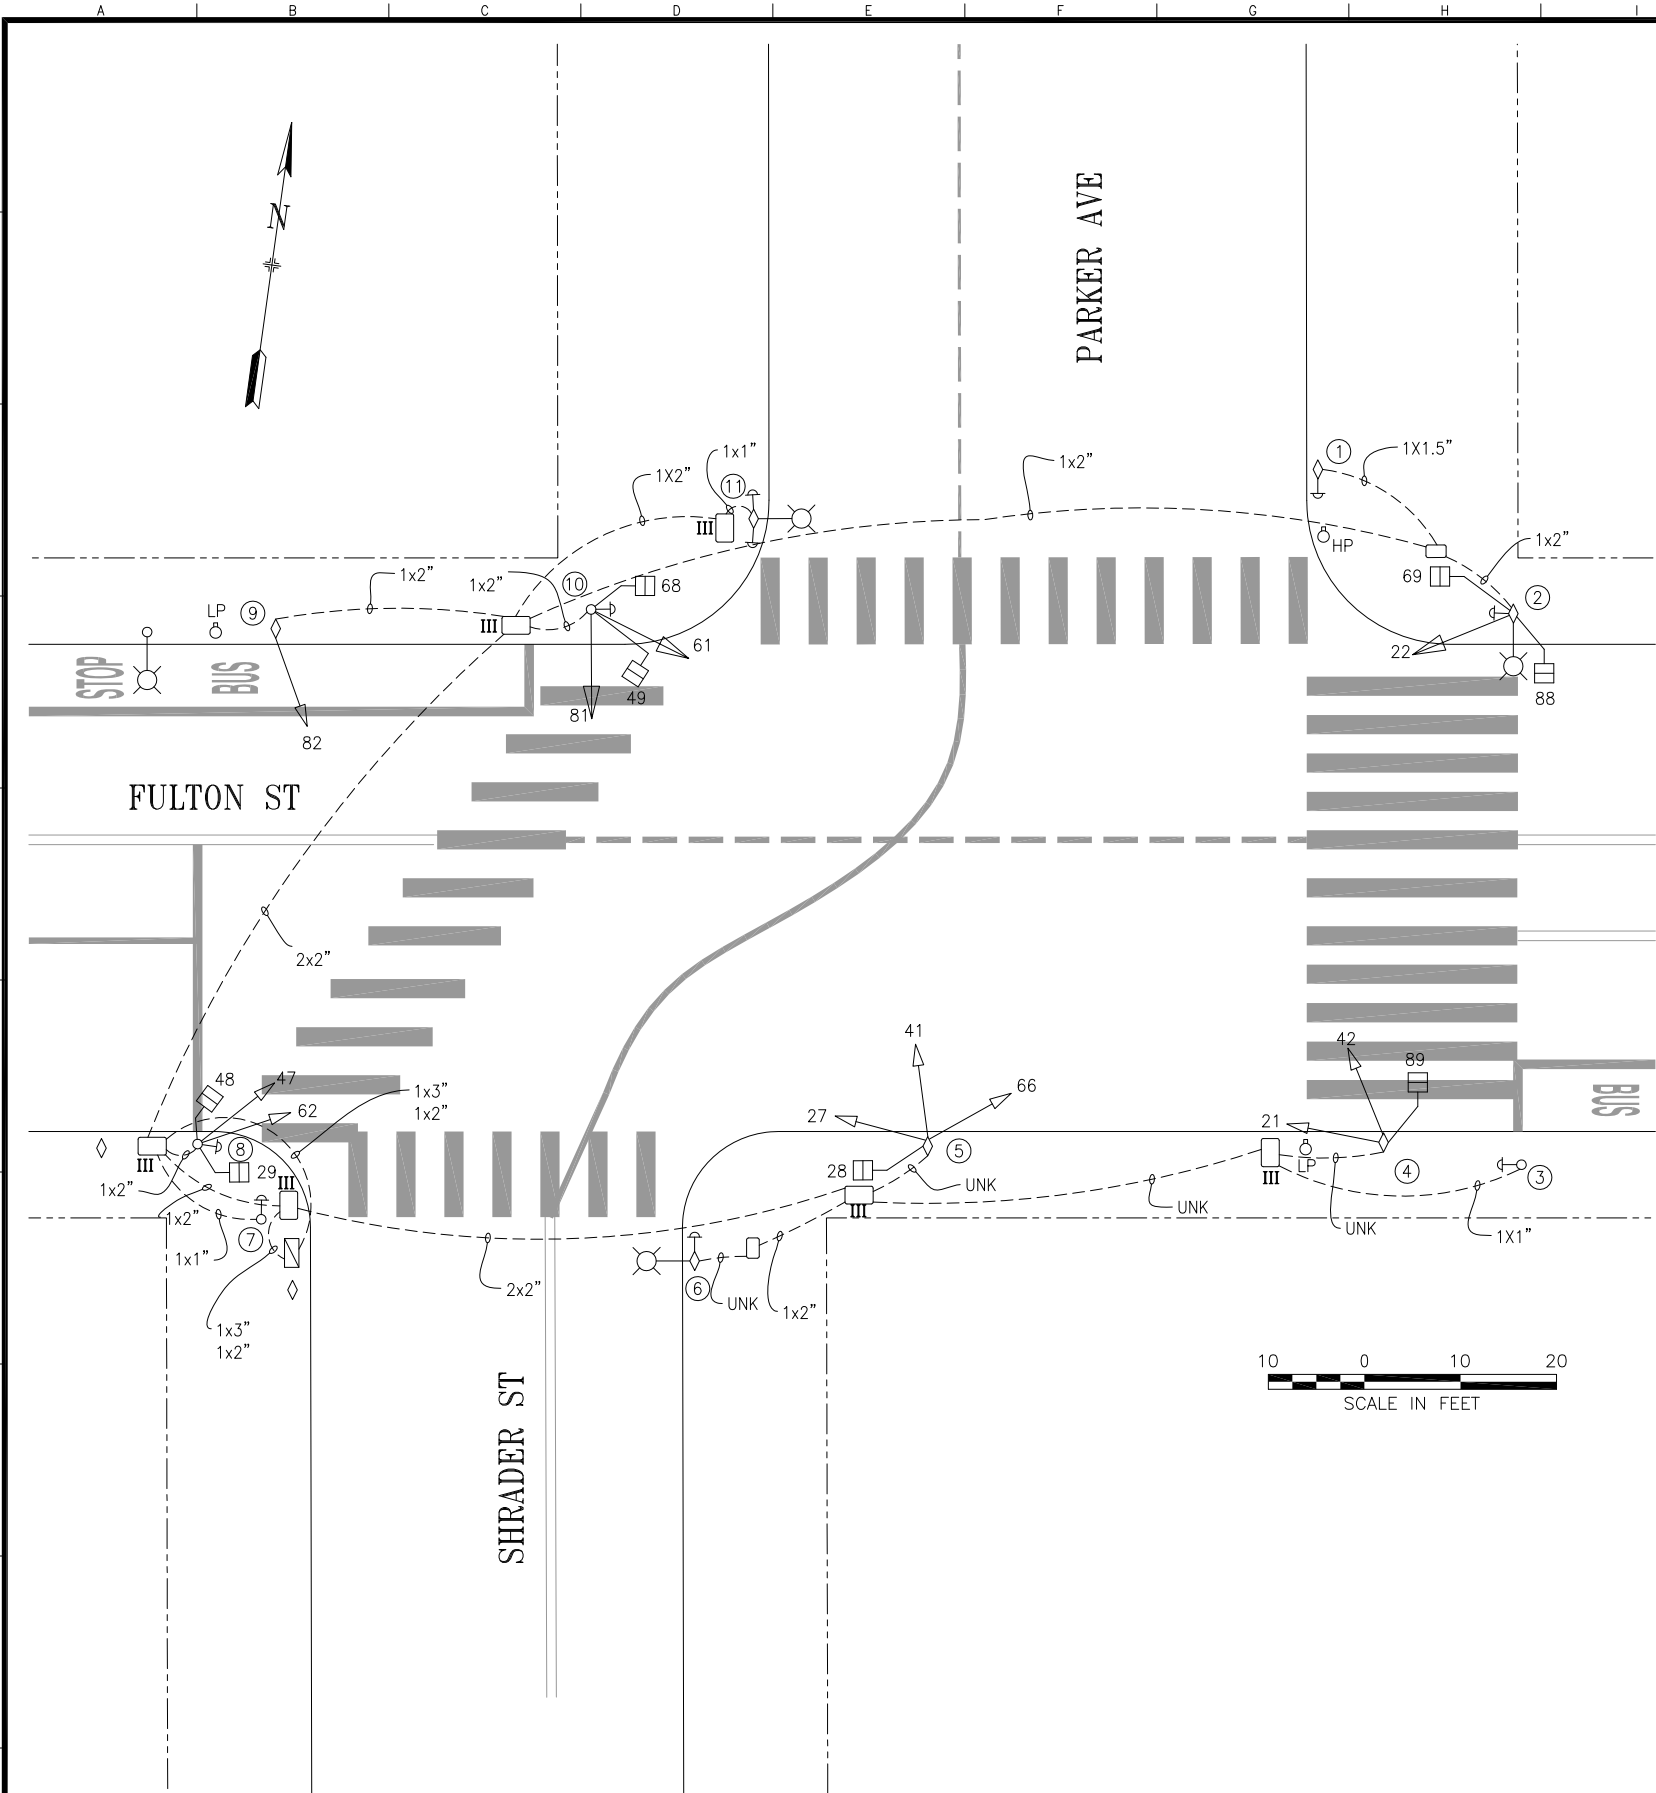

SAN FRANCISCO MUNICIPAL TRANSPORTATION AGENCY

CITY AND COUNTY OF SAN FRANCISCO

DRAWN:	DATE:
ASCALES	9/2015
CHECKED:	DATE:
MYELASCO	9/2015

SCALE: AS SHOWN
SHEET OF SHEETS 1 OF 1

TRAFFIC SIGNAL INVENTORY DIAGRAM
FULTON STREET, SHRADER STREET, PARKER STREET

CNN NO. 26471000
REV NO. 0