

DRAWING INFORMATION:

FILE NAME: E-3
ORIGIN: ELECTRICAL
DATE: --/--/--

LIMITS: (0,0), (340',220')
PLOT SCALE: 1"=10'-0"

NO.	DATE	DESCRIPTION	BY	APP.
1	8/7/00	AS-BUILT	NMO	NKS
CHECK WITH TRACING TO SEE IF YOU HAVE LATEST REVISION				

REFERENCE INFORMATION & FILE No. OF SURVEYS

BUREAU OF ENGINEERING
DEPARTMENT OF PUBLIC WORKS
CITY AND COUNTY OF SAN FRANCISCO


DESIGNED:	DATE:
NO	8/97
DRAWN:	DATE:
RT/JS	8/97
CHECKED:	DATE:

APPROVED
SECTION MANAGER
DIVISION MANAGER
CITY ENGINEER

SCALE:
1"=10'-0"
SHEET OF SHEETS
3 OF 7

FUNSTON / LINCOLN NEW TRAFFIC SIGNAL - CONTRACT 50 SAN FRANCISCO, CA
FUNSTON AVE. & LINCOLN WAY TRAFFIC SIGNAL WORK


SPECIFICATION NO. 1301N
DRAWING NO. E-3
FILE NO. 68,372
REV. NO. 1

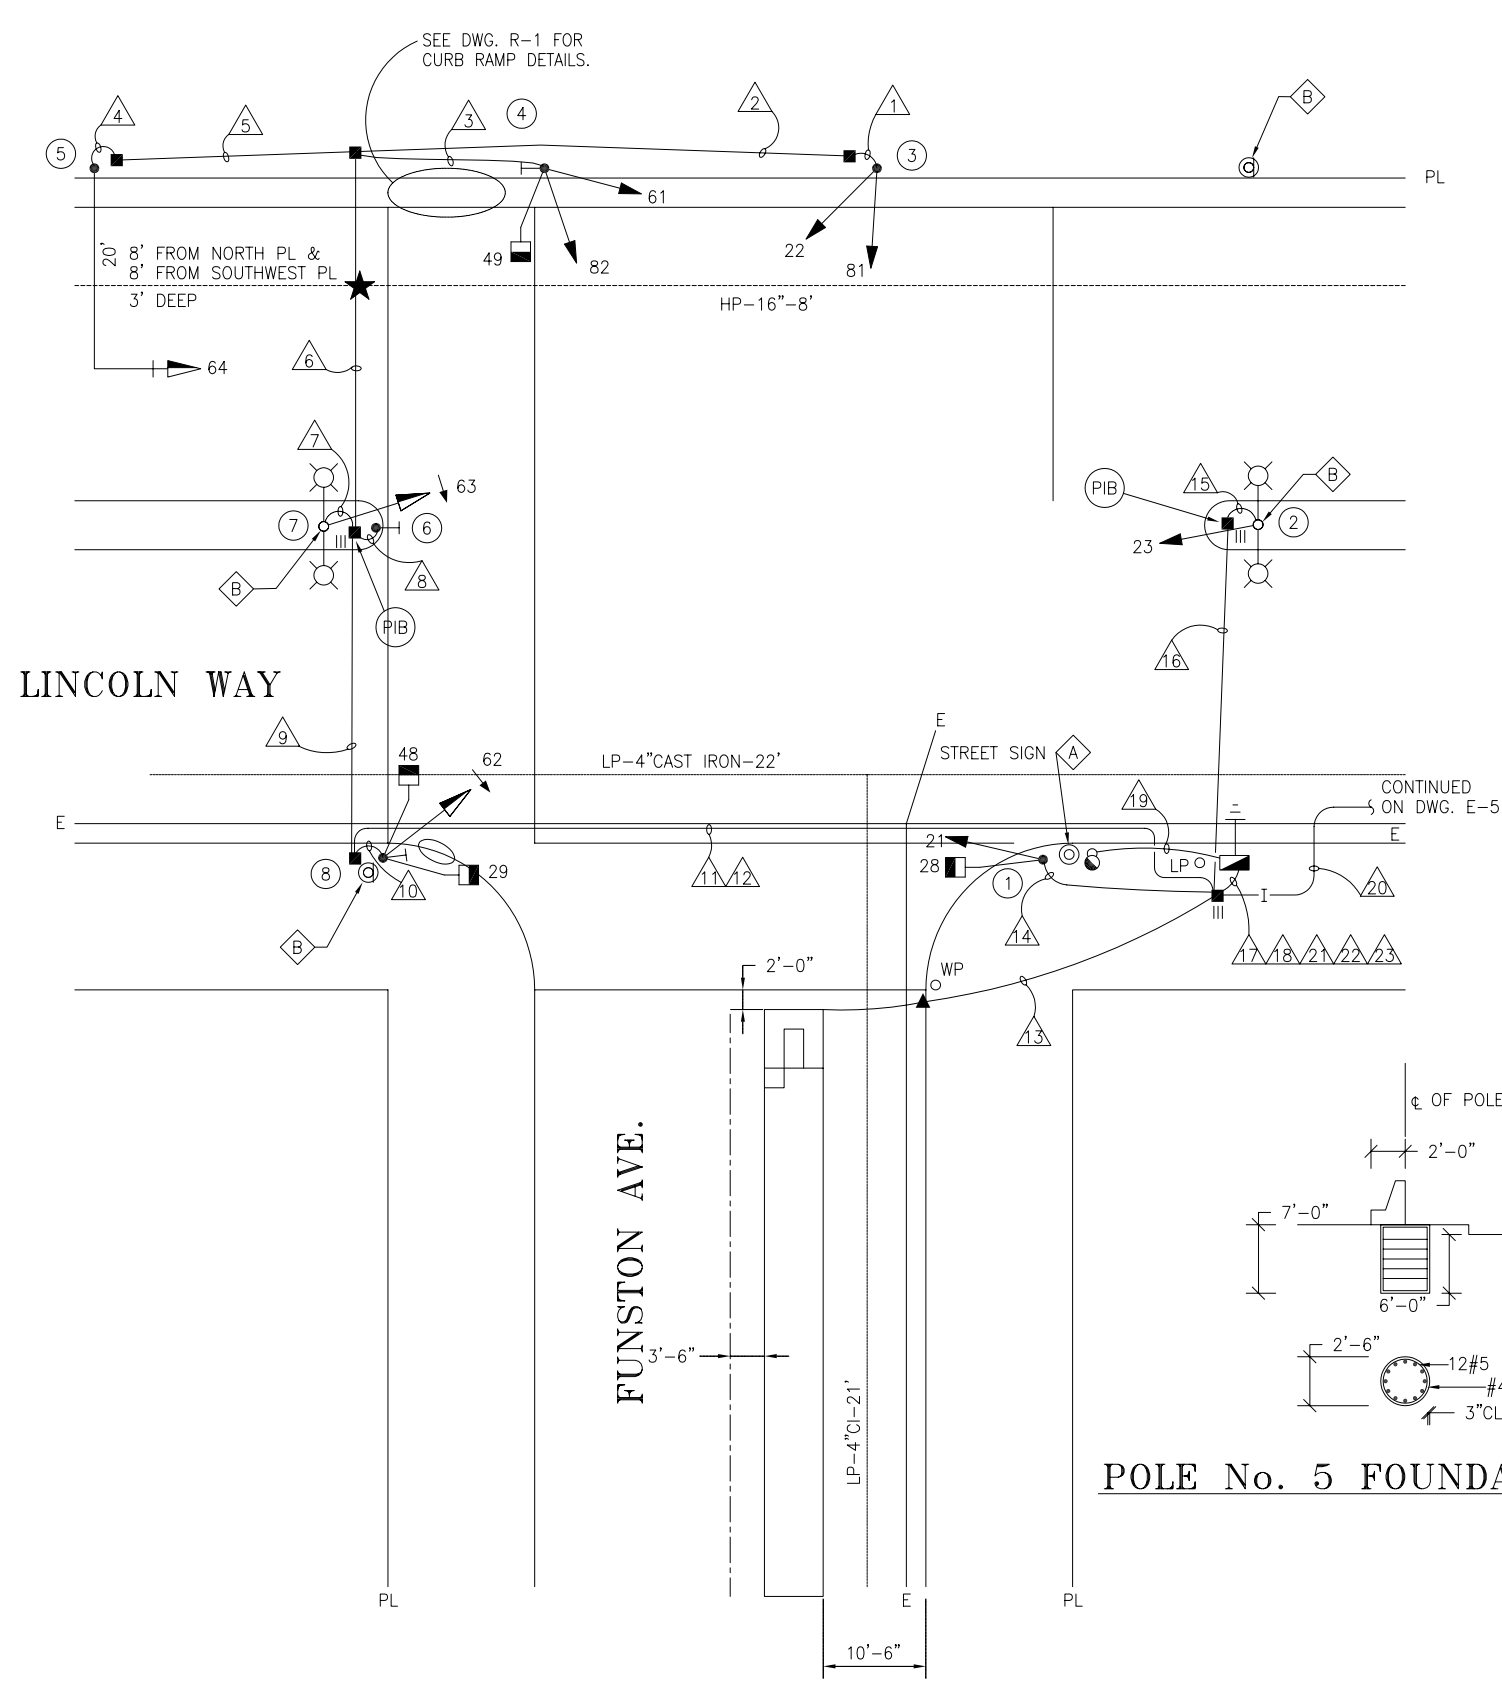

DETAIL NOTES

- A R/S EXISTING STREET SIGN AND MOUNTING HARDWARE. RETURN TO TRAFFIC SIGN SHOP AT 1999 BRYANT STREET. PROVIDE WRITTEN NOTIFICATION OF LOCATION WHERE STREET NAME SIGN WAS REMOVED.
- B R/S EXISTING STOP SIGN WHEN TRAFFIC SIGNALS ARE IN OPERATION.


PHASE DIAGRAM:

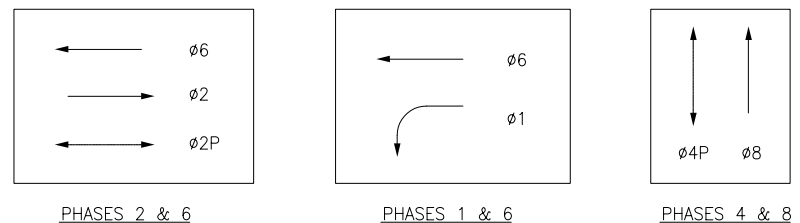

PHASE SEQUENCE:

G	Y	R	LINCOLN WESTBOUND
OFF	G	OFF	LINCOLN WESTBOUND LEFT
G	Y	R	LINCOLN EASTBOUND
R	G	Y	FUNSTON
RH	WM	FRH	PED XING LINCOLN
WM	FRH	RH	PED XING FUNSTON

POLE No. 5 FOUNDATION DETAIL

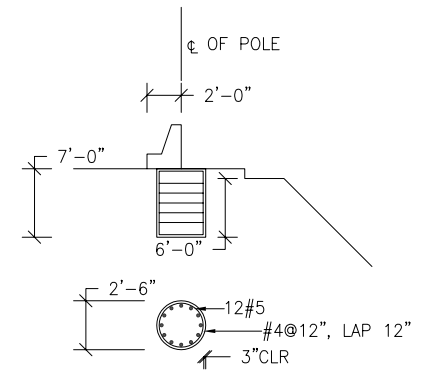

AS BUILT DRAWING
APPROVAL SIGNATURES ON ORIGINAL CONTRACT DRAWINGS.

