


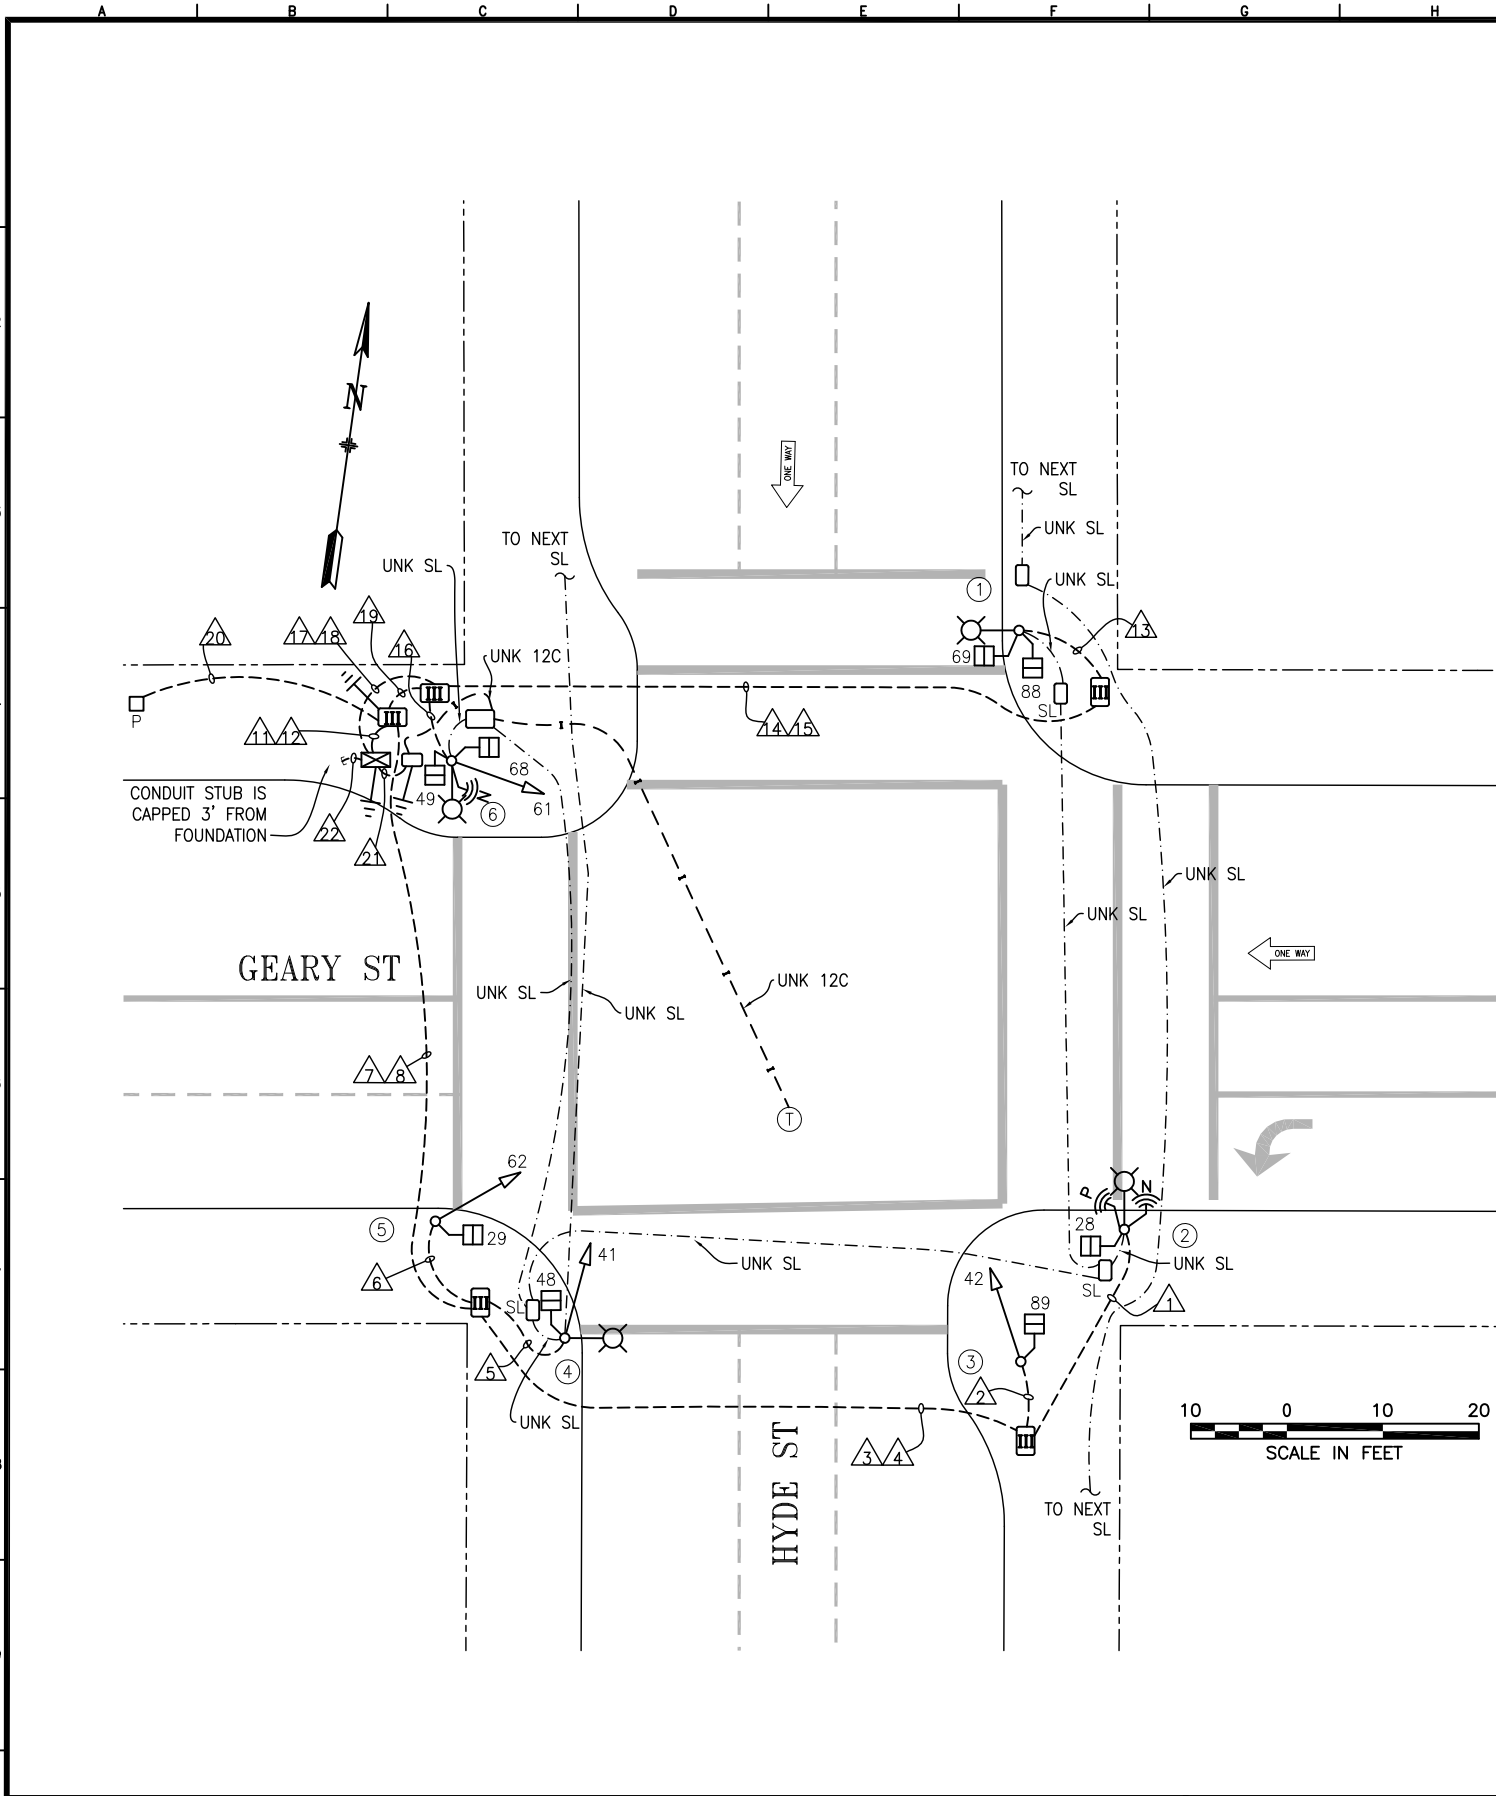

POLE AND EQUIPMENT SCHEDULE										
POLE No.	TYPE OF POLE	VEHICLE SIGNAL					PEDESTRIAN SIGNAL			REMARKS
		No.	TYPE	MOUNTING	VISORS	LOUVERS/BP	No.	TYPE	MOUNTING	
①	STREETLIGHT						69 88	1S-COUNT 1S-COUNT	SP-1 SP-1	
②	STREETLIGHT						28	1S-COUNT	SP-1	TSP RADIO NETWORK RADIO
③	1-A (10')	42	3S8"	TV-1	T		89	1S-COUNT	SP-1	
④	STREETLIGHT	41	3S8"	SV-1-T	T		48	1S-COUNT	SP-1	
⑤	1-A (10')	62	3S8"	TV-1	T		29	1S-COUNT	SP-1	
⑥	STREETLIGHT	61	3S8"	SV-1-T	T		49 68	1S-COUNT 1S-COUNT	SP-1-SF (12") SP-1 (22")	NETWORK RADIO

8/15/23	UPDATE PER FIELD: TYPE III BOXES AND NOTE NETWORK/TSP RADIOS	D. YEUNG	G. DE LEON		
4/6/05	CONVERTED FROM CONTRACT 0480J AS-BUILT	D. YEUNG	G. DE LEON		
NO.	DATE	DESCRIPTION	BY	APPROVED	

TABLE OF REVISIONS
CHECKOUT DRAWING THROUGH THE SID CUSTODIAN FOR THE LATEST REVISION



DRAWN BY: D. YEUNG	DATE: MAR 2023
CHECKED BY: G. DE LEON	DATE: MAR 2023

SCALE AS SHOWN	TRAFFIC SIGNAL INVENTORY DIAGRAM	CNN NO: 25166000
SHEET OF SHEETS 1 OF 2		REV NO: 1

[illegible]