

01/03

DEPUTY MANAGER

SHEET OF SHEETS

DEPARTMENT OF PUBLIC WORKS

CITY AND COUNTY OF SAN FRANCISCO

↑ 06/30/04 RELOCATE POLE #5

80,245

FILE NO.

REV. NO.


TRAFFIC SIGNAL PLAN

GEARY ST AND JONES ST INTERSECTION

POLE	TYPE OF POLE	LUMINAIRE (HPS)		<u></u>	VEHICLE SIGNAL			HEDULE							
No.	TIPE OF PULE	VOLTAGE/ WATTS	No.	TYPE	 	Т	7	<u> </u>	PEDESTRIAN	REMARKS					
		WATTS	110.	*IFE	MOUNTING	VISORS	LOUVERS	No.	TYPE .	MOUNTING	1,Em #110				
1	EX. SL							69 88	1S-COUNT 1S-COUNT	SP-1-SF (12") SP-1 (22")					
②	EX. SL			•				28	1S-COUNT	SP-1					
3	1-A (10')		42_	3\$8"	TV−1 ⁻	T .		89	1S-COUNT	SP-1.					
④	EX. SL		41	358*	SV-1-T	Т		48	1S-COUNT	SP-1					
(5)	1-A (10')		62	358"	TV1	Т		29	1S-COUNT	SP-1					
6	EX. SL		61	J\$8*·	SV-1-T	т		. 49 68	1S-COUNT 1S-COUNT	SP-1-SF (12") SP-1 (22")	· · · · · ·				

ATE DESCRIPTION
TABLE OF REVISIONS
CHECK WITH TRACING TO SEE IF YOU HAVE LATEST REVISION

CONDUIT AND WIRING SO CONDUIT RUN NUMBER CONDUIT SIZE (INCH) CONDUIT SIZE (mm)			JA	12	$ \mathcal{A} $	14	<u></u>	6	A	<u>8</u>	4	10	A	13	A	14	A	1	13	18	13	Γ
			2 53	2 53	2	3	2	2	2 53	2	2	2	-2	2	2	3	2.,	2	2	<u>/10\</u> 2	1.5	H
															-	+		_	53	ļ	41	-
NOTES			(E)		<u> </u>		SP		(E)			-	(E)		-	-		SP	SP	(E)		
					-								` _		· ·							H
	SIGNAL 61	•	3	3		3										_						-
	SIGNAL 49		2	2		2						1						<u> </u>				-
	SIGNAL 68		2	2		2								_		-						Г
	SIGNAL 69				2	2																
	SIGNAL 88	*			2	2						_										Г
	SIGNAL 62 .							3		3	-			3		3						_
	SIGNAL 29							2		2				2		2						
	SIGNAL 41								3	3				3		3		-				
	SIGNAL 48								2	2				2		2						_
	SIGNAL 42	7					\neg					3.		3		3						_
	SIGNAL 89		1									2 ·		2		2						
	SIGNAL 28								7				2	2		2						_
							\dashv			~											-	_
,							\dashv										Ť		,		-	_
		•									·				•							
							,		-			-				-			_			_
		•					\neg			\neg					\dashv	\dashv		-	-			
	·								-							7	\neg					_
	#14 NEUTRAL		3		2			2	2	\dashv		2	1		-	-						
	#14 SPARE			3		3			\dashv	3				3		3	\dashv					_
	TOTAL #14 WIRES	•	10	10	6	14	7	7	7	13		7	3	20	_	20						
	#10 WIRES NEUTRAL	٠,		1		2	\dashv			1				2	_	2		.		$\neg \uparrow$	\dashv	_
	#10 WIRES STREET LIGHT												1		_	-		. +	_			
	#8 WIRES STREET LIGHT					\neg			\neg	1				•		-				1	\dashv	_
	#8 WIRES (120 V SERVICE)					1	\neg						_		1	2					2	_
	#6 BSCW	•				\dashv	1	$\neg \uparrow$					i'	-		1	\neg				1	_
	INTERCONNECT 12C CABLE									寸	2		7		2		2	\dashv		2		_
	DLW (DETECTOR LOOP WIRE)				T		\neg		一				-	-				1	-		\dashv	-
	DLC (DETECTOR LED-IN-CABLE)	•				十			1			\neg	-				\dashv		\dashv	\dashv		—
	PRE-EMPTION					1				-					- 1							_

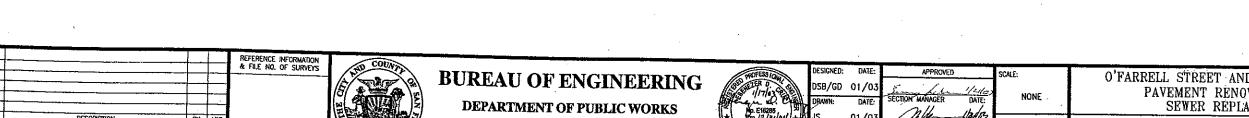

CITY AND COUNTY OF SAN FRANCISCO

SHEET OF SHEETS

O'FARRELL STREET AND GEARY STREET PAVEMENT RENOVATION AND SEWER REPLACEMENT

SPECIFICATION NO. 0022J DRAWING NO. E-6.1

CONDUIT AND WIRING SCHEDULE GEARY ST AND JONES ST INTERSECTION

80,246 REV. NO.