


















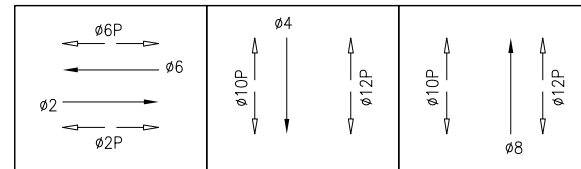
POLE AND EQUIPMENT SCHEDULE											
POLE No.	TYPE OF POLE	FIXTURE TYPE	VEHICLE SIGNAL					PEDESTRIAN SIGNAL			REMARKS
			No.	TYPE	MOUNTING	VISORS	LOUVERS	No.	TYPE	MOUNTING	
①	STEEL STREET LIGHT 6' LUMINAIRES		81	3S12"	SV-1-T	T		128	1S-COUNT	SP-1	APS 
②	1-A (7')							69	1S-COUNT	TP-1	APS 
③	DUAL STEEL STREET LIGHT 6' LUMINAIRES		23 85	3S12"GSA 3S12"	SV-2-TA	T T		120A 120B	1S-COUNT 1S-COUNT	SP-2-T	
④	PEDESTRIAN PUSH BUTTON										APS 
⑤	26-4-100 W/ 45' MAST ARM & 6' LUMINAIRE		21 24 27	3S12" 3S12" 3S12"	SV-1-T MAS MAS	T T T	 BP BP	28	1S-COUNT	SP-1	APS  
⑥	1-A (10')		42	3S12"	TV-1-T	T		129	1S-COUNT	SP-1	APS 
⑦	STEEL STREET LIGHT 6' LUMINAIRE		41	3S12"	SV-1-T	T		108	1S-COUNT	SP-1	APS 
⑧	1-A (7')							29	1S-COUNT	TP-1	APS 
⑨	DUAL STEEL STREET LIGHT 6' LUMINAIRES		45 63	3S12" 3S12"GSA	SV-2-TA	T T		100A 100B	1S-COUNT 1S-COUNT	SP-2-T	
⑩	PEDESTRIAN PUSH BUTTON										APS 
⑪	26-4-100 W/ 45' MAST ARM & 6' LUMINAIRE		61 64 67	3S12" 3S12" 3S12"	SV-1-T MAS MAS	T T T	 BP BP	68	1S-COUNT	SP-1	APS 
⑫	1-A (10')		82	3S12"	TV-1-T	T		109	1S-COUNT	SP-1	APS 

SHEET NOTES:

- A CONTRACTOR TO PROVIDE APS WIRING. CITY FORCES TO PROVIDE APS PUSH BUTTON PER ADA REQUIREMENTS.
- B PRIOR TO INSTALLATION OF POLE, POT HOLE TO VERIFY SIDE SEWER AND OTHER UTILITY CONFLICTS.
- C CONTACT POSTMASTER FOR RELOCATION OF MAILBOX


NOTE;
THIS AUTOCAD DRAWING HAS BEEN REVISED AND REPLOTTED SUBSEQUENT TO INTERNAL ENGINEERING APPROVAL AND SIGN-OFF. FOR THOSE SIGNATURES, SEE THE DRAWING PLOTTED AND ISSUED PREVIOUSLY DURING BIDDING. THE SIGNED DRAWING REMAINS VALID EXCEPT FOR THE CHANGES ONLY AS CLEARLY MARKED ON THIS DRAWING AND ISSUED UNDER THIS LATEST REVISION NUMBER AS SHOWN IN THE TABLE OF REVISIONS LOCATED AT THE LOWER LEFT CORNER OF THE DRAWING. ALL ISSUED REVISIONS SUBSEQUENT TO PREVIOUSLY PLOTTED DRAWING DURING BIDDING REMAIN VALID UNLESS SUPERSEDED BY LATER ISSUED REVISIONS. CHECK ALL ISSUED REVISIONS OF THIS DRAWING.

PHASE DIAGRAM




SWITCHED OVER 1/20/2021
DARK @ 11:50 AM; 3-COLOR @ 2:36 PM
D. MACKOWSKI (MTA)

TABLE OF REVISIONS				REFERENCE INFORMATION & FILE NO. OF SURVEYS				BUREAU OF ENGINEERING CITY & COUNTY OF SAN FRANCISCO SAN FRANCISCO PUBLIC WORKS 30 VAN NESS AVENUE, 5TH FLOOR SAN FRANCISCO, CA 94102 - 6028	Section Mgr: PHILIP THWIN Deputy Bureau Mgr: IQBALBHAI DHAPA Bureau Mgr: PATRICK RIVERA	Date: DESIGNED: 05/2019 DRAWN: 05/2019 CHECKED: 05/2019		SCALE: AS SHOWN SHEET OF SHEETS 215 OF 276	GEARY RAPID WEST OF VAN NESS SURFACE CONTRACT LAGUNA STREET AND GEARY BOULEVARD TRAFFIC SIGNAL PLAN	CONTRACT NO. 1000008388 DRAWING NO. E-14.1 FILE NO. 110,935 REV. NO. 1
1	04/2020	TRAFFIC SIGNAL ADDITION AT COMMONWEALTH & MISC CHANGES	DG	SL										

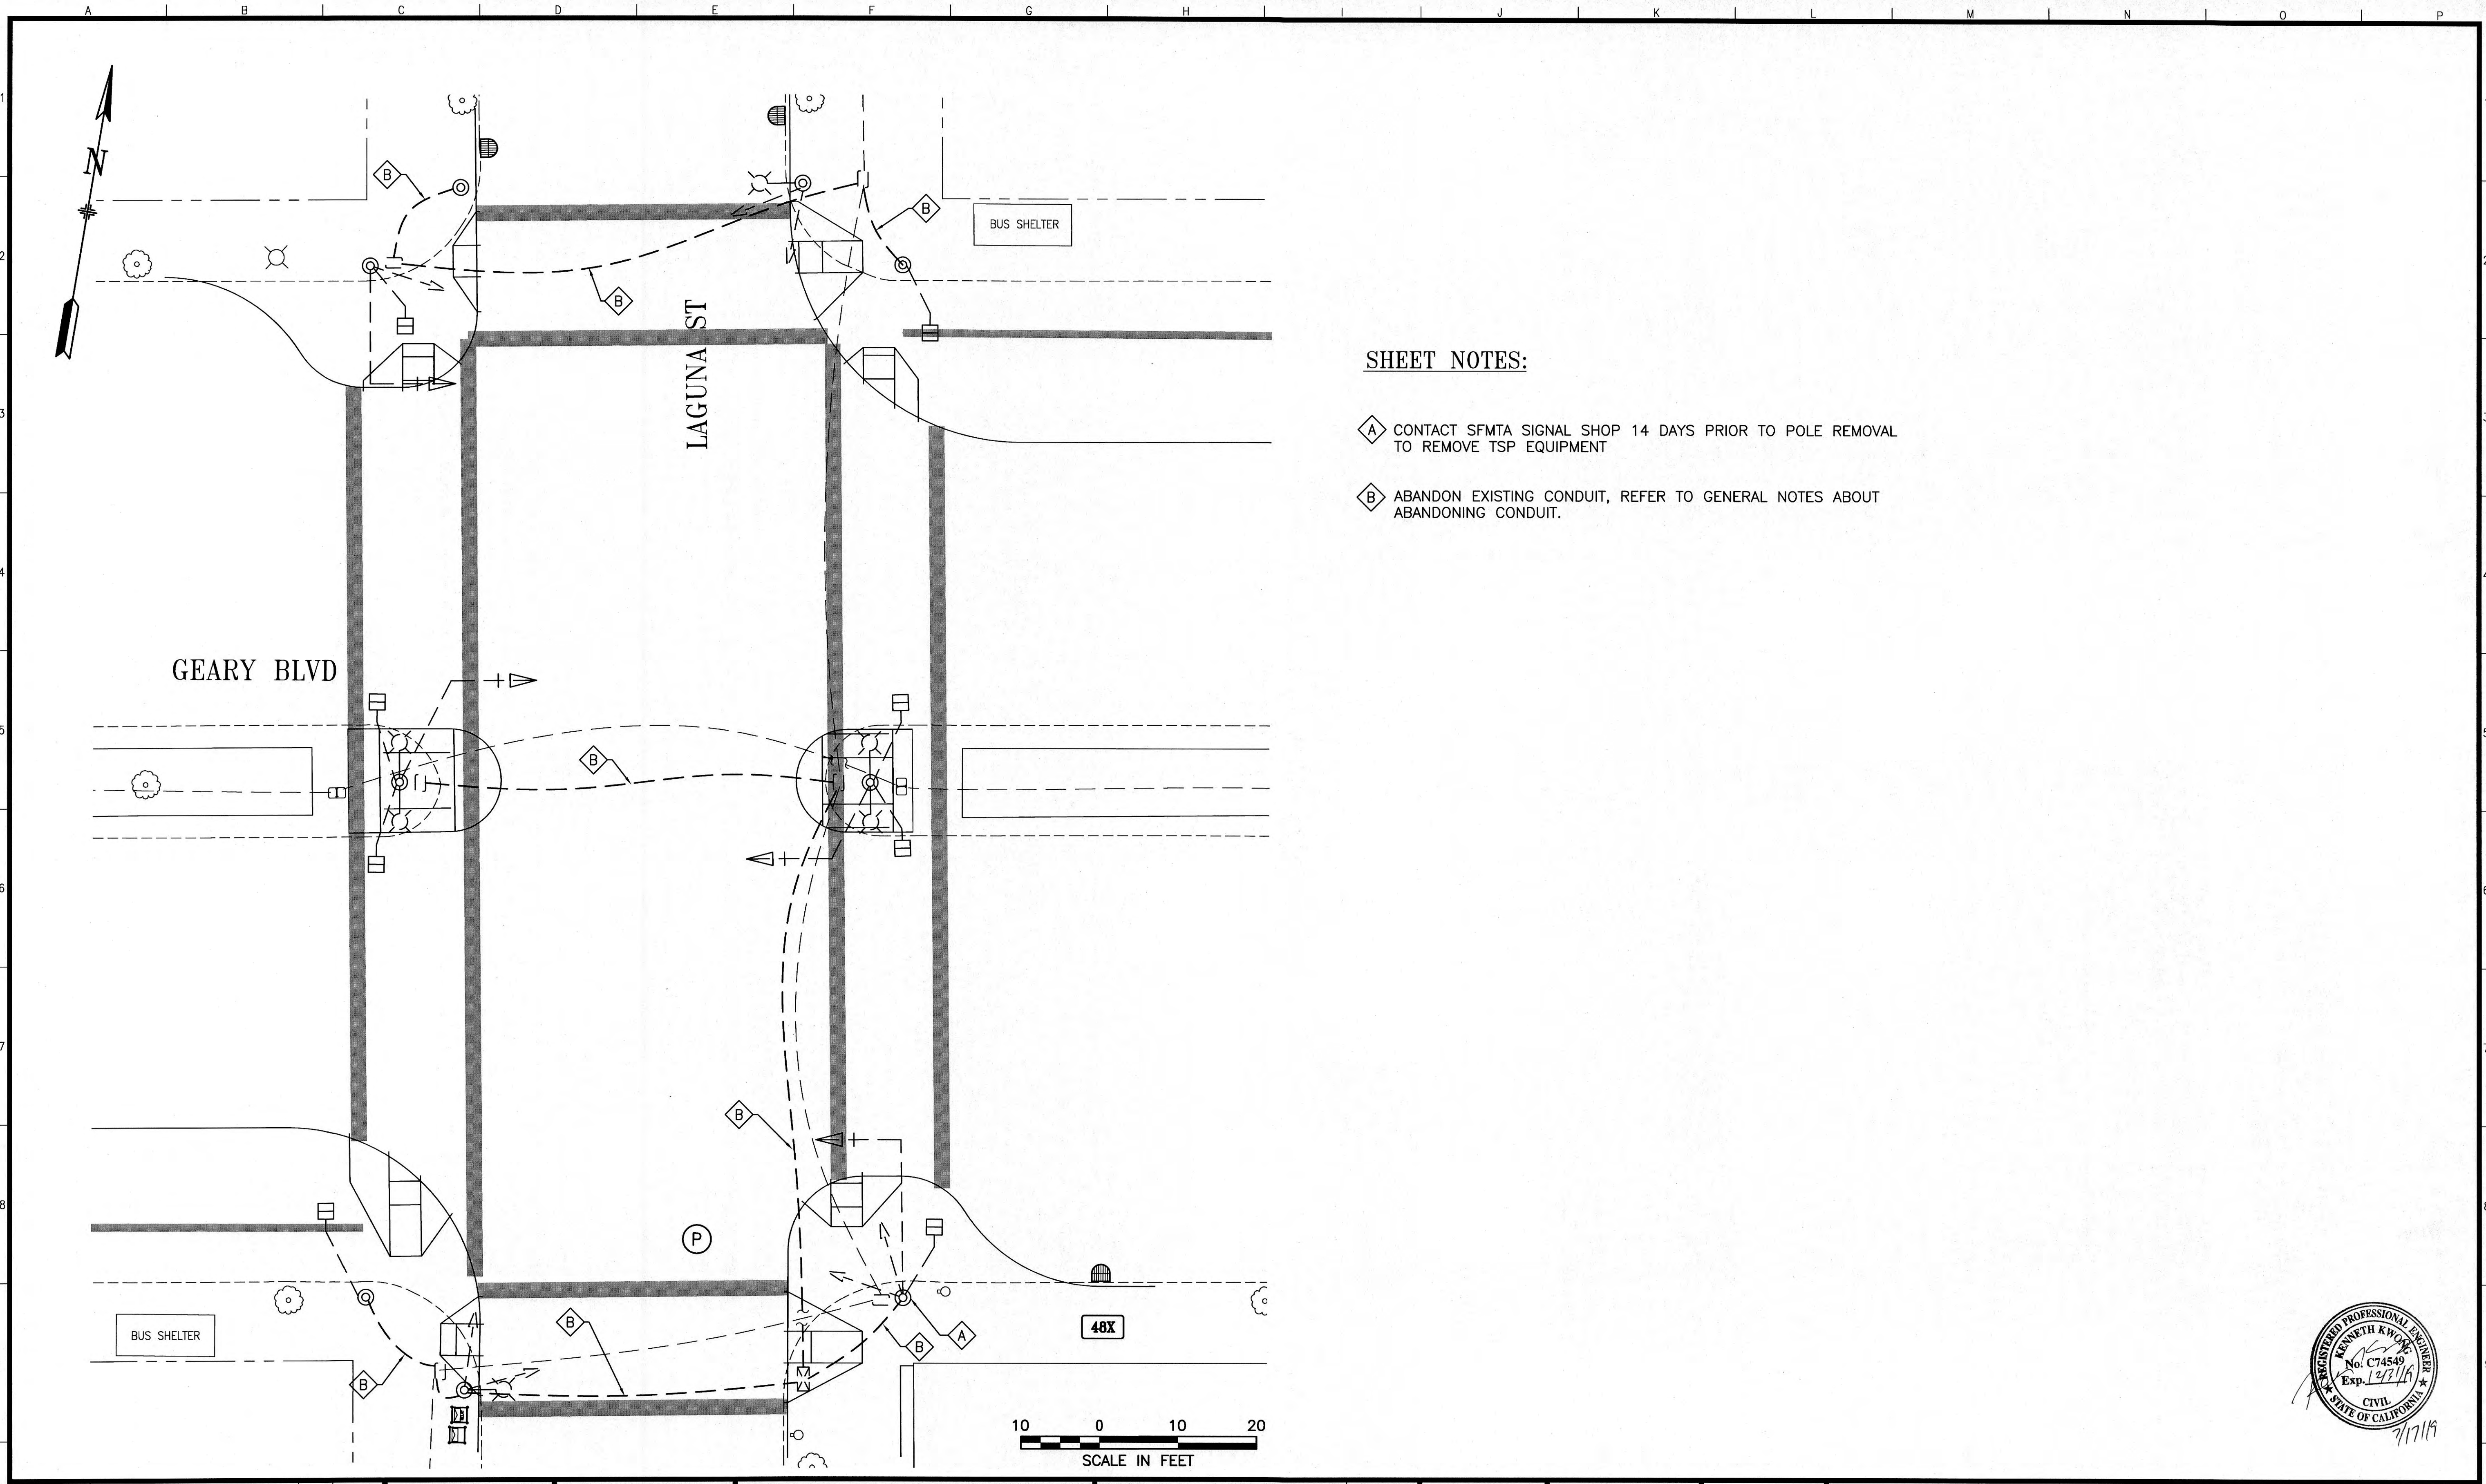

SHEET NOTES:


- A** CONTACT SFMTA SIGNAL SHOP 14 DAYS PRIOR TO POLE REMOVAL TO REMOVE TSP EQUIPMENT
- B** ABANDON EXISTING CONDUIT, REFER TO GENERAL NOTES ABOUT ABANDONING CONDUIT.

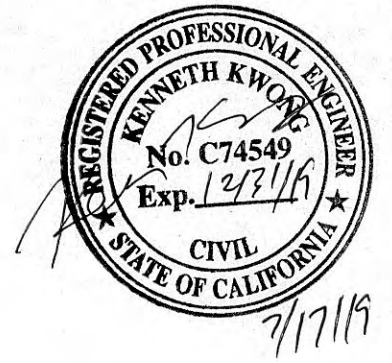

NO.	DATE	DESCRIPTION	BY	APP.

REFERENCE INFORMATION & FILE NO. OF SURVEYS





**BUREAU OF
ENGINEERING**
CITY & COUNTY OF SAN FRANCISCO
SAN FRANCISCO PUBLIC WORKS
30 VAN NESS AVENUE, 5TH FLOOR
SAN FRANCISCO, CA 94102 - 6028

Section Mgr:	PHILIP THWIN	Date:	7/10/19
Deputy Bureau Mgr:	IQBALBHAI DHAPA	Date:	7/22/19
Bureau Mgr:	PATRICK RIVERA	Date:	7/22/19

DESIGNED:	DATE:
DG/DM	05/2019
DRAWN:	DATE:
DG/DM	05/2019
CHECKED:	DATE:
SL/KK	05/2019



SCALE:
AS SHOWN
SHEET OF SHEETS
214 OF 276

GEARY RAPID WEST OF VAN NESS
SURFACE CONTRACT

**LAGUNA STREET AND GEARY BOULEVARD
TRAFFIC SIGNAL DEMOLITION PLAN**

CONTRACT NO.	1000008388
DRAWING NO.	E-14.0
FILE NO.	110,934
REV. NO.	0