


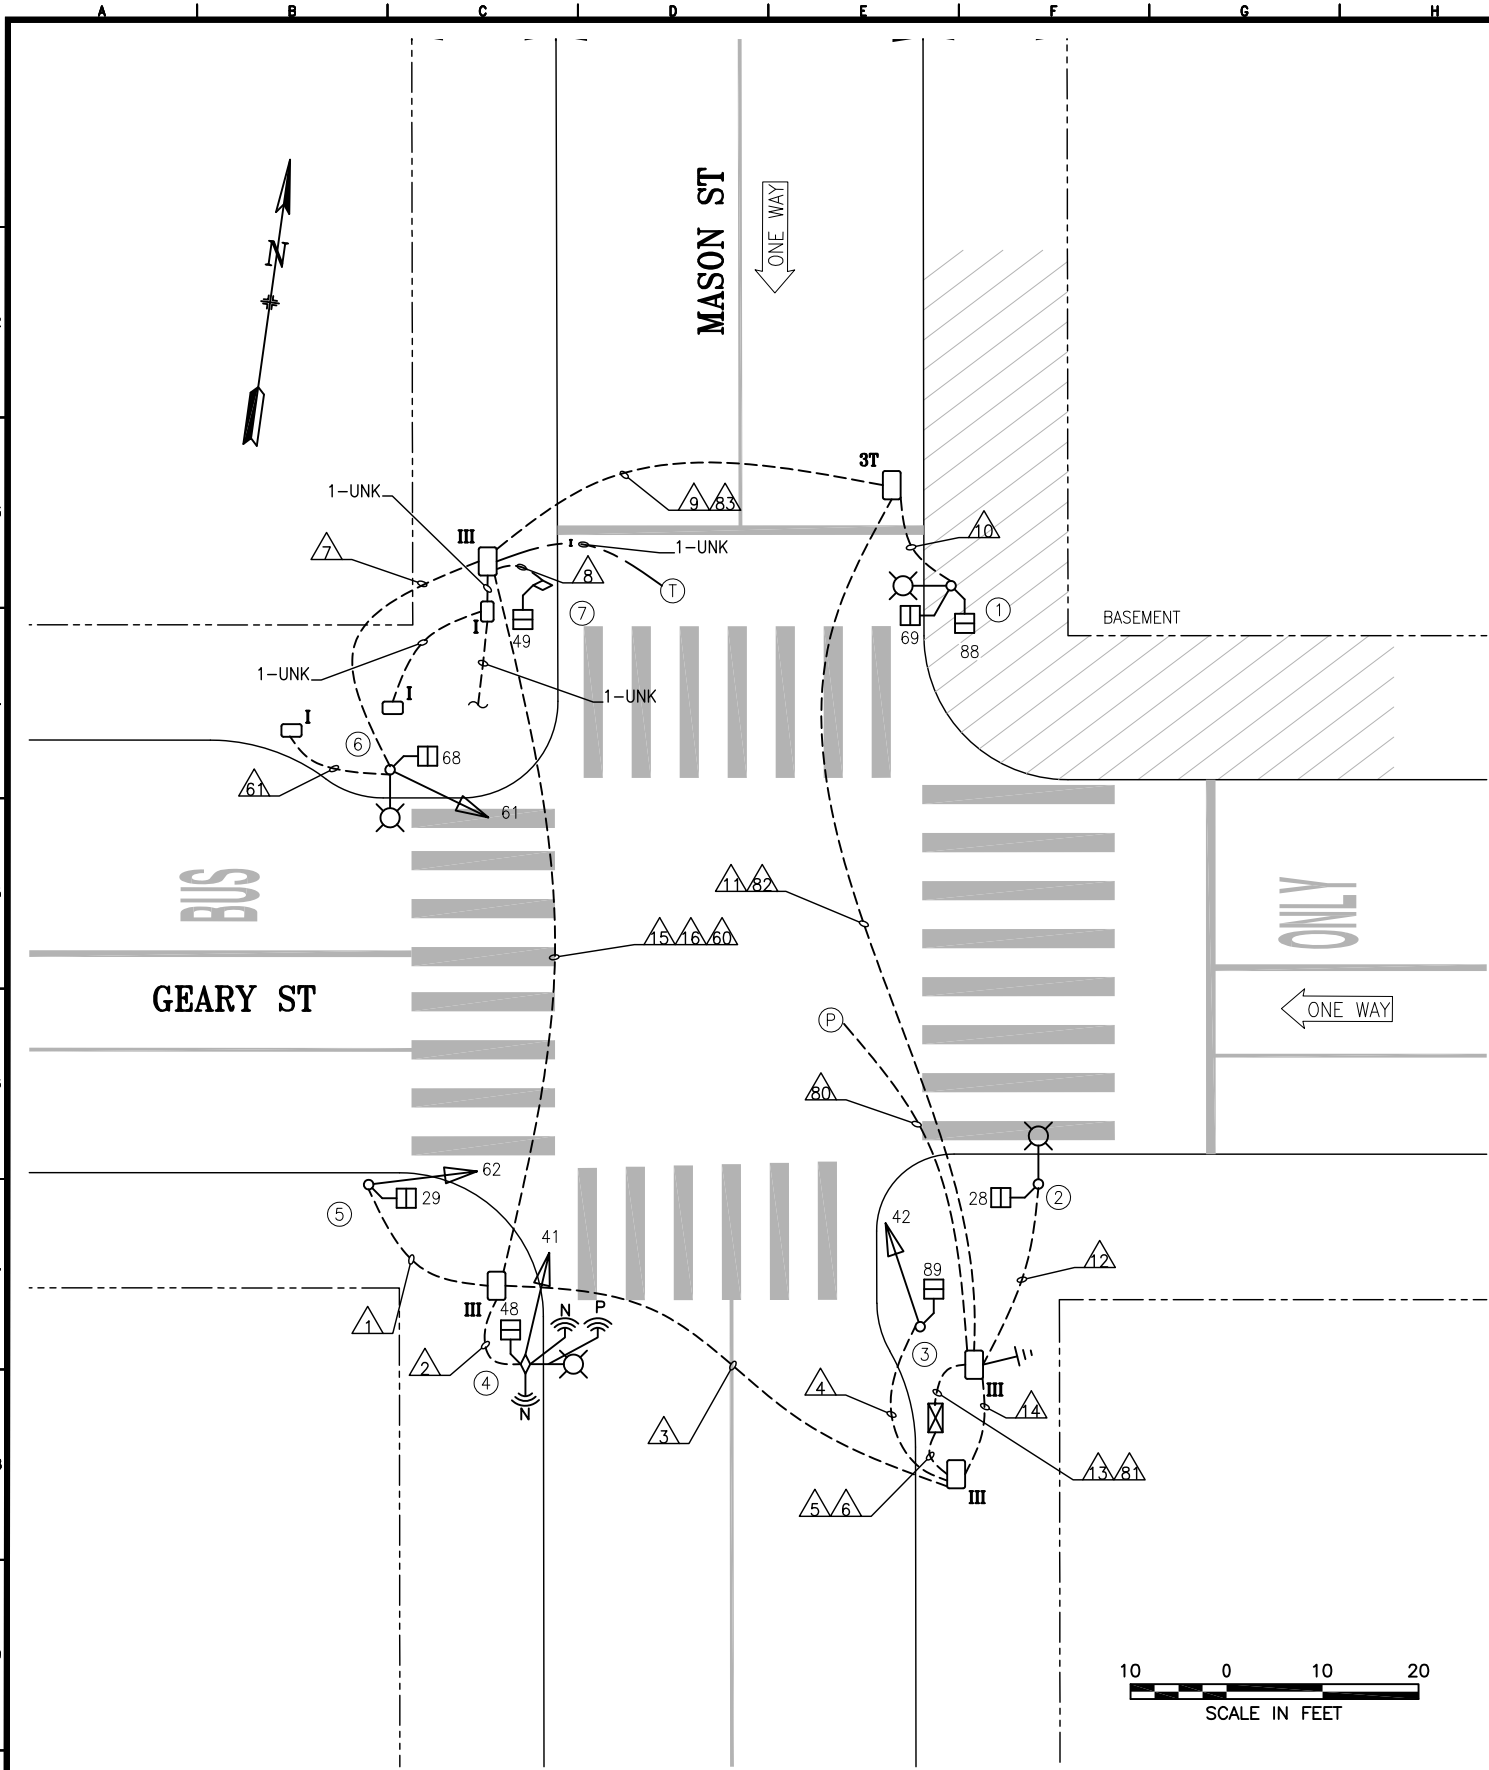

POLE AND EQUIPMENT SCHEDULE										
POLE No.	TYPE OF POLE	VEHICLE SIGNAL					PEDESTRIAN SIGNAL			REMARKS
		No.	TYPE	MOUNTING	VISORS	LOUVERS/BP	No.	TYPE	MOUNTING	
①	CITY STANDARD STREET LIGHT W/ 6' LUMINAIRE ARM						69 88	1S-COUNT 1S-COUNT	SP-1-SF (12") SP-1 (22")	
②	STREET LIGHT W/ 6' LUMINAIRE ARM (PG&E)						28	1S-COUNT	SP-1	
③	1-A (10')	42	3S12"	TV-1-T	T		89	1S-COUNT	SP-1	
④	MUNI STREET LIGHT W/ 6' LUMINAIRE ARM	41	3S12"	SV-1-T	T		48	1S-COUNT	SP-1	NETWORK RADIO X2 PREEMPT RADIO
⑤	1-A (10')	62	3S12"	TV-1-T	T		29	1S-COUNT	SP-1	
⑥	CITY STANDARD STREET LIGHT W/ 6' LUMINAIRE ARM	61	3S12"	SV-1-T	T		68	1S-COUNT	SP-1	
⑦	MUNI POLE						49	1S-COUNT	SP-1	

1	10/19/23	PER SRC 2023-223; UPGRADE 42 TO 12-INCH	D. YEUNG	G. DE LEON
0	5/31/2023	CONVERT FROM 2684J AS-BUILT GEARY RAPID EAST OF VAN NESS. CONDUITS PER 0022J AS-BUILT.	D. YEUNG	G. DE LEON
NO.	DATE	DESCRIPTION	BY	APPROVED
TABLE OF REVISIONS CHECKOUT DRAWING THROUGH THE SID CUSTODIAN FOR THE LATEST REVISION				



SFMTA

DRAWN BY:
D. YEUNG

DATE:
10/2023

CHECKED BY:
G. DE LEON

DATE:
10/2023

SCALE
AS SHOWN
SHEET OF SHEETS
1 OF 2

TRAFFIC SIGNAL INVENTORY DIAGRAM

GEARY STREET & MASON STREET

CNN NO:
24917000
REV NO:
1

