




4	08/16/23	SRC 2023-140: REMO 52; REPL 51 W/ 3S12"LA; CCTV & RADIOS PER FIELD	J. HORNOSTEL	G. DeLEON
3	01/28/21	MOD BY 1000008388, FROM CT PLAN; POLE 4 & SGNL 42 PER FIELD	J. HORNOSTEL	G. DeLEON
2	05/08/18	SIGNAL MOD BY 2370J; CONVERTED FROM CONTRACT PLANS	J. HORNOSTEL	G. DeLEON
1	09/03/15	ADD PPB POLES 2,3,6,9 PER 2124J AS-BUILTS; APS PER SRC 2014-297	J. HORNOSTEL	G. DeLEON
0	05/04/04	SIGNAL MOD ACTIVATED; CONVERTED FROM 2019N CONTRACT PLANS	J. HORNOSTEL	G. DeLEON
NO.	DATE	DESCRIPTION	BY	APPROVED
TABLE OF REVISIONS				
CHECKOUT DRAWING THROUGH THE SID CUSTODIAN FOR THE LATEST REVISION				

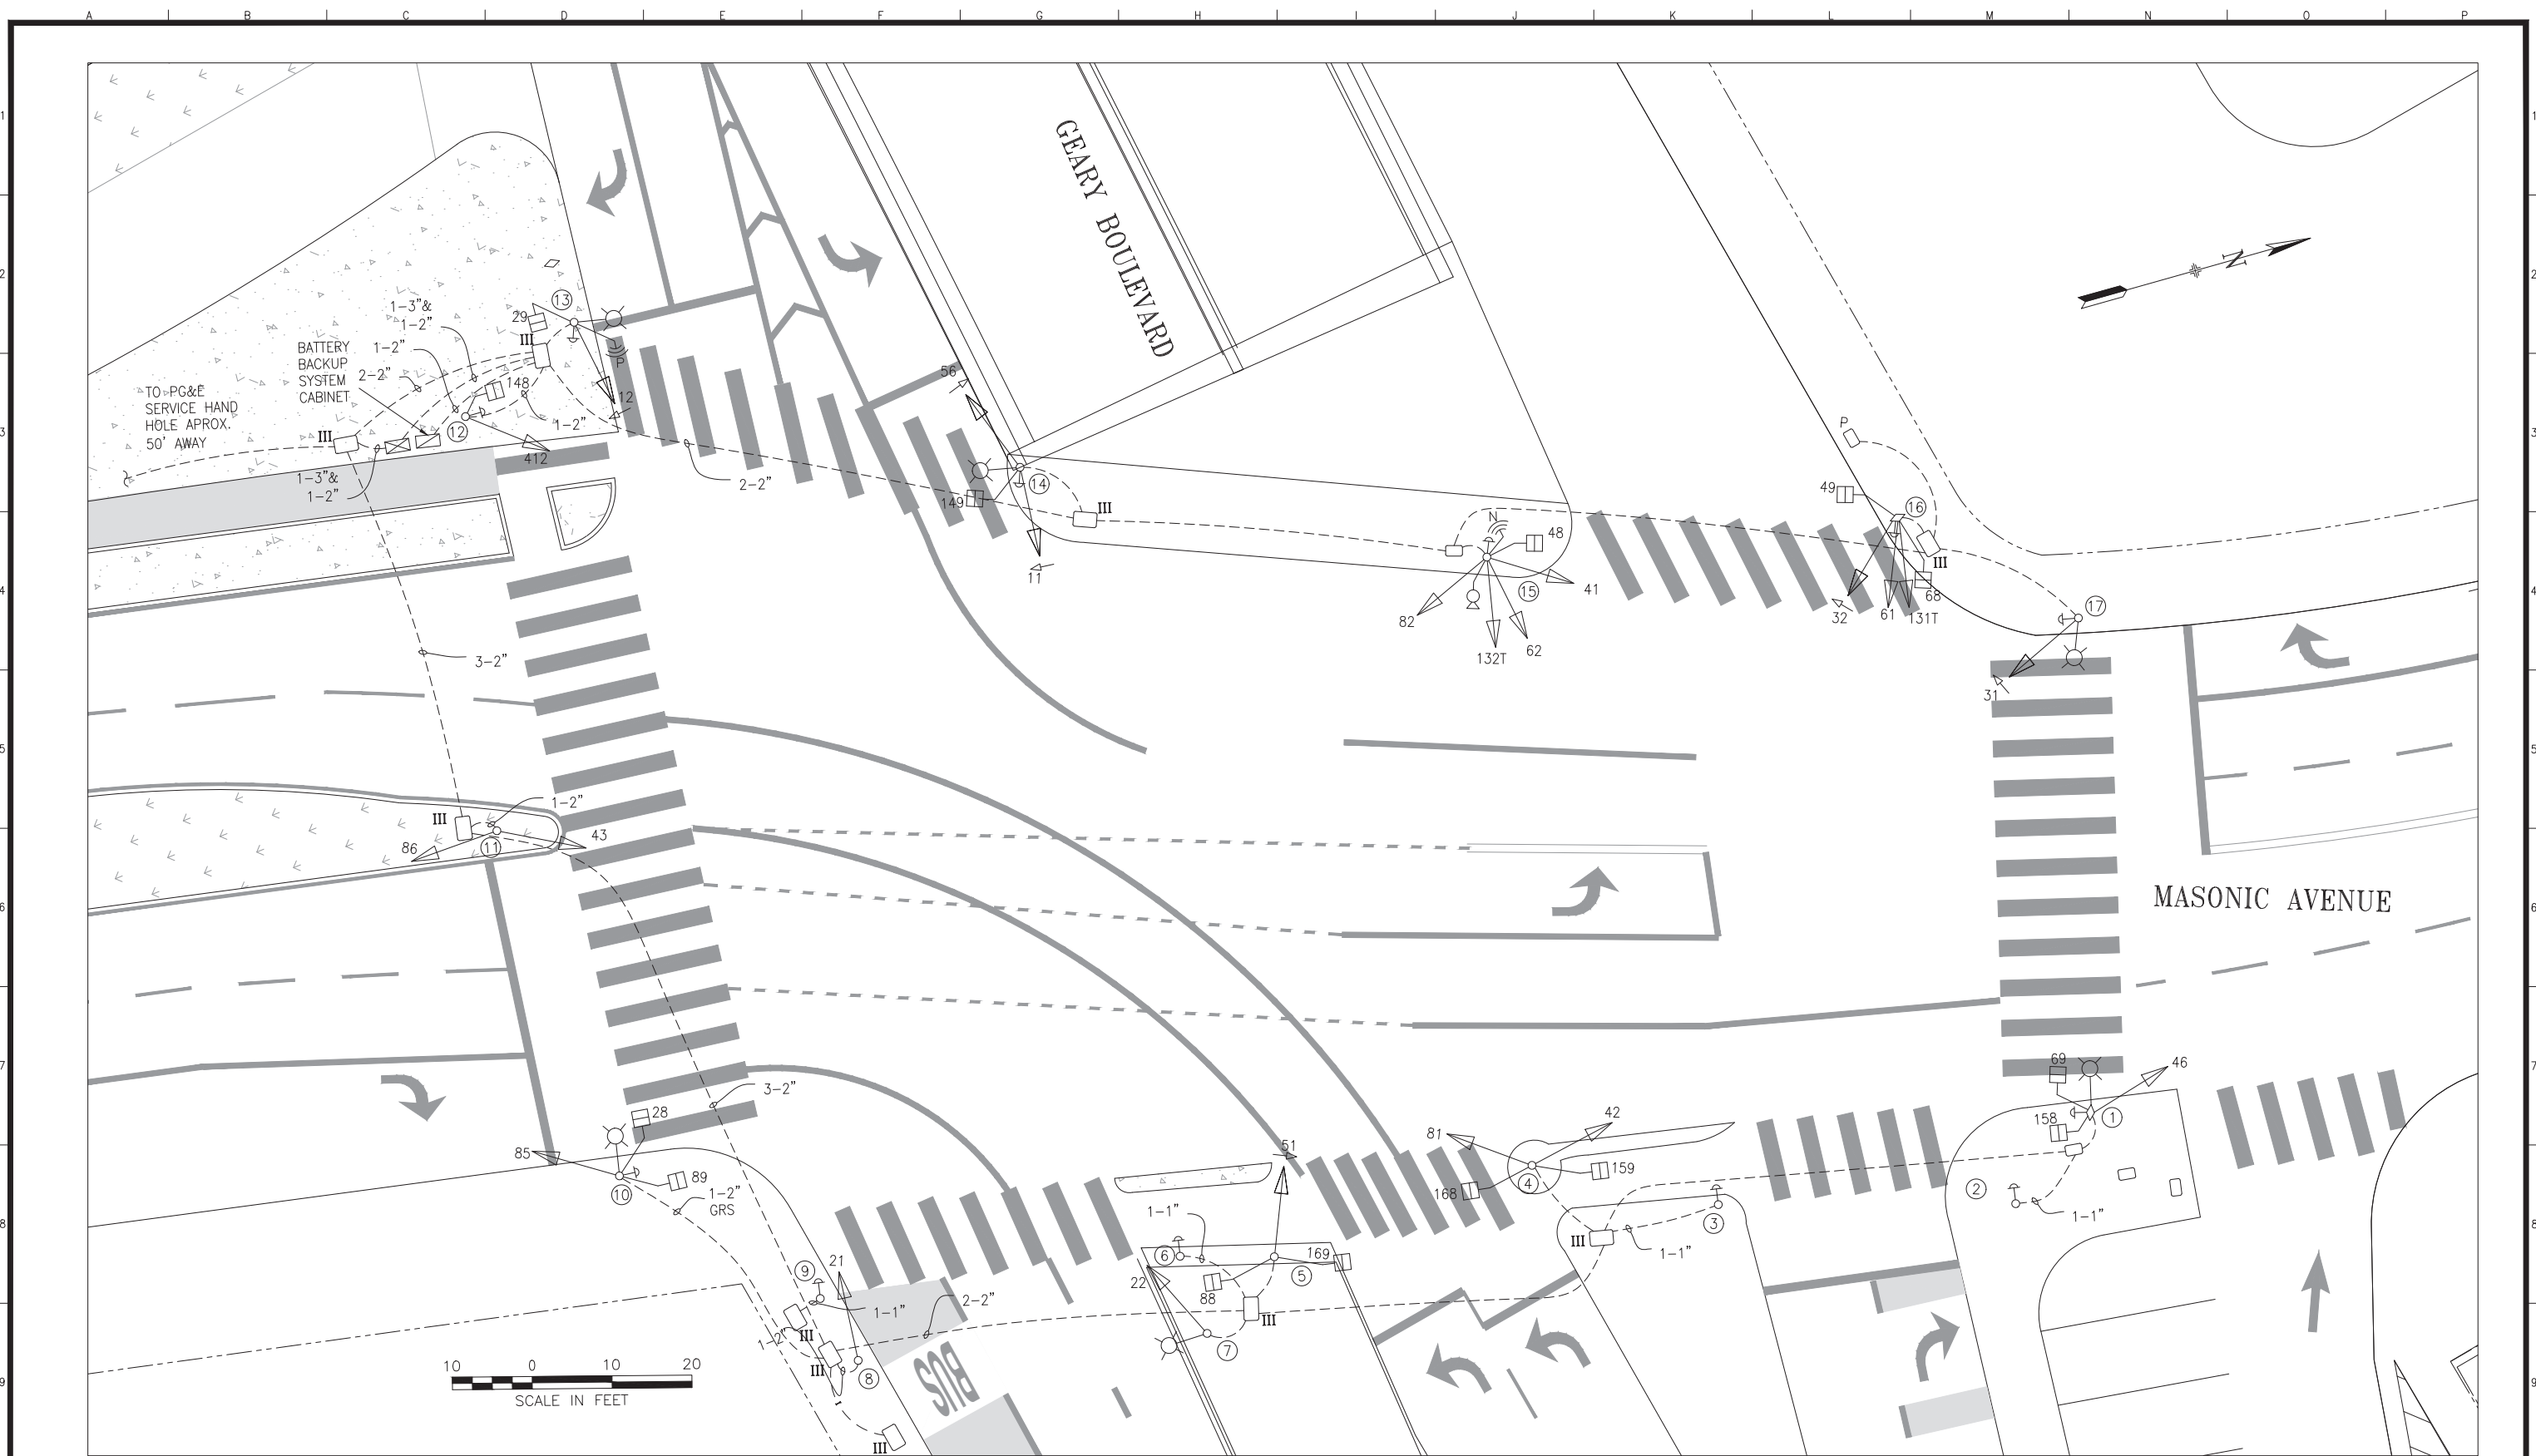

SFMTA

DRAWN BY:
J. HORNOSTEL

DATE:
8/2017

CHECKED BY:
G. DeLEON

DATE:
8/2017

SCALE
AS SHOWN

SHEET OF SHEETS

01 OF 02

TRAFFIC SIGNAL INVENTORY DIAGRAM

GEARY BOULEVARD AND MASONIC AVENUE

CNN NO:

26836000

REV NO:

4

POLE AND EQUIPMENT SCHEDULE											
POLE No.	TYPE OF POLE	LUMINAIRE VOLTAGE/WATTAGE	VEHICLE SIGNAL					PEDESTRIAN SIGNAL			REMARKS
			No.	TYPE	MOUNTING	VISORS	LOUVERS	No.	TYPE	MOUNTING	
①	MUNI POLE STREET LIGHT		46	3S12"	SV-1-T	T		69 158	1S-COUNT 1S-COUNT	SP-2-T	APS
②	PPB POLE										APS
③	PPB POLE										APS
④	1-A (10')		42 81	3S12" 3S12"	SV-2-T-SFA	T T		159 168	1S-COUNT 1S-COUNT	SP-2-T	
⑤	1-A (10')		51	3S12"	TV-1-T	C		169 88	1S-COUNT 1S-COUNT	SP-2-T	
⑥	PPB POLE										APS
⑦	MARBLELITE STREET LIGHT		22	3S12"	SV-1-T	T					
⑧	1-A (10')		21	3S12"	TV-1-T	T					
⑨	PPB POLE										APS
⑩	CITY STANDARD STREET LIGHT		85	3S12"	SV-1-T	T		28 89	1S-COUNT 1S-COUNT	SP-2-T	APS
⑪	1-A (15')		43 86	3S12" 3S12"	SV-2-TA	T T					
⑫	1-A (10')		412	3S12"	TV-1-T	T		148	1S-COUNT	SP-1	APS
⑬	CITY STANDARD STREET LIGHT		12	3S12"LA	SV-1-T	T		29	1S-COUNT	SP-1	PREEMPT RADIO APS
⑭	MARBLELITE STREET LIGHT		11 56	3S12"LA 3S12"LA	SV-1-T SV-1	T T		159	1S-COUNT	SP-1	SIGNAL 56 MOUNTED AT 4'6" APS
⑮	MARBLELITE STREET LIGHT		41 62 82 132T	3S12" 3S12" 3S12" 2S12"-	SV-3-TA SV-1-T	T T T		48	1S-COUNT	SP-1	SIGNAL 132T @15' CCTV CAMERA NETWORK RADIO APS
⑯	MUNI POLE STREETLIGHT		32 61 131T	PV4S12"GLA 3S12" 2S12"-	SV-2-TA SV-1-T	C T T		49 68	1S-COUNT 1S-COUNT	SP-2-T	SIGNAL 131T MOUNTED AT 15' APS
⑰	CITY STANDARD STREET LIGHT		31	PV4S12"GLA	SV-1-T	C					APS