




1	10/26/17	UPDATE SIGNALS TO 12" PER SRC 2017-081	HYU	M.VELASCO	
0	4/27/04	NEW SID CONVERTED FROM 2019N AS-BUILTS	HYU	M.VELASCO	
NO.	DATE	DESCRIPTION	BY	APP.	
TABLE OF REVISIONS					
CHECK WITH TRACING TO SEE IF YOU HAVE LATEST REVISION					

REFERENCE INFORMATION & FILE NO. OF SURVEYS

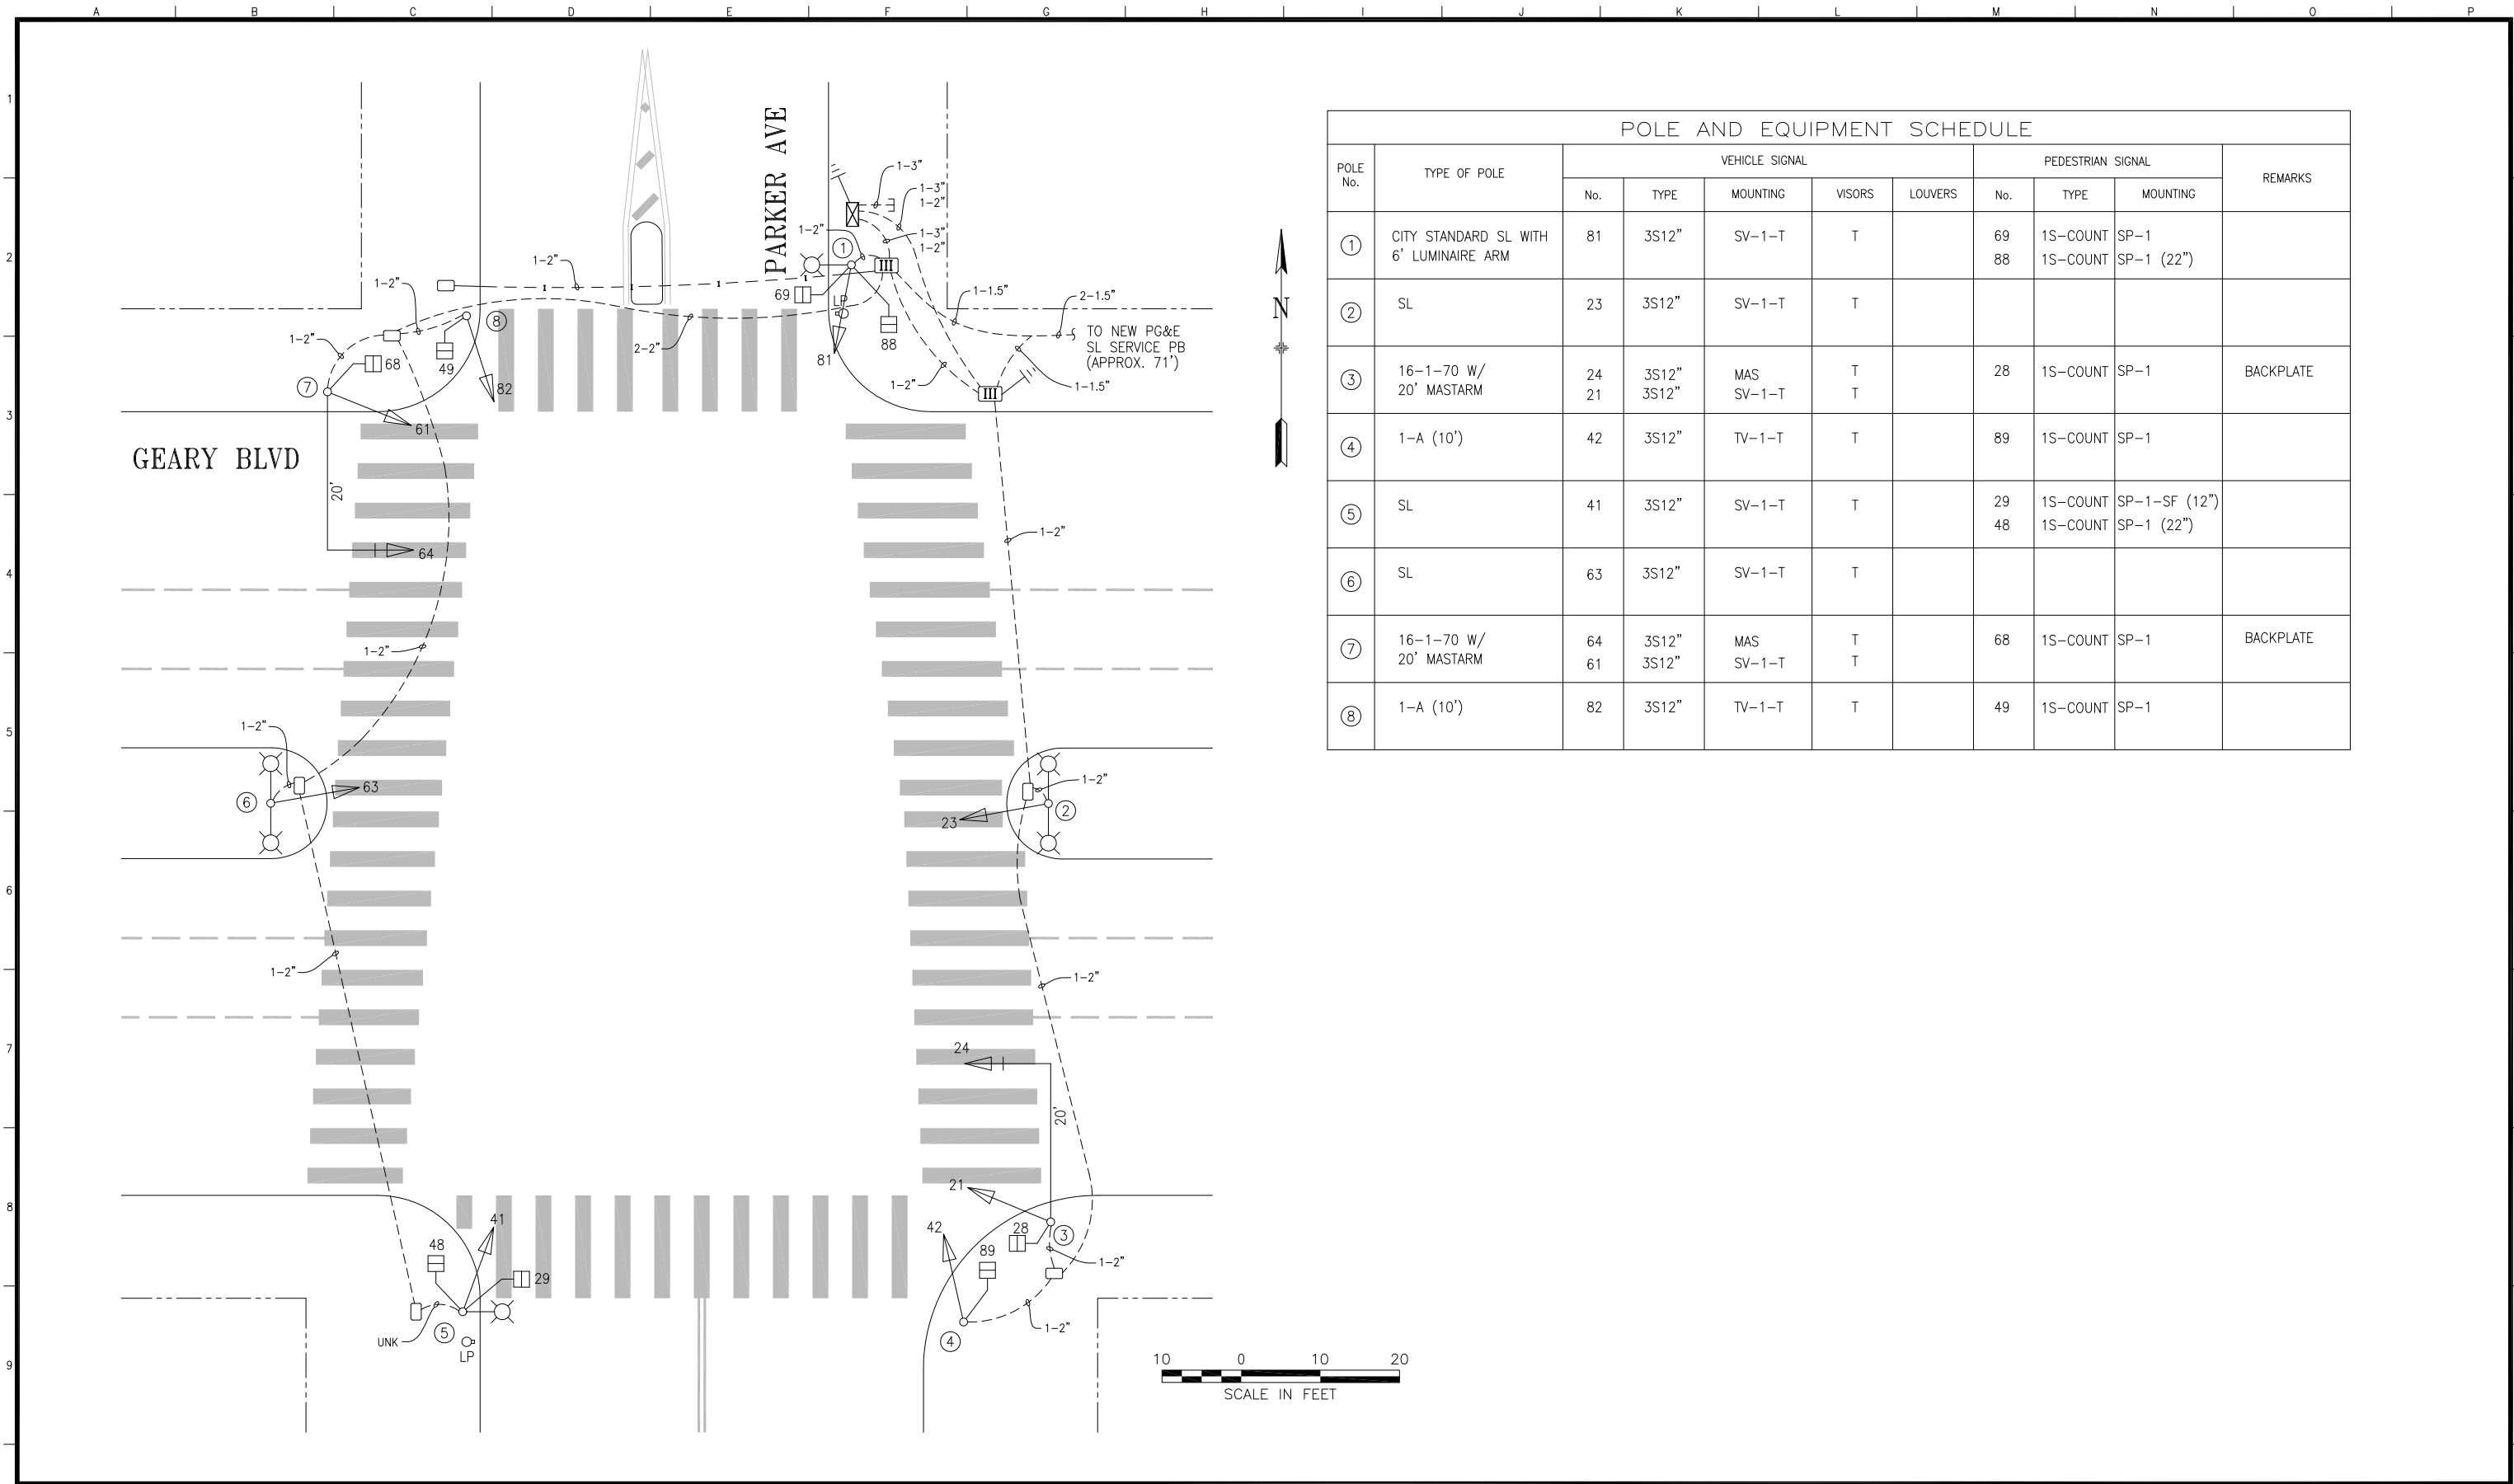

SAN FRANCISCO MUNICIPAL TRANSPORTATION AGENCY

CITY AND COUNTY OF SAN FRANCISCO

DRAWN:	DATE:
H.YU	3/2017
CHECKED:	DATE:
M.VELASCO	3/2017

SCALE:
AS SHOWN
SHEET OF SHEETS
1 OF 1

TRAFFIC SIGNAL INVENTORY DIAGRAM
GEARY BOULEVARD AND PARKER AVENUE

CNN NO.
26930000
REV NO.
1